

Map No. Kansas Sec. 29 Twp. 26 R. 8Well No. 1 Freeman Butler Farm
John Rogers Company

NORTH


_____ Ft. from N. Line

250 Ft. from S. Line

_____ Ft. from E. Line

250 Ft. from W. Line

WEST

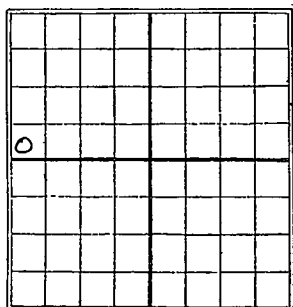

SOUTH

C

Date

REPORT

1925

5/1 Sky 8005/29 ✓ 17806/5 Top Gas 2665-82Oil 2982-84 1497 GasEst + spraying about5 Bbls Oil per day6/18 Top Gas sd 2651-59 1/2 mGas Oil 2694-272570 gts 100 Bbls Oil100 Bbls Water

Map No. 15 N 1/4 Bk 29 Sec. 29 Twp. 26 R. 8

Well No. 1 Mumm-Bitter

John Rogers Company

Contractor

SECTION PLAT

_____ Ft. from N. Line

750 Ft. from S. Line

_____ Ft. from E. Line

750 Ft. from W. Line

0			

FIRST REPORTS

Location _____

Rig up _____

Drilling and Remarks:

Drly 800'

RECORD

Cased _____ in., _____ ft.

Sand _____

Gas _____

Oil _____

Total Depth _____

PRODUCTION

1st 24 hrs. Nat. _____

1st 24 hrs. after shot _____

Gas _____ Cu. Ft.

Dry Hole _____

Abandoned _____

Date

MAY 1 1925

192

CHAS. L. SHERWOOD

Scout

Map No. 15 Sec. 29 Twp. 26 R. 8Well No. William. Ritter

John Rogers Company

Contractor

COMPLETED

SECTION PLAT

Ft. from N. Line

250 Ft. from S. Line

Ft. from E. Line

250 Ft. from W. Line

0			

Location -----

Rig up -----

Drilling and Remarks:

2651-69'
1/2 in gas.
oil 2669-2694'
Water 2694-2725'
70' 2669-94'
100 b/s oil

Date 100 b/s Water

RECORD

Cased ----- in., ----- ft.

Sand -----

Gas -----

Oil -----

Total Depth 2725'

PRODUCTION

1st 24 hrs. Nat. -----

1st 24 hrs. after shot -----

Gas ----- Cu. Ft.

Dry Hole -----

Abandoned -----

JUN 18 1925 CHAS. L. SHERWOOD