


Butler Co
 Map No. Kansas Sec. 29 Twp. 26 R. 8
 Well No. 7 Drum Butter Farm
Federal Oil Company

NORTH

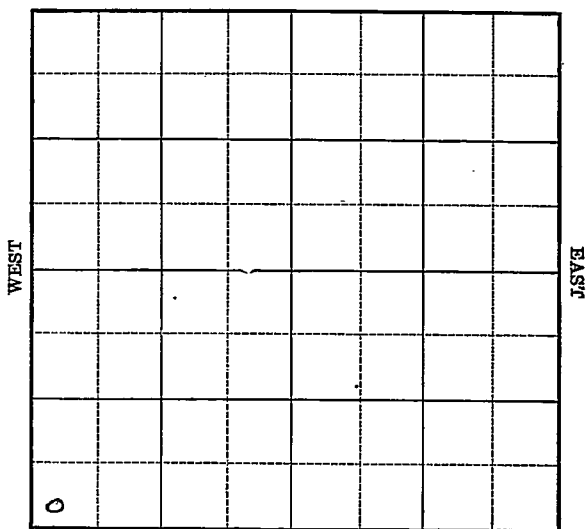

SOUTH

Location _____

Drilling Remarks _____

Rig Up _____

Drilling Remarks _____

RECORD

Cased _____ in. _____ ft.

Sand _____

Gas _____

Oil _____

Total Depth _____

PRODUCTION

1st 24 hrs. Nat. _____

1st 24 hrs. after shot _____

Gas _____ cu. ft.

Dry Hole _____

Abandoned _____

Butler Co

Map No. Kansas Sec. 29 Twp. 26 R. 8Well No. 7 Drumm Butler FarmFederal Oil Company

NORTH

_____ Ft. from N. Line

200 Ft. from S. Line

_____ Ft. from E. Line

200 Ft. from W. Line

WEST

EAST

SOUTH

REPORT

Date

192510/2911/27TimbersAbandoned Location

Bother Co
 K15 **KANSAS** Sec. *29* Twp. *26* R. *8*
 Map No. Well No. *7 Mumm Bitter*
Federal Oil Co Company

Contractor

FIRST REPORTS

SECTION PLAT

Ft. from N. Line


200

Ft. from S. Line

Ft. from E. Line

200

Ft. from W. Line

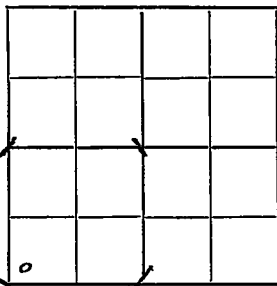Location *Leahers*

Rig up

Drilling and Remarks:

RECORD

Cased _____ in., _____ ft.

Sand _____

Gas _____

Oil _____

Total Depth _____

PRODUCTION

1st 24 hrs. Nat. _____

1st 24 hrs. after shot _____

Gas _____ Cu. Ft.

Dry Hole _____

Abandoned _____

Date

OCT 29 1925

192

CHAS. L. SHERWOOD

Scout

Butter Co

R15 Map No. **KANSAS** Sec. *29* Twp. *26* R. *8*

Well No. *7* *Drum Butter*

Federal oil Co Company

Contractor

COMPLETED

SECTION PLAT

_____ Ft. from N. Line

200 _____ Ft. from S. Line

_____ Ft. from E. Line

200 _____ Ft. from W. Line

ABANDONED

Location _____

Rig up _____

Drilling and Remarks:

No location

RECORD

Cased _____ in., _____ ft.

Sand _____

Gas _____

Oil _____

Total Depth _____

PRODUCTION

1st 24 hrs. Nat. _____

1st 24 hrs. after shot _____

Gas _____ Cu. Ft.

Dry Hole _____

Abandoned *Location*

Date

NOV 27 1925

CHAS. L. SHERWOOD

192 Scout