


KANSAS
 Map No. _____ Sec. 30 Twp. 26 R. ✓
 Well No. 1 Quinn Bitter Farm
Cow Runners Oil Company

NORTH

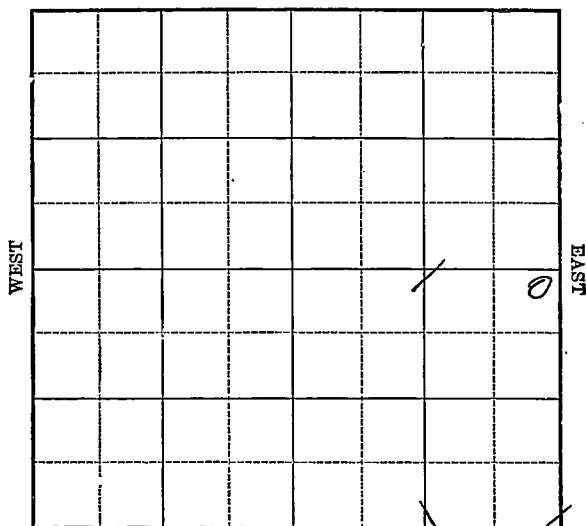

SOUTH

Location _____

Drilling Remarks _____

RECORD

Cased _____ in. _____ ft.

Sand _____

Gas _____

Oil _____

Total Depth _____

Rig Up _____

Drilling Remarks _____

PRODUCTION

1st 24 hrs. Nat. _____

1st. 24 hrs. after shot _____

Gas _____ cu. ft.

Dry Hole _____

Abandoned _____

Butler

Map No. *30* Sec. *26* Twp. *8*Well No. *1 Hum-Bitter* Farm*Law Puncture Co* Company

NORTH

200 Ft. from N. Line

Ft. from S. Line

200 Ft. from E. Line

Ft. from W. Line

WEST

EAST

SOUTH

1925

Date

REPORT

8/14 *Timbers*8/20 *Tap Gas and 2660 T.D. 2717*
*show oil & lots water*8/20 *Rig.*8/27 *—*9/3 *—*9/11 *spud.*9/16 *Perf @ 740'*9/24 *✓ ✓ 1140'*10/1 *✓ ✓ 1255*10/8 *—*10/16 *—*10/22 *—*10/29 *—*11/6 *—*11/13 *2140*12/3 *Land 2660-2715**140 gals 60 Bbls oil**300 Bbls Water*

Bother. Co

Map No. 5 KANSAS Sec. 30 Twp. 26 R. 8
 Well No. 1 Mum. Bitter
Cow punchers oil Co Company

Contractor

FIRST REPORTS


SECTION PLAT

200 Ft. from N. Line

Ft. from S. Line

200 Ft. from E. Line

Ft. from W. Line

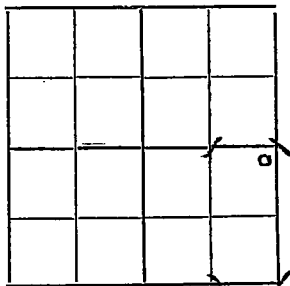

Location _____

Rig up Leathers

Drilling and Remarks:

RECORD

Cased _____ in., _____ ft.

Sand _____

Gas _____

Oil _____

Total Depth _____

PRODUCTION

1st 24 hrs. Nat. _____

1st 24 hrs. after shot _____

Gas _____ Cu. Ft.

Dry Hole _____

Abandoned _____

Date

AUG 14 1925

192

CHAS. L. SHERWOOD

Scout

Map No. KANSAS 1530 Sec. 20 Twp. 26 R. 8
 Well No. 1 Stump Bottom
Cowditch & Co Company

Contractor

COMPLETED


SECTION PLAT

200 Ft. from N. Line

_____ Ft. from S. Line

200 Ft. from E. Line

_____ Ft. from W. Line

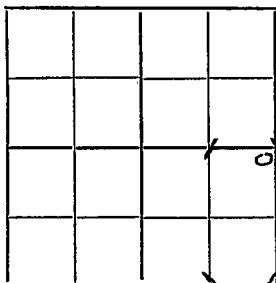

Location _____

Rig up _____

Drilling and Remarks:

1st oil 2672'

1st 60 bhs oil
 200 bhs water

RECORD

Cased _____ in., _____ ft.

Sand 2660-2715

Gas _____

Oil _____

Total Depth 2715'

PRODUCTION

1st 24 hrs. Nat. _____

1st 24 hrs. after shot _____

Gas _____ Cu. Ft.

Dry Hole _____

Abandoned _____

Date

DEC 3 1925

192

CHAS. L. SHERWOOD

Scout