

Map No. KANSAS Sec. 31 Twp. 26 R. 8Well No. 12 - Drum - Butler FarmJohn Rogers Company

NORTH

WEST

EAST

SOUTH

Location

Drilling Remarks

Rig Up

Drilling Remarks

RECORD

Cased in. ft.

Sand

Gas

Oil

Total Depth

PRODUCTION

1st 24 hrs. Nat.

1st 24 hrs. after shot

Gas cu. ft.

Dry Hole

Abandoned


Map No. **KANSAS** Sec. 31 Twp. 26 R. 8
 Well No. 12 - Drumm-Bitler Farm
John Rogers Company

250 Ft. from N. Line

_____ Ft. from S. Line

1320 Ft. from E. Line

_____ Ft. from W. Line

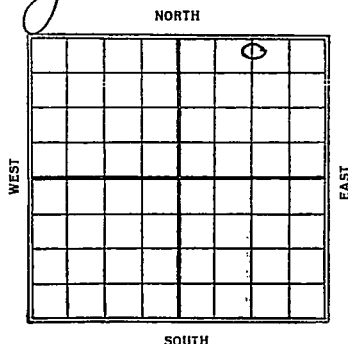

1928

Date

REPORT

2/15	Spudding
2/23	Drly 300-
3/1	" 900
3/8	Fishing 1336
3/16	—
3/22	—
3/29	—
4/5	—
4/12	Drly 1625
4/19	" 2050
4/26	" 2525
5/3	Land 2686 - 2736 - T.D. 2738 Shot 100 qts. Swab 25 bbls in 5 hrs -
5/10	2686 - 2736 - T.D. 2738 100/25 bbls oil lots of water

15 KANSAS 31 Butter
 Map No. Sec. Twp. 26 R. 8
 Well No. 12 Munn. Butler
 John Rogers
 Company
 Contractor

FIRST REPORTS

250 Ft. from N. Line
 Ft. from S. Line
 1320 Ft. from E. Line
 Ft. from W. Line

SECTION PLAT

			0

Location

Rig up

Drilling and Remarks:

Spdg

RECORD

Cased _____ in., _____ ft.

Sand _____

Gas _____

Oil _____

Total Depth _____

PRODUCTION

1st 24 hrs. Nat. _____

1st 24 hrs. after shot _____

Gas _____ Cu. Ft.

Dry Hole _____

Abandoned _____

Date

FEB 15 1928

CHAS. L. SHERWOOD

192

Scout

15 KANSAS

MAP NO. _____ SEC. 31 TWP. 26 R. 8WELL NO. 12Drum. BitterJohn Rogers COMPANY

CONTRACTOR

COMPLETED

SECTION PLAT

			0

750 FT. FROM N. LINE

_____ FT. FROM S. LINE

1370 FT. FROM E. LINE

_____ FT. FROM W. LINE

LOCATION _____

RIG UP _____

DRILLING AND REMARKS:

100 yds Bls Oil
lots of water.

RECORD

CASED _____ IN. _____ FT.

SAND 7686-7736

GAS _____

OIL _____

TOTAL DEPTH 7738

PRODUCTION

1ST 24 HRS. NAT. _____

1ST 24 HRS. AFTER SHOT _____

GAS _____ CU. FT.

DRY HOLE _____

ABANDONED _____

DATE
MAY 10 1928

CHAS. L. SHERWOOD

192

SCOUT