


Map No. _____ Sec. 4 Twp. 26 R. 5Well No. 6 - Robbins Farm _____Boster Company _____

NORTH

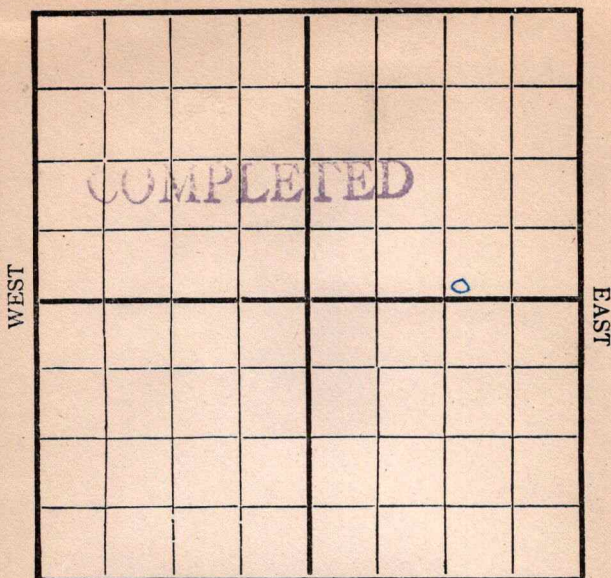

SOUTH

Location ✓ ✓Rig Up 12-4-16

Drilling Remarks:

12/11 = 12/18 = 12/28
100 = 1/11
800 = 1/8/17
1600 = 1/15

Drilling Remarks:

RECORD

Cased _____ in _____ Ft.

Sand _____

Gas _____

Oil _____

Total Depth _____

PRODUCTION

1st 24 hrs. Nat. _____

1st 24 hrs. after shot _____

Gas _____ Cu. Ft.

Dry Hole _____

Abandoned _____

Map No. _____ Sec. 4 Twp. 26 R. 5
 Well No. 6 Dobkins Farm _____
Foster Company _____

NORTH

WEST

EAST

SOUTH

Location ✓
 Rig Up _____
 Drilling and remarks _____

RECORD

Cased _____ in. _____ Ft.
 Sand _____
 Gas _____
 Oil _____
 Total Depth _____

PRODUCTION

1st 24 hrs. Nat. _____
 1st 24 hrs. after shot _____
 Gas _____ Cu. Ft.
 Dry Hole _____
 Abandoned _____

Date


12/4, 1916, Doobins Scout

Map No. _____ Sec. 4 Twp. 26 R. 5Well No. 6206 Farm _____

Company _____

NORTH

WEST

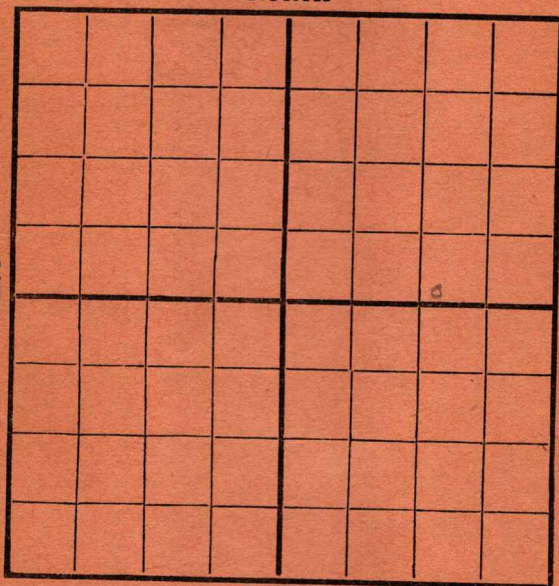

EAST

SOUTH

Location _____

Rig Up _____

Drilling and remarks _____

RECORD

Cased _____ in. _____ Ft.

Sand _____

Gas _____

Oil _____

Total Depth _____

PRODUCTION

1st 24 hrs. Nat. _____

1st 24 hrs. after shot _____

Gas _____ Cu. Ft.

Dry Hole _____


Abandoned _____

Date

12/11, 1916, Cordell Scout

Map No. _____ Sec. 4 Twp. 26 R 5
 Well No. 6 Dobbin Farm _____
Yocum Company _____

NORTH

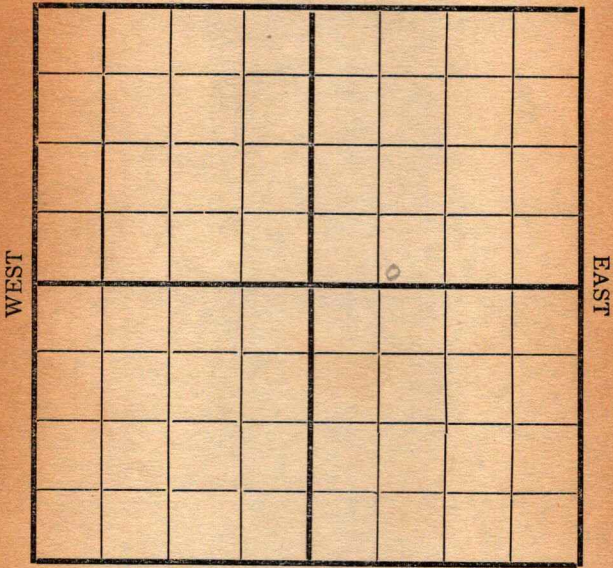

SOUTH

Location _____
 Rig Up ☒ _____
 Drilling and remarks _____

RECORD

Cased _____ in. _____ Ft.
 Sand _____
 Gas _____
 Oil _____
 Total Depth _____

PRODUCTION


1st 24 hrs. Nat. _____
 1st 24 hrs. after shot _____
 Gas _____ Cu. Ft.
 Dry Hole _____
 Abandoned _____

Date 12/18, 1916 Cordys Scout _____

Map No. _____ Sec. 4 Twp. 26 R. 5

Well No. 6 Dobbins Farm _____

Foster oil Company _____

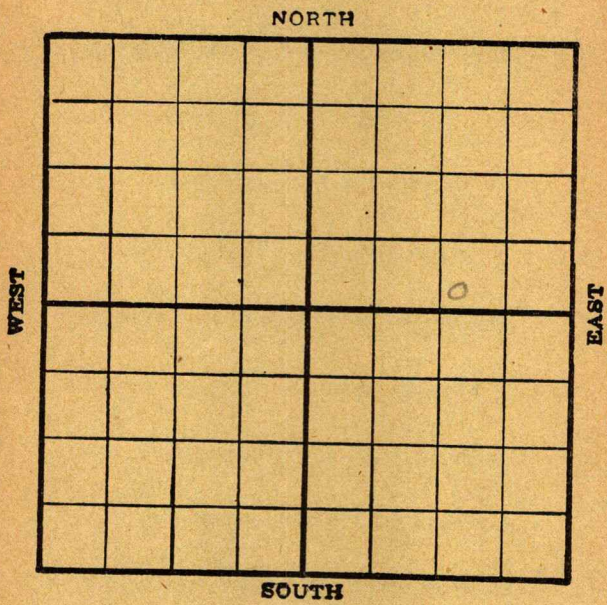

Location _____

Rig up _____

Drilling and remarks _____

Rigging up

RECORD

Cased _____ in. _____ Ft.

Sand _____

Gas _____

Oil _____

Total Depth _____

PRODUCTION

1st. 24 hrs. Nat. _____

1st 24 hrs. after shot _____

Gas _____ Cu. Ft.

Dry Hole _____

Abandoned _____


Date _____

12/28, 1916, Cordell Scout

Map No. _____ Sec. 4 Twp. 26 R. 5
 Well No. 6200 Farm _____
Foster Company _____

NORTH

WEST

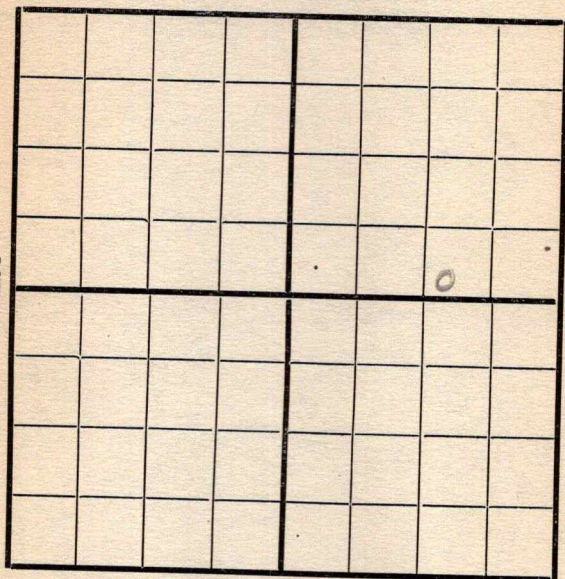

EAST

SOUTH

Location _____
 Rig Up _____
 Drilling and remarks _____

100

RECORD

Cased _____ in. _____ Ft.
 Sand _____
 Gas _____
 Oil _____
 Total Depth _____

PRODUCTION

1st 24 hrs. Nat. _____
 1st 24 hrs. after shot _____
 Gas _____ Cu. Ft.
 Dry Hole _____
 Abandoned _____


Date

1/1, 1917 Cardiff Scout

Map No. _____ Sec. 4 Twp. 26 R. 5
 Well No. 6 Dabbin Farm _____
Foster Company _____

NORTH

WEST

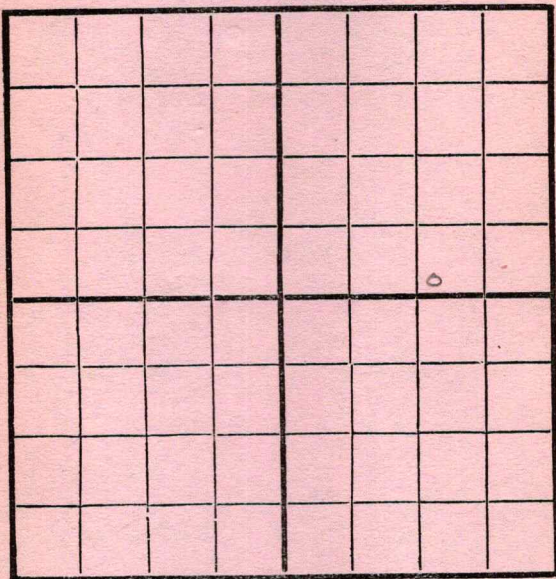

EAST

SOUTH

Location _____
 Rig Up _____
 Drilling and remarks

800'

RECORD

Cased _____ in. _____ Ft.
 Sand _____
 Gas _____
 Oil _____
 Total Depth _____

PRODUCTION


1st 24 hrs. Nat. _____
 First 24 hrs. after shot _____
 Gas _____ Cu. Ft.
 Dry Hole _____
 Abandoned _____

Date

1/8, 1917 Cordell Scout _____

Map No. _____ Sec. 4 Twp. 26 R. 5
 Well No. 6 Drilling Farm _____
Foster Company _____

NORTH

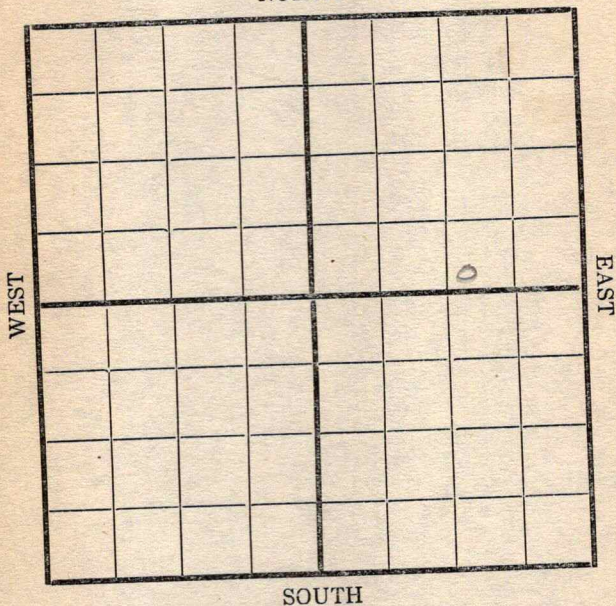

SOUTH

Location _____
 Rig Up _____
 Drilling and remarks _____

1600

RECORD

Cased _____ in. _____ Ft.
 Sand _____
 Gas _____
 Oil _____
 Total Depth _____

PRODUCTION

1st 24 hrs. Nat. _____
 1st 24 hrs. after shot _____
 Gas _____ Cu. Ft.
 Dry Hole _____
 Abandoned _____


Date

1/15, 1917

C. J. [Signature] Scout

Map No. _____ Sec. 4 Twp. 26 R. 5
Well No. 6200bbins Farm _____
Foster Company _____

NORTH

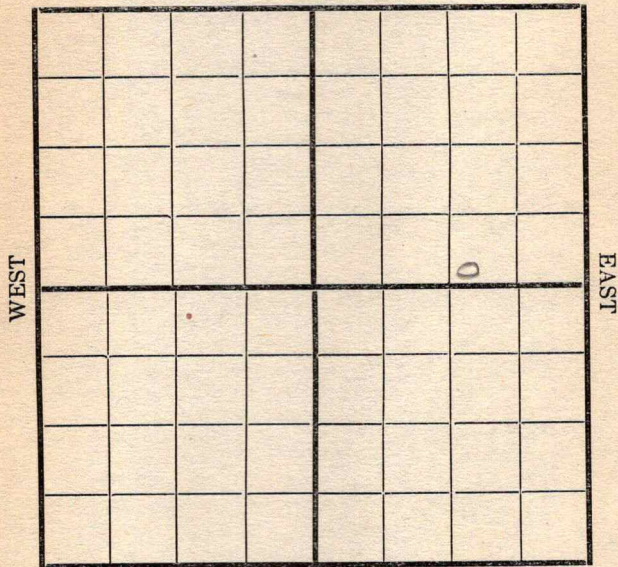


SOUTH

	RECORD
Location _____	Cased _____ in. _____ Ft.
Rig Up _____	Sand _____
Drilling and remarks <u>1825</u>	Gas _____
	Oil _____
	Total Depth _____
	PRODUCTION
	1st 24 hrs. Nat. _____
	1st 24 hrs. after shot _____
	Gas _____ Cu. Ft.
	Dry Hole _____
	Abandoned _____

Date 1/22, 1917 Condy Scout _____

Map No. _____ Sec. 4 Twp. 26 R. 5
Well No. 6 Dobbin Farm _____
Foster Oil Company _____

NORTH

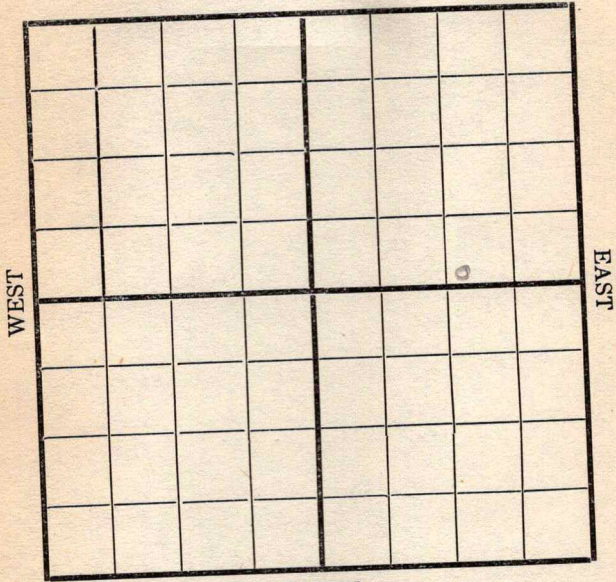

SOUTH

Location _____ Rig Up _____ Drilling and remarks <u>2390'</u>	RECORD
	Cased _____ in. _____ Ft.
	Sand _____
	Gas _____
	Oil _____
	Total Depth _____
	PRODUCTION
	1st 24 hrs. Nat. _____
	1st 24 hrs. after shot _____
	Gas _____ Cu. Ft.
	Dry Hole _____
	Abandoned _____


Date 1/29, 1917 Cordell Scout

Map No. _____ Sec. 4 Twp. 26 R. 5
 Well No. 6 Dobbin Farm _____
Foster Company _____

NORTH

WEST

EAST

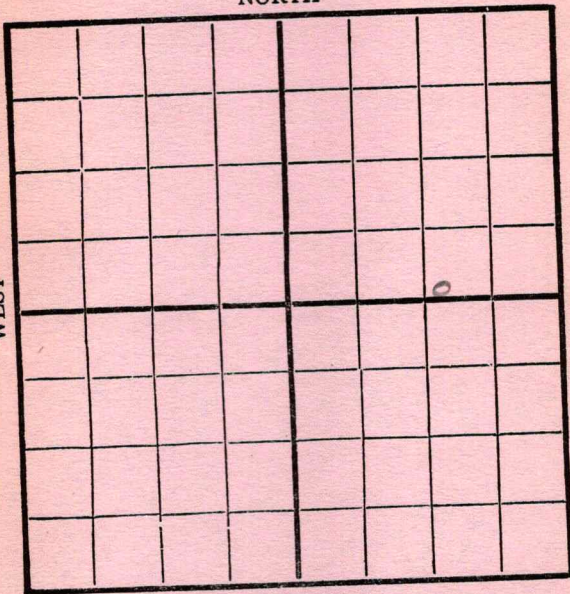

SOUTH

RECORD

Location _____

Cased _____ in. _____ Ft.

Rig Up _____

Sand _____

Drilling and remarks

Gas _____

Oil _____

Total Depth _____

PRODUCTION

1st 24 hrs. Nat. _____

First 24 hrs. after shot _____

Gas _____ Cu. Ft.

Dry Hole _____

Abandoned _____


Shut Down
 2390'

Date

2/5, 1917 Cord Scout _____

Map No. _____ Sec. 4 Twp. 26 R. 5
Well No. 620 B B Hiss Farm _____
Foster Company _____

NORTH

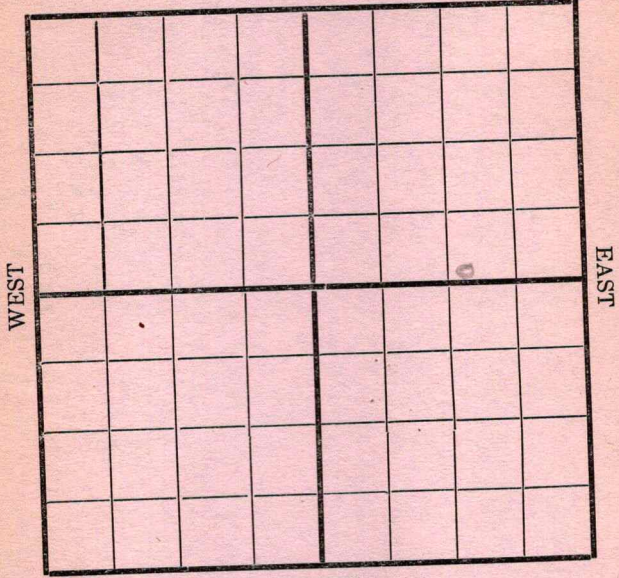

SOUTH

Location _____
Rig Up _____
Drilling and remarks
2420'

RECORD

Cased _____ in. _____ Ft.
Sand _____
Gas _____
Oil _____
Total Depth _____

PRODUCTION

1st 24 hrs. Nat. _____
1st 24 hrs. after shot _____
Gas _____ Cu. Ft.
Dry Hole _____
Abandoned _____

Date 2/12, 1912 Carly Scout _____

Map No. _____ Sec. 4 Twp. 26 R. 5
 Well No. 6 Dobbin Farm _____
Locher Company _____

NORTH

WEST

EAST

SOUTH

Location _____
 Rig Up _____
 Drilling and remarks _____

2420'

RECORD

Cased _____ in. _____ Ft.
 Sand _____
 Gas _____
 Oil _____
 Total Depth _____

PRODUCTION

1st 24 hrs. Nat. _____
 1st 24 hrs. after shot _____
 Gas _____ Cu. Ft.
 Dry Hole _____
 Abandoned _____


Date

Aug, 1917 2 Barb Scout

Map No. E14 Sec. 4 Twp. 26 R. 5
 Well No. 6 Dobbin Farm
Foster Company

NORTH

WEST

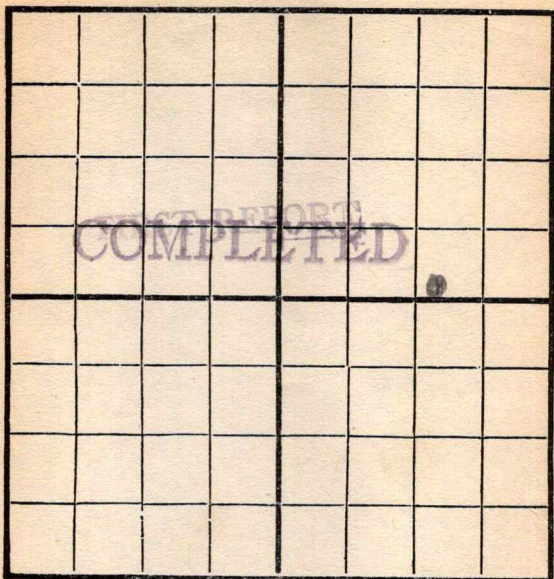

EAST

SOUTH

Location _____
 Rig Up _____
 Drilling and remarks _____

Est at
150 Bbl

RECORD

Cased _____ in. _____ Ft.
 Sand 2634-2649
 Gas _____
 Oil _____
 Total Depth _____

PRODUCTION

1st 24 hrs. Nat. _____
 First 24 hrs. after shot _____
 Gas _____ Cu. Ft.
 Dry Hole _____
 Abandoned _____

Date

Feb 7 1917 Cordell Scout