


Map No. 15 Sec. 4 Twp. 26 R. 9
Well No. 1-Bowman Farm
Fred Conant Company

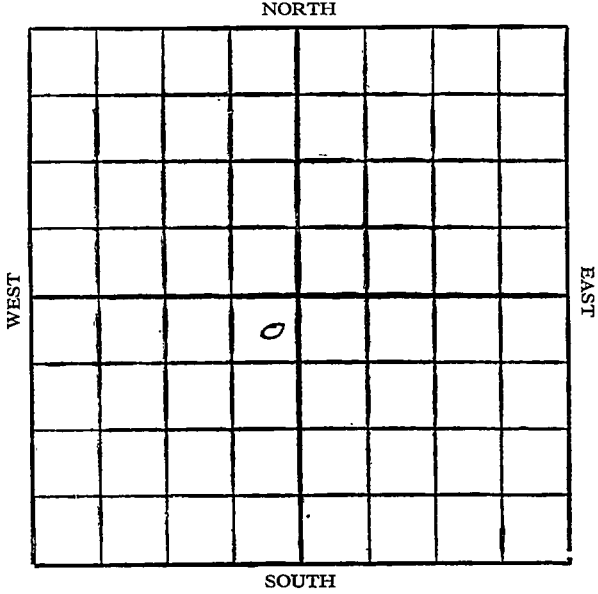

Location

Drilling Remarks

.....

.....

RECORD

Cased.....in.ft.

Sand

Gas

Oil

Total Depth.....

Rig Up.....

Drilling Remarks

.....

.....

PRODUCTION

1st 24 hrs. Nat.....

1st 24 hrs. after shot.....

Gas.....cu. ft.

Dry Hole.....


Abandoned

Map No. Kansas Sec. 4 Twp. 26 R. 9Well No. 1 Bowman FarmFred Conant Company330 Ft. from N. Line

_____ Ft. from S. Line

320 Ft. from E. Line

_____ Ft. from W. Line

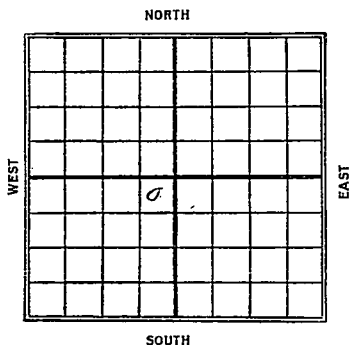

Date REPORT

1927	
1/12	Location
1/19	same
1/26	—
2/3	—
2/10	—
2/17	—
2/24	—
3/2	—
3/9	—
3/16	—
3/24	—
3/30	—
4/7	—
4/13	—
4/20	—
4/27	—
5/5	Abandoned Location

H. L. Sherwood

15 KANSAS


Map No. _____ Sec. 4 Twp. 26 R. 9

Well No. 1 Bowman Farm

H. L. Conant

Company

. NORTH

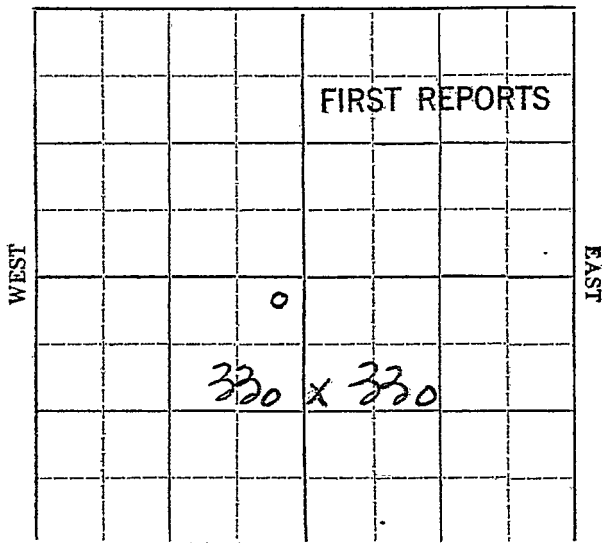

. SOUTH

Location ☒

Rig up _____

Drilling and Remarks: _____

RECORD

Cased _____ in., _____ ft.

Sand _____

Gas _____

Oil _____

Total Depth _____

PRODUCTION

1st 24 hrs. Nat. _____

1st 24 hrs. after shot. _____

Gas _____ Cu. Ft.

Dry Hole _____

Abandoned _____

Date
JAN 12 1927

CHAS. L. SHERWOOD

192

Scout

Followed
15 KANSAS
 Map No. _____ Sec. 4 Twp. 26 R. 9
 Well No. 1 Brown
265 Content Company _____

Contractor _____

COMPLETED

SECTION PLAT

330 Ft. from N. Line

_____ Ft. from S. Line

330 Ft. from E. Line

_____ Ft. from W. Line

ABANDONED

	○		

Location _____

Rig up _____

Drilling and Remarks:

RECORD

Cased _____ in., _____ ft.

Sand _____

Gas _____

Oil _____

Total Depth _____

PRODUCTION

1st 24 hrs. Nat. _____

1st 24 hrs. after shot _____

Gas _____ Cu. Ft.

Dry Hole _____

Abandoned Location

Date

MAY 5 1927

CHAS. L. SHERWOOD

Scout