
Greenwood

FORM 51

Section 6 Township 26 Range KANSAS 9E

Well No. #1 Henson

Company Aiken & Owen

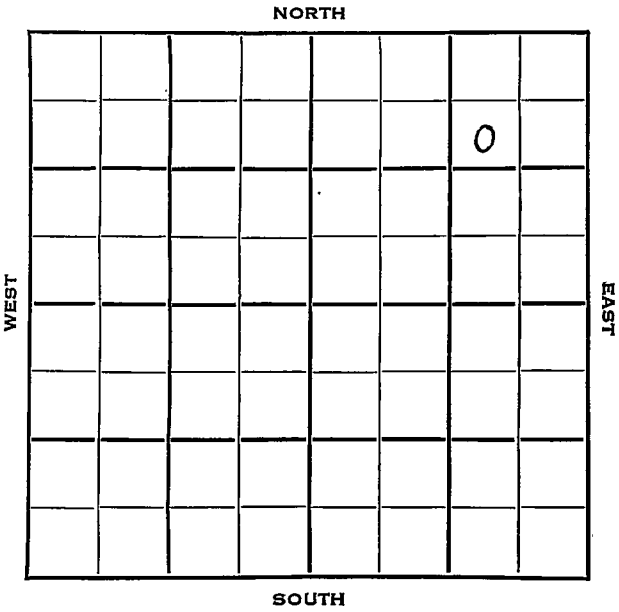

Greenwood KANSAS

SEC.	TWP.	R.
6	26	9E

WELL NO.

#1 Henson FARM

COMPANY

Akin & Owen

CONTRACTOR

Morrison


Wildcat.

990 Ft. from N. Line

Ft. from S. Line

990 Ft. from E. Line

Ft. from W. Line

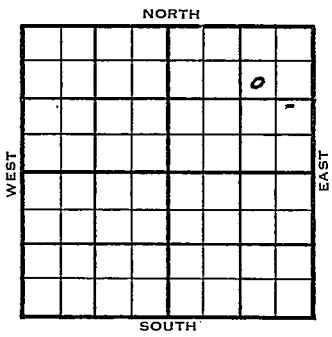

SW NE NE

	ELEVATION — REPORT
1953	
9/30	M I R
10/21	Spud 9-28-53 D & A TD 2375' 8" @ 119' Lans 1390', KC 1730, Bart 2295 TD 2375' 4" @ 2375' 41/ 2296-2309' sd-frac D & A

ABANDONED

DX-78

FORM 275 FOR SALE BY KANSAS BLUE PRINT CO.


County Greenwood State Kansas

Sec. 6 (Blk. Twp.) 26 (Sur. Rge.) 9E Map No.

Operator Akin & Owen

Well No. 1 Farm Henson

Elev. Location SW NE NE

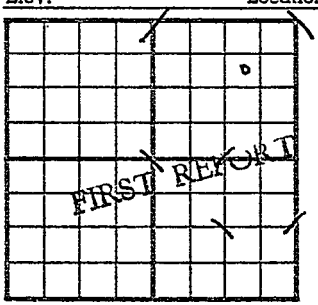

990 Ft. From N Line NE

990 Ft. From E Line Quarter

1st. Report SEP 30 1953

Completion

Remarks

Morrison - Contr.

Spudding Date

Drlg. Data Wildcat

M I R

J. G. McGEHEE

FORM 275 FOR SALE BY KANSAS BLUE PRINT CO.


County Greenwood State Kansas

Sec. 6 (Blk. Twp.) 26 (Sur. Rge.) 9E Map No.

Operator Akin & Owen

Well No. 1 Farm Henson

Elev. Location SW NE NE

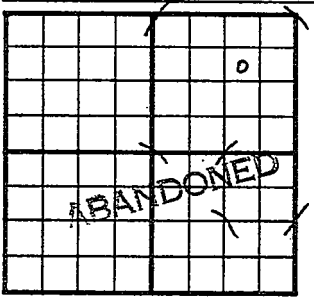

990 Ft. From N Line NE

990 Ft. From E Line Quarter

1st. Report

Completion OCT 21 1953

Remarks Wildcat

Morrison - Contr.

Spudding Date 9-28-53

Drlg. Data D & A TD 2375

8" @ 119 Lans. 1390 KC 1730

Bart. 2295 TD 2375 4" @ 2375

41/ 2296-2309 sd-frac

D & A

J. G. McGEHEE