


Map No. _____ Sec. 4 Twp. 26 R. 5Well No. 7 Robbins Farm _____Poster Oil Company _____

NORTH

WEST

EAST

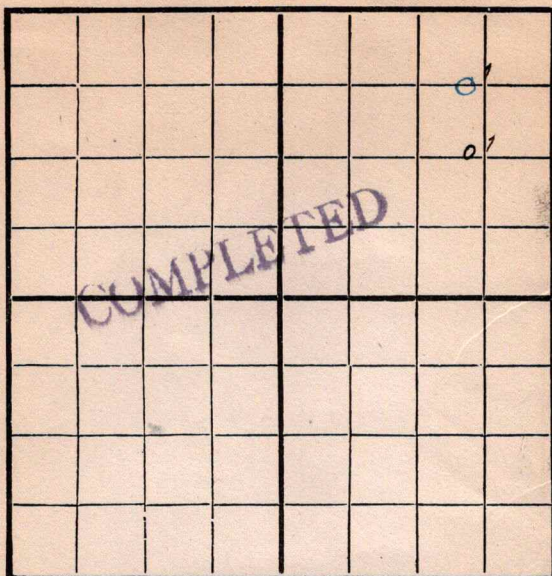

SOUTH

Location ✓ ✓Rig Up 12-18-16

Drilling Remarks:

12/28: 1/1:
spudding 1/8/17
300: 1/15:

Drilling Remarks:

RECORD

Cased _____ in _____ Ft.

Sand _____

Gas _____

Oil _____

Total Depth _____

PRODUCTION

1st 24 hrs. Nat. _____

1st 24 hrs. after shot _____

Gas _____ Cu. Ft.

Dry Hole _____

Abandoned _____

Map No. _____ Sec. 4 Twp. 26 R. 5
 Well No. 7 Dobbin Farm _____

NORTH

WEST

EAST

SOUTH

Location _____
 Rig Up ☒ _____
 Drilling and remarks _____

RECORD

Cased _____ in. _____ Ft.
 Sand _____
 Gas _____
 Oil _____
 Total Depth _____

PRODUCTION

1st 24 hrs. Nat. _____
 1st 24 hrs. after shot _____
 Gas _____ Cu. Ft.
 Dry Hole _____
 Abandoned _____

Date

12/18, 1916

Scout


Map No. _____ Sec. 4 Twp. 26 R. 5

Well No. 7 Dobbin Farm

Foster Company

NORTH

WEST

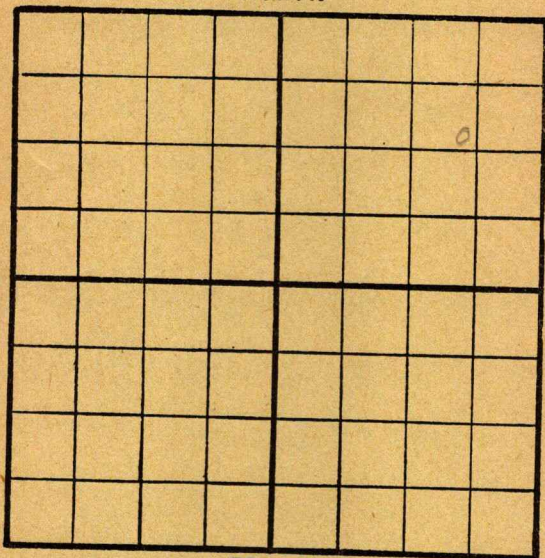

EAST

SOUTH

Location _____

Rig up _____

Drilling and remarks

RECORD

Cased _____ in. _____ Ft.

Sand _____

Gas _____

Oil _____

Total Depth _____

PRODUCTION

1st. 24 hrs. Nat. _____

1st 24 hrs. after shot _____

Gas _____ Cu. Ft.

Dry Hole _____

Abandoned _____

Date


12/28, 1916, C. C. C. Scout

Map No. _____ Sec. 4 Twp. 26 R. 5
 Well No. 7 Dobbin Farm _____
Foster Company _____

NORTH

WEST

EAST

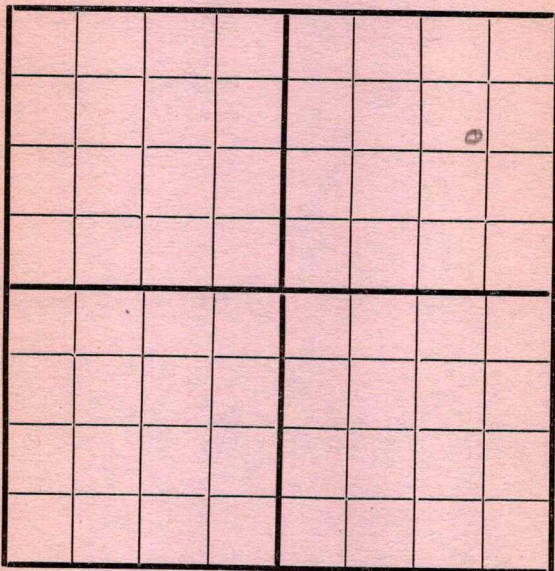

SOUTH

Location _____
 Rig Up _____
 Drilling and remarks _____

Rigged up

RECORD

Cased _____ in. _____ Ft.
 Sand _____
 Gas _____
 Oil _____
 Total Depth _____

PRODUCTION

1st 24 hrs. Nat. _____
 1st 24 hrs. after shot _____
 Gas _____ Cu. Ft.
 Dry Hole _____
 Abandoned _____

Date

1/1, 191

2 Corley


Scout

Map No. _____ Sec. 4 Twp. 26 R. 5
 Well No. 7 Dobbin Farm _____
Foster Company _____

NORTH

WEST

EAST

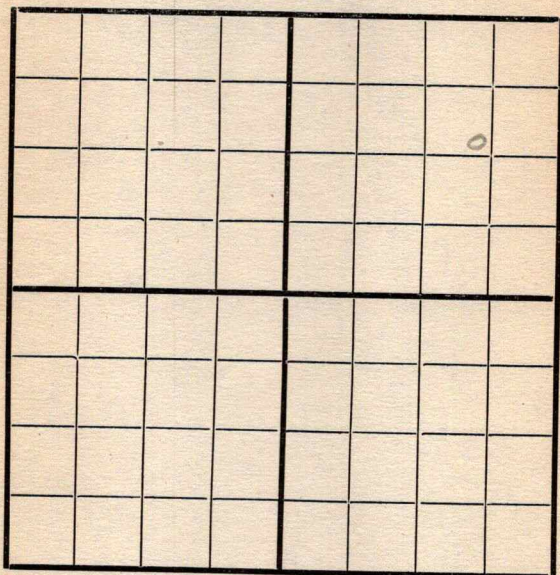

SOUTH

Location _____
 Rig Up _____
 Drilling and remarks _____

Open Drilling

RECORD

Cased _____ in. _____ Ft.
 Sand _____
 Gas _____
 Oil _____
 Total Depth _____

PRODUCTION

1st 24 hrs. Nat. _____
 1st 24 hrs. after shot _____
 Gas _____ Cu. Ft.
 Dry Hole _____
 Abandoned _____


Date

1/8, 1917 *Candiff* Scout

Map No. _____ Sec. 4 Twp. 26 R. 5
 Well No. 7 Dobbin Farm _____
Foster Company _____

NORTH

WEST

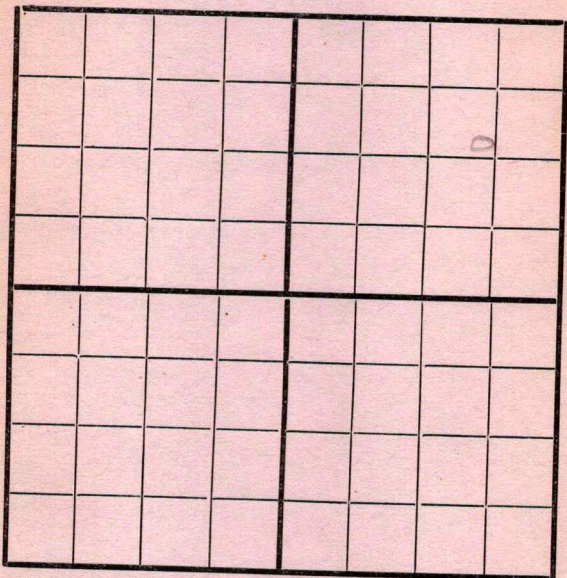

EAST

SOUTH

Location _____
 Rig Up _____
 Drilling and remarks _____

RECORD

Cased _____ in. _____ Ft.
 Sand _____
 Gas _____
 Oil _____
 Total Depth _____

PRODUCTION

1st 24 hrs. Nat. _____
 1st 24 hrs. after shot _____
 Gas _____ Cu. Ft.
 Dry Hole _____
 Abandoned _____

Date

1/15, 1912 Quincy Scout

Map No. _____ Sec. 4 Twp. 26 R. 5
 Well No. 720 Farm _____
Foster Company _____

NORTH

WEST

EAST

SOUTH

Location _____

Rig Up _____

Drilling and remarks

758'

RECORD

Cased _____ in. _____ Ft.

Sand _____

Gas _____

Oil _____

Total Depth _____

PRODUCTION

1st 24 hrs. Nat. _____

1st 24 hrs. after shot _____

Gas _____ Cu. Ft.

Dry Hole _____

Abandoned _____

Date


1/22, 1917

C. J. [Signature]

Scout

Map No. _____ Sec. 4 Twp. 26 R. 5
 Well No. 7 Dobbin Farm _____
Falcon Company _____

NORTH

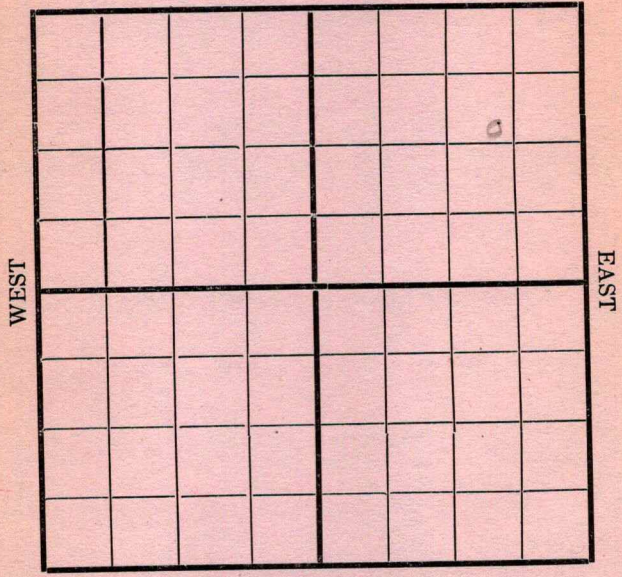

SOUTH

Location _____
 Rig Up _____
 Drilling and remarks _____
1100'

RECORD

Cased _____ in. _____ Ft.
 Sand _____
 Gas _____
 Oil _____
 Total Depth _____

PRODUCTION

1st 24 hrs. Nat. _____
 1st 24 hrs. after shot _____
 Gas _____ Cu. Ft.
 Dry Hole _____
 Abandoned _____

Date 1/29, 1917 Cordell Scout _____

Map No. _____ Sec. 4 Twp. 26 R. 5
 Well No. 72 Robbins Farm _____
Foster Company _____

NORTH

WEST

EAST

SOUTH

Location _____
 Rig Up _____
 Drilling and remarks

1500'

RECORD

Cased _____ in. _____ Ft.
 Sand _____
 Gas _____
 Oil _____
 Total Depth _____

PRODUCTION


1st 24 hrs. Nat. _____
 First 24 hrs. after shot _____
 Gas _____ Cu. Ft.
 Dry Hole _____
 Abandoned _____

Date

2/5, 1917 Carroll Scout

Map No. _____ Sec. 4 Twp. 26 R. 5
 Well No. 7 Dobbin Farm _____
Foster Oil Company _____

NORTH

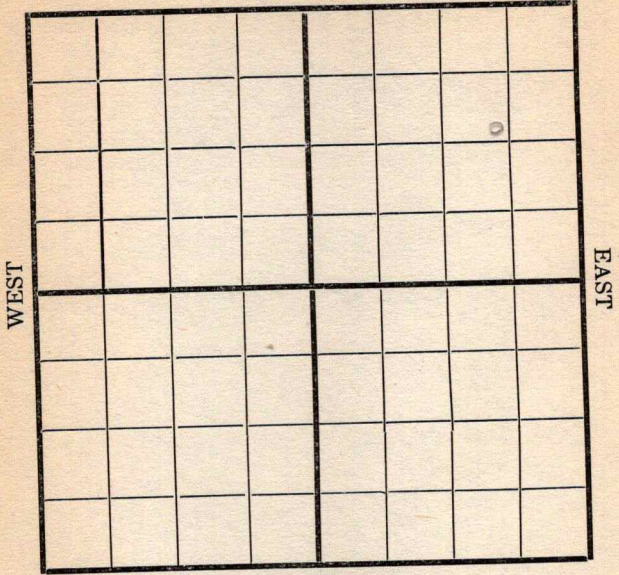


SOUTH

Location _____ Rig Up _____ Drilling and remarks <u>1900'</u>	RECORD
	Cased _____ in. _____ Ft.
	Sand _____
	Gas _____
	Oil _____
	Total Depth _____
	PRODUCTION
	1st 24 hrs. Nat. _____
	1st 24 hrs. after shot _____
	Gas _____ Cu. Ft.
	Dry Hole _____
	Abandoned _____

Date 2/12, 1917 C. J. J. Scout _____

Map No. _____ Sec. 4 Twp. 26 R. 5
 Well No. 17 Dobbins Farm _____
Foster Company _____

NORTH

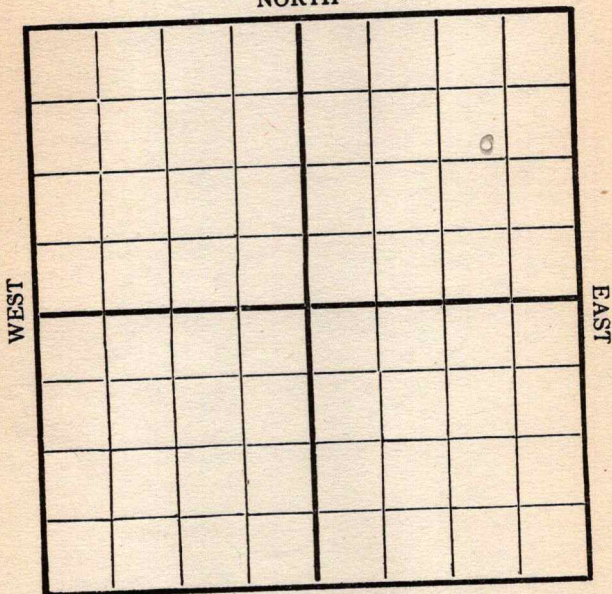

SOUTH

Location _____
 Rig Up _____
 Drilling and remarks

2140'

RECORD

Cased _____ in. _____ Ft.
 Sand _____
 Gas _____
 Oil _____
 Total Depth _____

PRODUCTION

1st 24 hrs. Nat. _____
 1st 24 hrs. after shot _____
 Gas _____ Cu. Ft.
 Dry Hole _____
 Abandoned _____

Date


Aug 19, 1917 J. Corbett Scout

Map No. _____ Sec. 4 Twp. 26 R. 5
 Well No. 7 Dubois Farm _____
Joan Company _____

NORTH

WEST

EAST

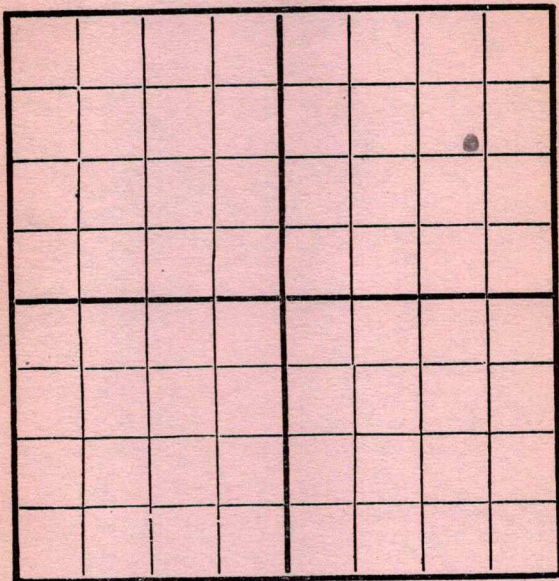

SOUTH

Location _____
 Rig Up _____
 Drilling and remarks

2300

RECORD

Cased _____ in. _____ Ft.
 Sand _____
 Gas _____
 Oil _____
 Total Depth _____

PRODUCTION


1st 24 hrs. Nat. _____
 First 24 hrs. after shot _____
 Gas _____ Cu. Ft.
 Dry Hole _____
 Abandoned _____

Date

Feb 7 1917 Scout _____

Map No. _____ Sec. 4 Twp. 26 R. 5
 Well No. 7 Dobbin Farm _____
Foster Company _____

NORTH

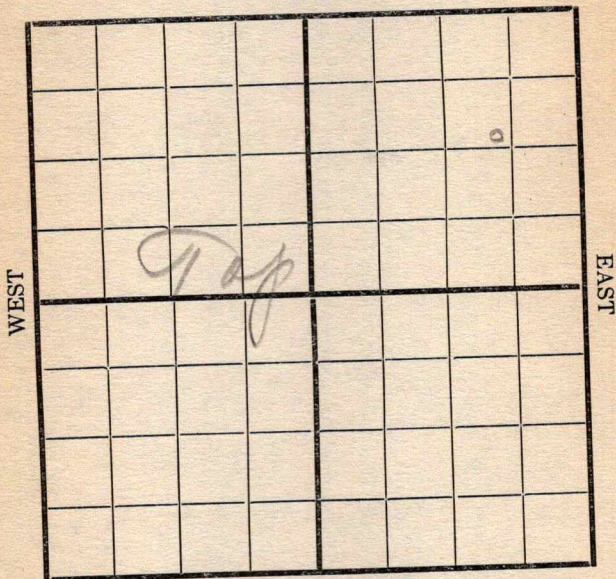

SOUTH

Location _____
 Rig Up _____
 Drilling and remarks

Top sand
2577'

RECORD

Cased _____ in. _____ Ft.
 Sand 2577
 Gas _____
 Oil _____
 Total Depth _____

PRODUCTION

1st 24 hrs. Nat. _____
 1st 24 hrs. after shot _____
 Gas _____ Cu. Ft.
 Dry Hole _____
 Abandoned _____

Date


3-5, 191 7 _____ Scout _____

Map No. _____ Sec. 4 Twp. 26 R. 5

Well No. 7 Dobbin Farm _____

Fraser Company _____

NORTH

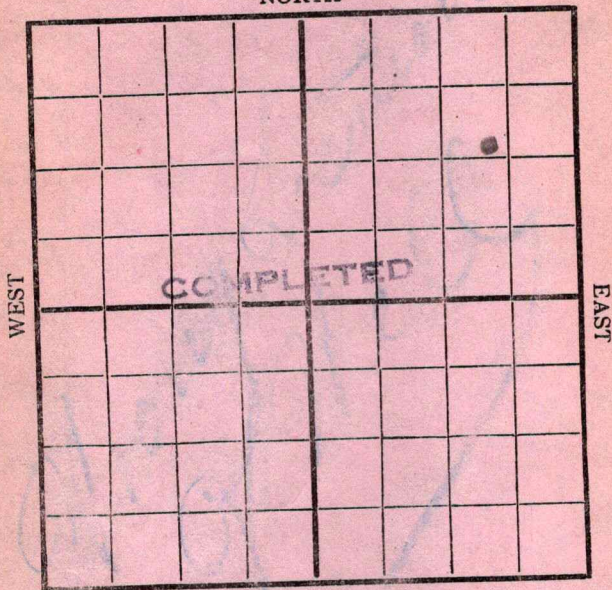

SOUTH

REMARKS:

COMPLETED

and 2577 } 200
2592 }
Est at 200 Bbls

Date

3/12 1917 Carney Scout