


Map No. _____ Sec. 4 Twp. 26 R. 5

Well No. 8-Robbins Farm _____

Booster Company _____

NORTH

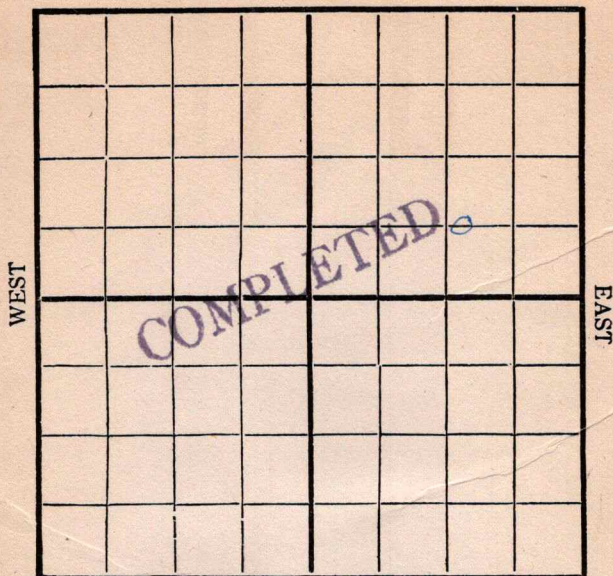

SOUTH

Location _____

Drilling Remarks:

Spdg. 1/15

Rig Up 1-1-17
1-8-17

Drilling Remarks:

RECORD

Cased _____ in _____ Ft.

Sand _____

Gas _____

Oil _____

Total Depth _____

PRODUCTION

1st 24 hrs. Nat. _____

1st 24 hrs. after shot _____

Gas _____ Cu. Ft.


Dry Hole _____

Abandoned _____

Map No. _____ Sec. H Twp. 26 R. 5
 Well No. J. D. Blair Farm _____
Foster Company _____

NORTH

WEST

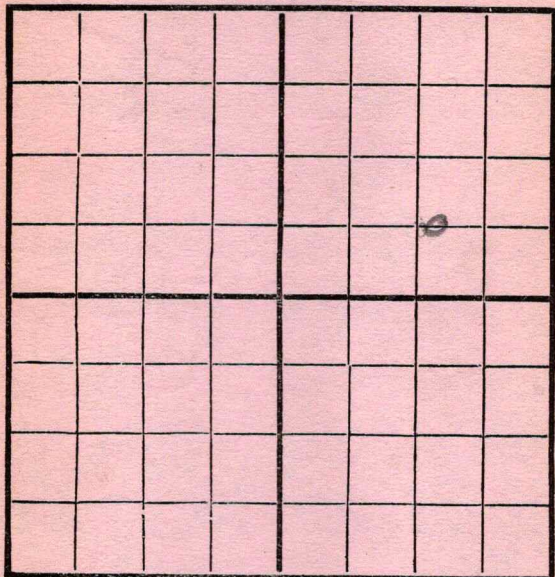

EAST

SOUTH

Location _____
 Rig Up ☒ _____
 Drilling and remarks _____

RECORD

Cased _____ in. _____ Ft.
 Sand _____
 Gas _____
 Oil _____
 Total Depth _____

PRODUCTION


1st 24 hrs. Nat. _____
 First 24 hrs. after shot _____
 Gas _____ Cu. Ft.
 Dry Hole _____
 Abandoned _____

Date

1/1, 191 7 Co. 1st Scout _____

Map No. _____ Sec. 4 Twp. 26 R. 5
 Well No. S Dobbins Farm _____
Foster Company _____

NORTH

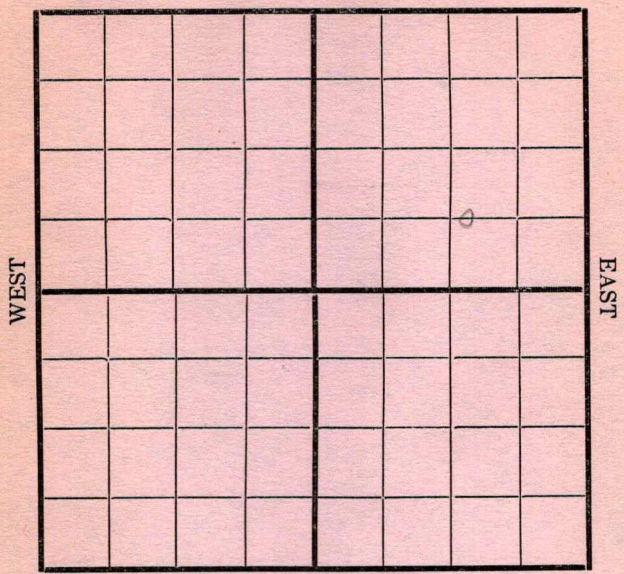

SOUTH

Location _____
 Rig Up _____
 Drilling and remarks _____

Rigging

RECORD

Cased _____ in. _____ Ft.
 Sand _____
 Gas _____
 Oil _____
 Total Depth _____

PRODUCTION


1st 24 hrs. Nat. _____
 1st 24 hrs. after shot _____
 Gas _____ Cu. Ft.
 Dry Hole _____
 Abandoned _____

Date

1/8, 1917 Conditt Scout

Map No. _____ Sec. 14 Twp. 26 R. 5
 Well No. 2 Dobbin Farm _____
Foster Company _____

NORTH

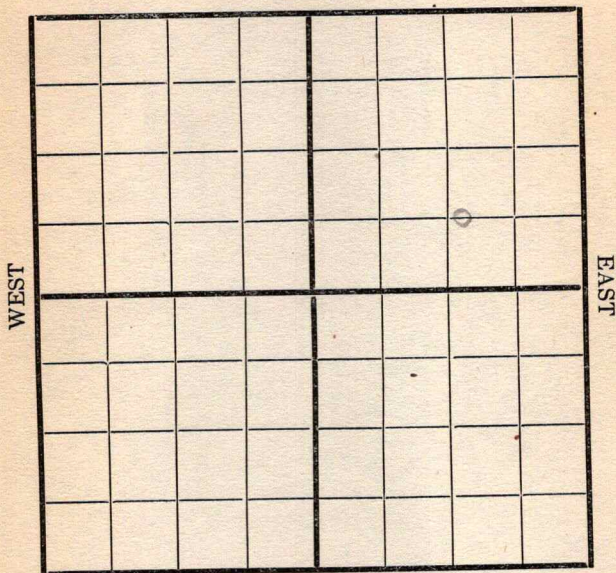

SOUTH

Location _____
 Rig Up _____
 Drilling and remarks

Spudding

RECORD

Cased _____ in. _____ Ft.
 Sand _____
 Gas _____
 Oil _____
 Total Depth _____

PRODUCTION


1st 24 hrs. Nat. _____
 1st 24 hrs. after shot _____
 Gas _____ Cu. Ft.
 Dry Hole _____
 Abandoned _____

Date

1/15, 191 7 *Carroll* Scout _____

Map No. _____ Sec. 4 Twp. 26 R. 5
 Well No. 82 Dobbin Farm _____
Foster Company _____

NORTH

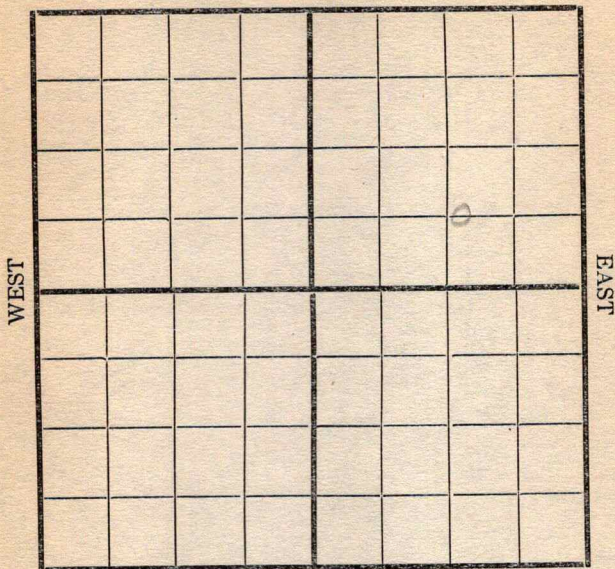

SOUTH

Location _____
 Rig Up _____
 Drilling and remarks _____

RECORD

* Cased _____ in. _____ Ft.
 Sand _____
 Gas _____
 Oil _____
 Total Depth _____

PRODUCTION

1st 24 hrs. Nat. _____
 1st 24 hrs. after shot _____
 Gas _____ Cu. Ft.
 Dry Hole _____
 Abandoned _____

Date

1/22, 1912 Condoff Scout _____

Map No. _____ Sec. 4 Twp. 26 R. 5
 Well No. 8 Dobbin Farm _____
Foster Company _____

NORTH

WEST

EAST

SOUTH

Location _____
 Rig Up _____
 Drilling and remarks _____

820'

RECORD

Cased _____ in. _____ Ft.
 Sand _____
 Gas _____
 Oil _____
 Total Depth _____

PRODUCTION

1st 24 hrs. Nat. _____
 1st 24 hrs. after shot _____
 Gas _____ Cu. Ft.
 Dry Hole _____
 Abandoned _____


Date

1/29, 1917 Cody Scout

Map No. _____ Sec. 4 Twp. 26 R. 5
Well No. 8 Dobbin Farm _____
Foster Company _____

NORTH

WEST

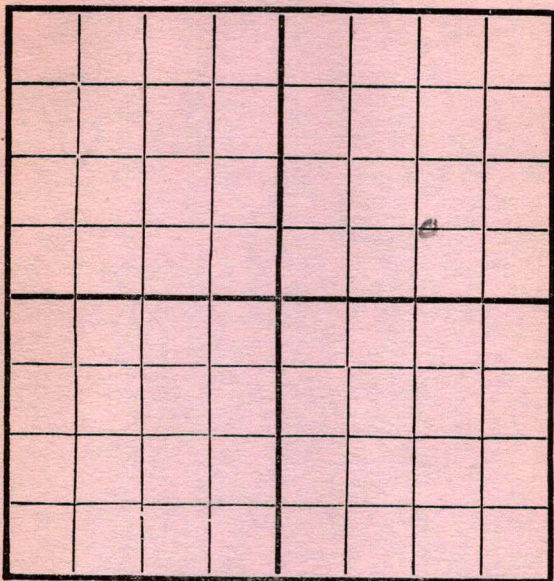

EAST

SOUTH

Location _____

Rig Up _____

Drilling and remarks

RECORD

Cased _____ in. _____ Ft.

Sand _____

Gas _____

Oil _____

Total Depth _____

PRODUCTION

1st 24 hrs. Nat. _____

First 24 hrs. after shot _____

Gas _____ Cu. Ft.

Dry Hole _____

Abandoned _____

Date

8/5, 1917 Candy Scout

Map No. _____ Sec. 4 Twp. 26 R. 5
 Well No. S. Dobbin Farm _____
Foster Oil Company _____

NORTH

WEST

EAST

SOUTH

Location _____
 Rig Up _____
 Drilling and remarks

RECORD

Cased in. Ft.
 Sand _____
 Gas _____
 Oil _____
 Total Depth _____

PRODUCTION

1st 24 hrs. Nat. _____
 1st 24 hrs. after shot _____
 Gas _____ Cu. Ft.
 Dry Hole _____
 Abandoned _____


Date

2/27, 1917 Cardeff Scout

Map No. _____ Sec. 4 Twp. 26 R. 5
 Well No. 2 Dobbin Farm _____
Foster Company _____

NORTH

WEST

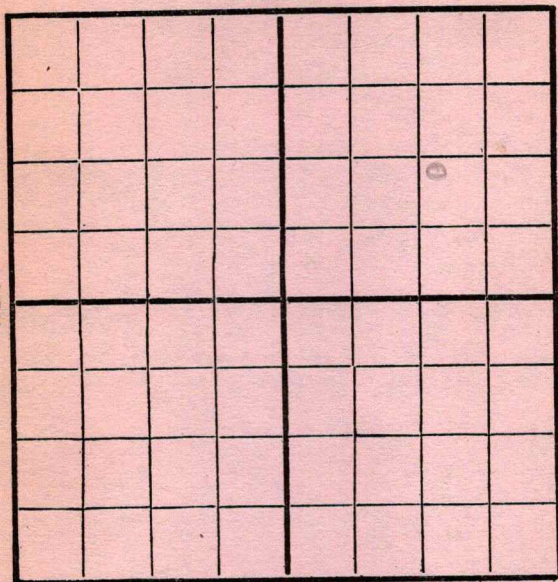

EAST

SOUTH

Location _____

Rig Up _____

Drilling and remarks

1920

RECORD

Cased _____ in. _____ Ft.

Sand _____

Gas _____

Oil _____

Total Depth _____

PRODUCTION

1st 24 hrs. Nat. _____

1st 24 hrs. after shot _____

Gas _____ Cu. Ft.

Dry Hole _____

Abandoned _____


Date

Aug 7 1920 Scout _____

Map No. _____ Sec. 4 Twp. 26 R. 5
 Well No. J. Dobbin Farm _____
Foster Company _____

NORTH

WEST

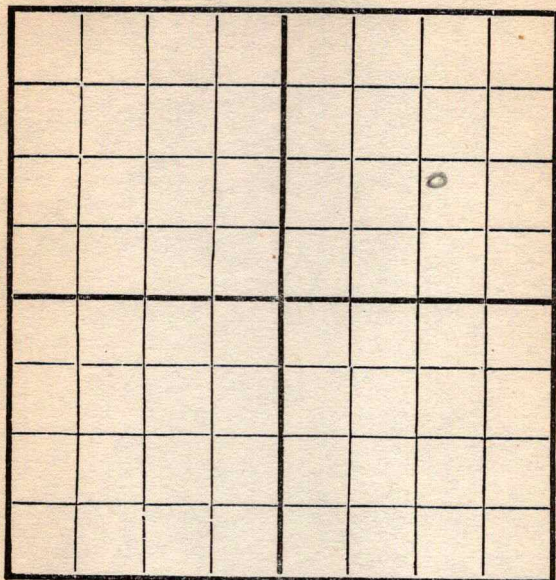

EAST

SOUTH

Location _____
 Rig Up _____
 Drilling and remarks

2200

RECORD

Cased _____ in. _____ Ft.
 Sand _____
 Gas _____
 Oil _____
 Total Depth _____

PRODUCTION


1st 24 hrs. Nat. _____
 First 24 hrs. after shot _____
 Gas _____ Cu. Ft.
 Dry Hole _____
 Abandoned _____

Date

Feb 26 1917 Carby Scout

Map No. _____ Sec. 4 Twp. 26 R. 5
 Well No. 8 Dobbin Farm _____
Foster Company _____

NORTH

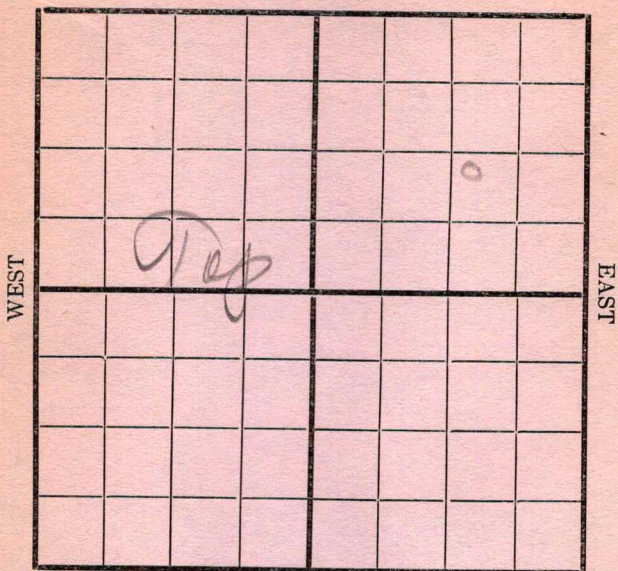

SOUTH

Location _____
 Rig Up _____
 Drilling and remarks _____

Tap sand
2605'

RECORD

Cased _____ in. _____ Ft.
 Sand _____
 Gas _____
 Oil _____
 Total Depth _____


PRODUCTION

1st 24 hrs. Nat. _____
 1st 24 hrs. after shot _____
 Gas _____ Cu. Ft.
 Dry Hole _____
 Abandoned _____

Date 3/5, 1917 Condy Scout _____

Map No. _____ Sec. 4 Twp. 26 R. 5
 Well No. 8 Dobbin Farm _____
Foster Company _____

NORTH

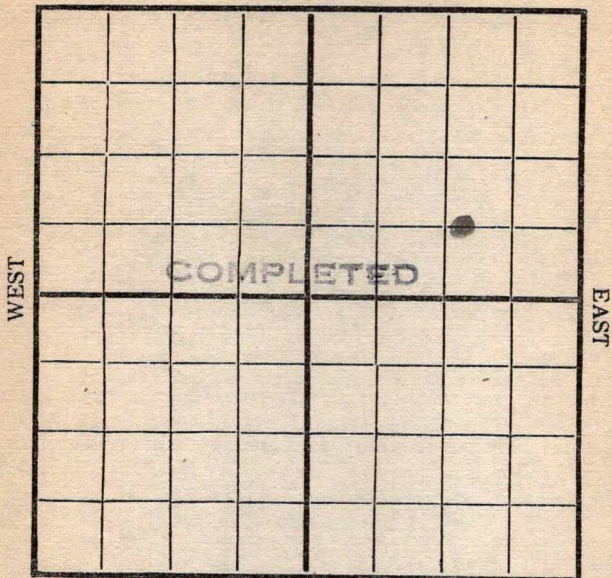

SOUTH

REMARKS:

COMPLETED

*Sound 2609 } 200
 2628 }
 Est at 200 Bbl.*

Date

3/2, 191 *2* *Carly* Scout