


Map No. _____ Sec. 4 Twp. 2.6 R. 5

Well No. 9. Robbins Farm _____

Booster Company _____

NORTH

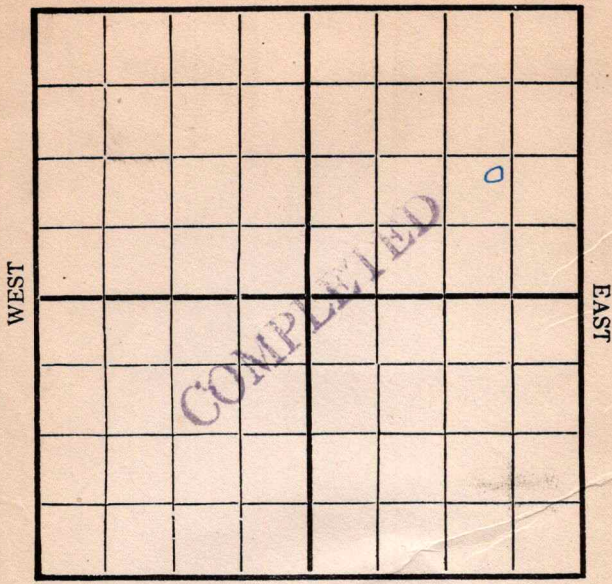

SOUTH

Location _____

Drilling Remarks:

Spdg. 4/15

Rig Up 1-1-17

1-8-17
Drilling Remarks:

RECORD

Cased _____ in _____ Ft.
Sand _____
Gas _____
Oil _____
Total Depth _____


PRODUCTION

1st 24 hrs. Nat. _____
1st 24 hrs. after shot _____
Gas _____ Cu. Ft.
Dry Hole _____
Abandoned _____

Map No. _____ Sec. 4 Twp. 26 R. 5
 Well No. 9 Dobbin Farm _____
Foster Company _____

NORTH

WEST

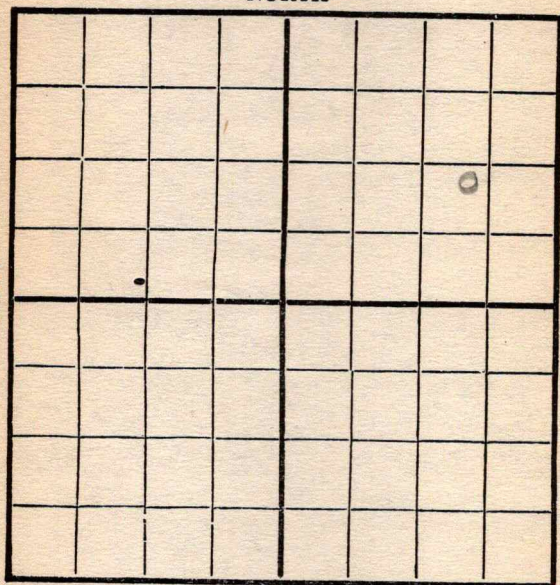

EAST

SOUTH

Location _____
 Rig Up ✓ _____
 Drilling and remarks _____

RECORD

Cased _____ in. _____ Ft.
 Sand _____
 Gas _____
 Oil _____
 Total Depth _____

PRODUCTION


1st 24 hrs. Nat. _____
 First 24 hrs. after shot _____
 Gas _____ Cu. Ft.
 Dry Hole _____
 Abandoned _____

Date

1/1, 191 7 Scout

Map No. _____ Sec. 4 Twp. 26 R. 5
 Well No. 9 Dobbin Farm _____
Foster Company _____

NORTH

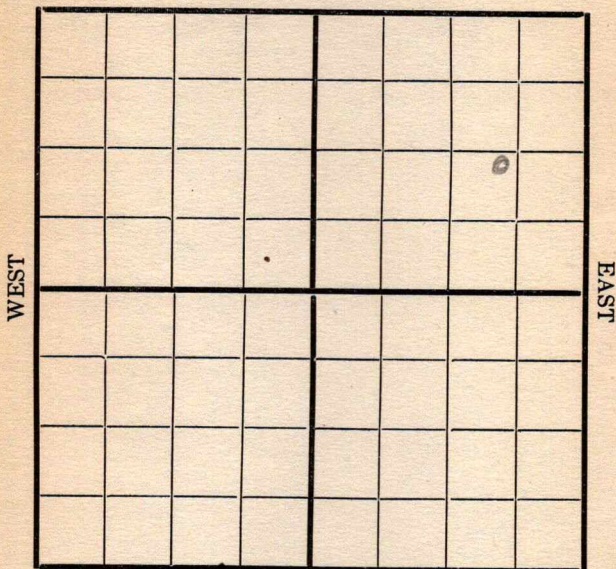

SOUTH

Location _____
 Rig Up ☒ _____
 Drilling and remarks _____

RECORD

Cased _____ in. _____ Ft.
 Sand _____
 Gas _____
 Oil _____
 Total Depth _____

PRODUCTION

1st 24 hrs. Nat. _____
 1st 24 hrs. after shot _____
 Gas _____ Cu. Ft.
 Dry Hole _____
 Abandoned _____


Date 1/8, 1917. Condy Scout _____

Map No. _____ Sec. 4 Twp. 26 R. 5
 Well No. 9 Dobbin Farm _____
Foster Company _____

NORTH

WEST

EAST

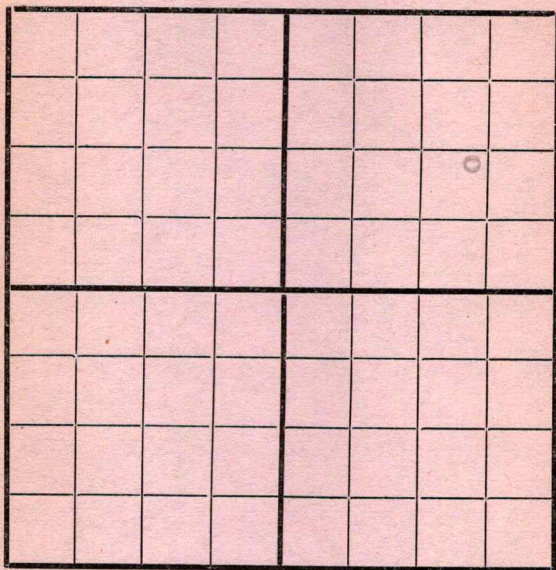

SOUTH

Location _____
 Rig Up _____
 Drilling and remarks _____

Spudding

RECORD

Cased _____ in. _____ Ft.
 Sand _____
 Gas _____
 Oil _____
 Total Depth _____

PRODUCTION

1st 24 hrs. Nat. _____
 1st 24 hrs. after shot _____
 Gas _____ Cu. Ft.
 Dry Hole _____
 Abandoned _____

Date

1/15, 1917 Carley Scout

Map No. _____ Sec. 4 Twp. 26 R. 5
 Well No. 9 Dobbin Farm _____
4 aster Company _____

NORTH

WEST

EAST

SOUTH

Location _____

Rig Up _____

Drilling and remarks

150'

RECORD

Cased _____ in. _____ Ft.

Sand _____

Gas _____

Oil _____

Total Depth _____

PRODUCTION

1st 24 hrs. Nat. _____

1st 24 hrs. after shot _____

Gas _____ Cu. Ft.

Dry Hole _____

Abandoned _____


Date

1/22, 191 7Condy Scout

Map No. _____ Sec. 4 Twp. 26 R. 5
 Well No. 9 Dobbin Farm _____
Foster Company _____

NORTH

WEST

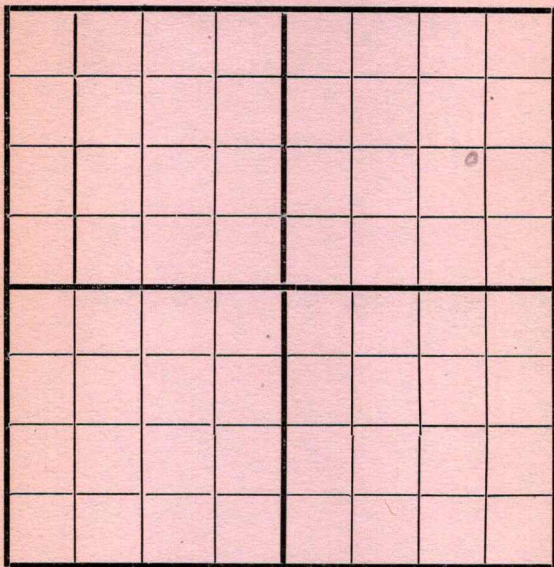

EAST

SOUTH

Location _____
 Rig Up _____
 Drilling and remarks

460

RECORD

Cased _____ in. _____ Ft.
 Sand _____
 Gas _____
 Oil _____
 Total Depth _____

PRODUCTION


1st 24 hrs. Nat. _____
 1st 24 hrs. after shot _____
 Gas _____ Cu. Ft.
 Dry Hole _____
 Abandoned _____

Date 1/29, 1917 Conroy Scout

Map No. _____ Sec. 4 Twp. 26 R. 5
 Well No. 92 obbies Farm _____
hunter Company _____

NORTH

WEST

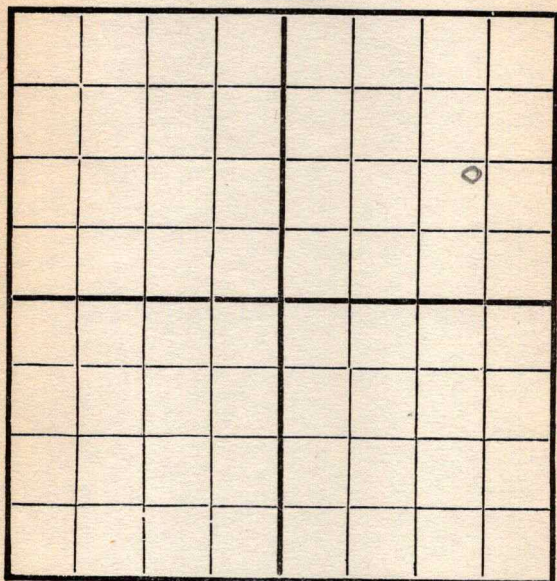

EAST

SOUTH

Location _____
 Rig Up _____
 Drilling and remarks _____

500'

RECORD

Cased _____ in. _____ Ft.
 Sand _____
 Gas _____
 Oil _____
 Total Depth _____

PRODUCTION


1st 24 hrs. Nat. _____
 First 24 hrs. after shot _____
 Gas _____ Cu. Ft.
 Dry Hole _____
 Abandoned _____

Date

2/5, 1917 C. C. C. Scout

Map No. _____ Sec. 4 Twp. 26 R. 5
Well No. 9 Dobbin Farm _____
Greene Company _____

NORTH

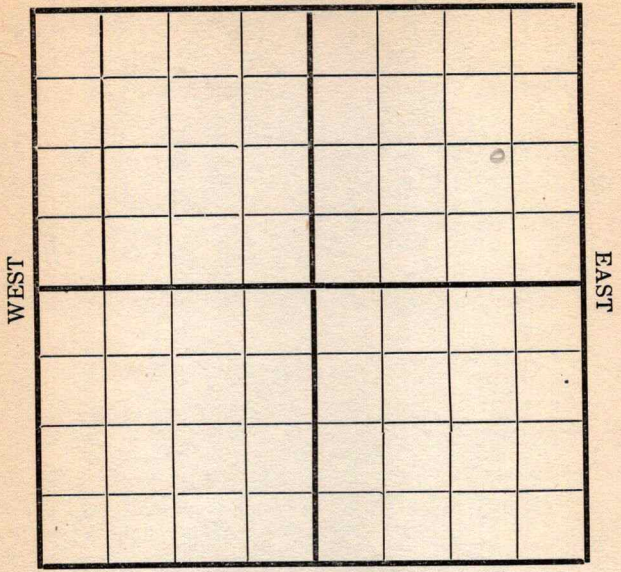

SOUTH

Location _____
Rig Up _____
Drilling and remarks _____

930

RECORD

Cased _____ in. _____ Ft.
Sand _____
Gas _____
Oil _____
Total Depth _____

PRODUCTION

1st 24 hrs. Nat. _____
1st 24 hrs. after shot _____
Gas _____ Cu. Ft.
Dry Hole _____
Abandoned _____

Date Feb 7 1917 Conley Scout

Map No. _____ Sec. 4 Twp. 26 R. 5Well No. 9 D. R. R. Farm __________Johnson Company _____

NORTH

WEST

EAST

SOUTH

Location _____

Rig Up _____

Drilling and remarks

1480

RECORD

Cased _____ in. _____ Ft.

Sand _____

Gas _____

Oil _____

Total Depth _____

PRODUCTION

1st 24 hrs. Nat. _____

1st 24 hrs. after shot _____

Gas _____ Cu. Ft.

Dry Hole _____

Abandoned _____

Date


2/19 191 2Cardiff Scout

Map No. _____ Sec. 4 Twp. 26 R. 5
 Well No. 9 Dabbin Farm _____
fuata Company _____

NORTH

WEST

EAST

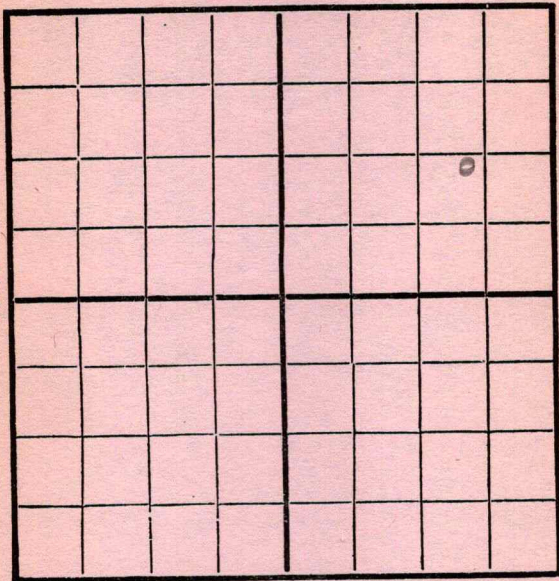

SOUTH

Location _____
 Rig Up _____
 Drilling and remarks _____

1750

RECORD

Cased _____ in. _____ Ft.
 Sand _____
 Gas _____
 Oil _____
 Total Depth _____

PRODUCTION

1st 24 hrs. Nat. _____
 First 24 hrs. after shot _____
 Gas _____ Cu. Ft.
 Dry Hole _____
 Abandoned _____

Date

9/26 191 7 Carney


Scout

Map No. _____ Sec. 4 Twp. 26 R. 5
 Well No. 92 Dobbin Farm _____
Tractor Company _____

NORTH

WEST

EAST

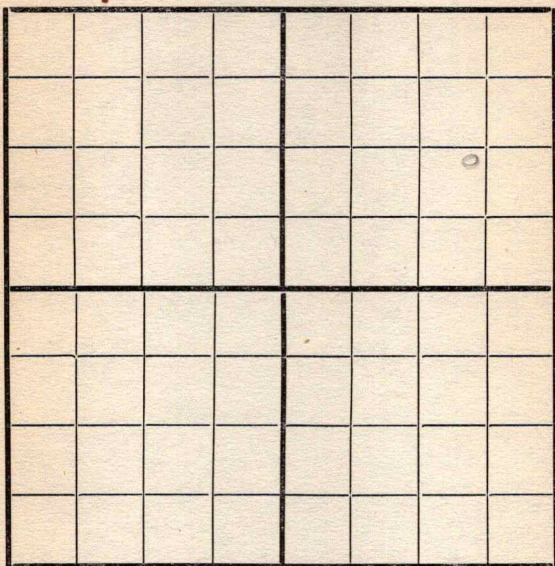

SOUTH

Location _____
 Rig Up _____
 Drilling and remarks _____

2400'

RECORD

Cased _____ in. _____ Ft.
 Sand _____
 Gas _____
 Oil _____
 Total Depth _____

PRODUCTION

1st 24 hrs. Nat. _____
 1st 24 hrs. after shot _____
 Gas _____ Cu. Ft.
 Dry Hole _____
 Abandoned _____

Date

3/5, 191 7 Condif Scout _____

Map No. _____ Sec. 4 Twp. 26 R. 5
 Well No. 9 Dobbin Farm _____
Foster Company _____

NORTH

WEST

EAST

SOUTH

REMARKS:

Tap sand 2597


Date

3/12, 1912 Carney Scout

Map No. _____ Sec. 4 Twp. 26 R. 5
 Well No. 92 Dobbin Farm _____
Foster Company _____

NORTH

WEST

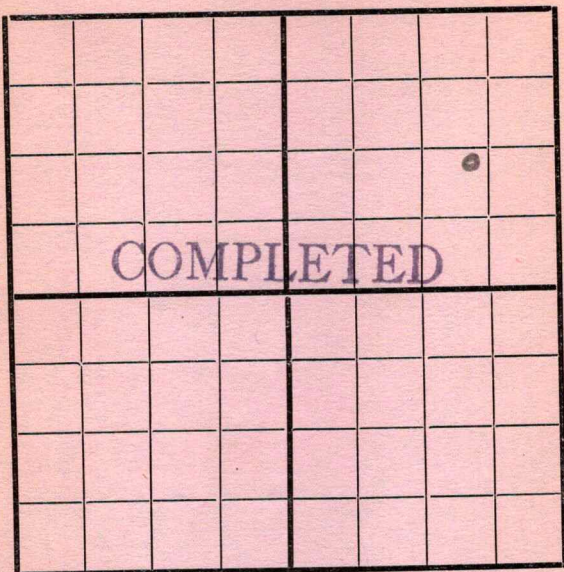

EAST

SOUTH

Location _____

Rig Up _____

Drilling and remarks

Est at
300 bbl

P 80

RECORD

Cased _____ in. _____ Ft.

Sand 2597 - 2621

Gas _____

Oil _____

Total Depth _____

PRODUCTION

1st 24 hrs. Nat. _____

1st 24 hrs. after shot _____

Gas _____ Cu. Ft.

Dry Hole _____

Abandoned _____

Date

5/21, 1917 Carby Scout