

Map No. 15 Sec. 36 Twp. 26 R. 5Well No. 1 Yenner FarmBurke & Nelson Company

NORTH

WEST

EAST

SOUTH

Location _____ Rig up _____

Drilling Remarks:

Drilling Remarks:

RECORD

Cased _____ in. _____ ft.

Sand _____

Gas _____

Oil _____

Total Depth _____

PRODUCTION

1st 24 hrs Nat. _____

1st 24 hrs. after shot _____

Gas _____ cu. ft.

Dry Hole _____

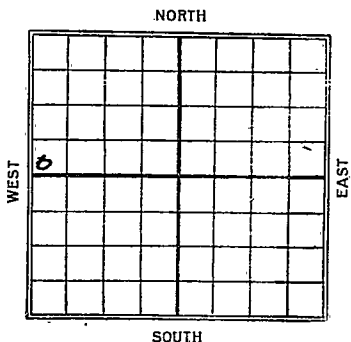
Abandoned _____

Map No. 11 Sec. 36 Twp. 26 R. 8Well No. 1 Yummer Farm
Burke & Nelson Company

_____ Ft. from N. Line

200 Ft. from S. Line

_____ Ft. from E. Line

200 Ft. from W. Line

Date

REPORT

19245/22 Location6/10 Re-grasp7/16 setting 6 5/8 at 1990'7/23 S. O. Top Line 24507/28 Top 2465'Plugged 25028/6 Top Line 2465 D. & G. 2502'

15 **KANSAS** Map No. _____ Sec. 36 Twp. 26 R. 8

Well No. 1 Gunner

Burke & Nelson Company

Contractor

FIRST REPORT

_____ Ft. from N. Line

200 Ft. from S. Line

_____ Ft. from E. Line

200 Ft. from W. Line

SECTION PLAT

0			

Location ✓ ✓

Rig up _____

Drilling and Remarks:

RECORD

Cased _____ in., _____ ft.

Sand _____

Gas _____

Oil _____

Total Depth _____

PRODUCTION

1st 24 hrs. Nat. _____

1st 24 hrs. after shot _____

Gas _____ Cu. Ft.

Dry Hole _____

Abandoned _____

Date

MAY 22 1924

M. A. BENEAR

192

Scout

Map No. **KANSAS** ¹⁵ Sec. **36** Twp. **26** R. **8**Well No. **1** *Munnin*
Gilbert & Burk Company

Contractor

ABANDONED**SECTION PLAT**

Ft. from N. Line

200 Ft. from S. Line

Ft. from E. Line

200 Ft. from W. Line

Location

Rig up

Drilling and Remarks:

*Tap L. 2465**1049**2502'***RECORD**

Cased _____ in., _____ ft.

Sand _____

Gas _____

Oil _____

Total Depth _____

PRODUCTION

1st 24 hrs. Nat. _____

1st 24 hrs. after shot _____

Gas _____ Cu. Ft.

Dry Hole _____

Abandoned _____

Date

AUG 6 1924**192****M. A. BENEAR****Scout**