

KANSAS


FORM 51 5M PETROL

Butler

Section 4 Township 26 Range 5-E

Well No. 22 Finney

Company Citites Service Oil

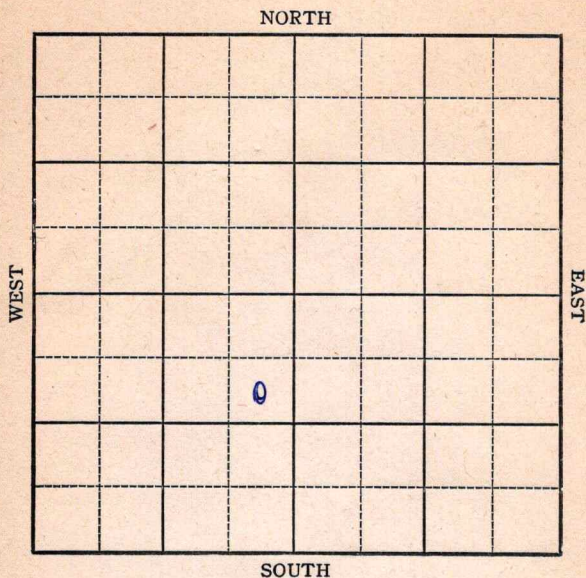

KANSAS


Butler

Sec. 4 Twp. 26 R. 5-E

Well No. #22 Finney Farm

Cities Service Oil Company

NORTH

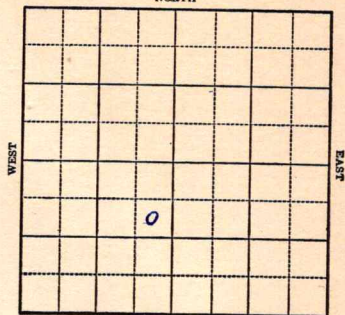

990 Ft. from N. Line

 Ft. from S. Line

330 Ft. from E. Line

 Ft. from W. Line

1943

R E P O R T

10/6 Location

10/13 10" @ 40'
rig. 1445'

10/20 Lans 1702
KC 1988
Drlg. 2148

10/27 Miss 2470
T.D. 2483
7" @ 2470
Rust

11/3 Simp Sd 2500
T.D. 2551
50 qts 2505-25
10 qts 2475-80 CO

11/10 2 " " " "

11/17 " " " " "

11/24 " " " "

12/1 " " " "

12/8 " " " "

12-15 Pump 3½ oil a day

12/22 " " " "

12/29 " " " "

1944

1-5 " " " "

OVER

1944

1/12

7" @ 2470

Simp sd 2500

TD 2551

60 qts 2475-2505

Pump 4 Pot.

Gravity 36


COMPLETED

KANSAS

Map No. 14 Sec. 4 Twp. 26 R. 5EWell No. 22 FinneyCities Service Oil CompanyFIRST REPORT Contractor

SE NE SW

SECTION PLAT

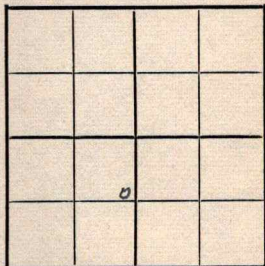990 Ft. from N. Line Ft. from S. Line330 Ft. from E. Line Ft. from W. LineMiscellaneousLocation XRig up

Drilling and Remarks:

RECORD

Cased in., ft.Sand Gas Oil Total Depth

PRODUCTION

1st 24 hrs. Nat. 1st 24 hrs. after shot Gas Cu. Ft.Dry Hole Abandoned

Date

OCT 6 1943 19S. J. LEWIS Scout

Map No. 14 Sec. 4 Twp. 26 R. 5E


Well No. 22 Finney

Cities Service Oil Company

COMPLETED Contractor

SE NE SW

SECTION PLAT

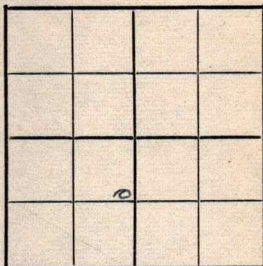

990 Ft. from N. Line

_____ Ft. from S. Line

330 Ft. from E. Line

_____ Ft. from W. Line

Miscellaneous

Location _____

Rig up _____

Drilling and Remarks:

Simple 2500
7' to 2470
609 to 2475-2505.
Pray 4 RT
360 ft

RECORD

Cased _____ in., _____ ft.

Sand _____

Gas _____

Oil _____

Total Depth 2551

PRODUCTION

1st 24 hrs. Nat. _____

1st 24 hrs. after shot _____

Gas _____ Cu. Ft.

Dry Hole _____

Abandoned _____

Date

JAN 12 1944 19

S. J. LEWIS Scout