


Map No. KANSAS Sec. 6 Twp. 26 R. 9Well No. 1-Nichols Farm
W.W. Kiskadden Company

_____ Ft. from N. Line

990 Ft. from S. Line330 Ft. from E. Line

_____ Ft. from W. Line

NORTH

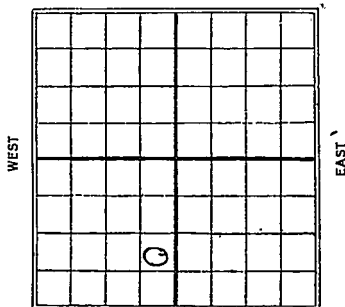

SOUTH

1927

Date

REPORT

<u>8/24</u>	<u>Location</u>
<u>9/1</u>	<u>---</u>
<u>9/7</u>	<u>---</u>
<u>9/14</u>	<u>---</u>
<u>9/29</u>	<u>---</u>
<u>10/6</u>	<u>---</u>
<u>10/12</u>	<u>---</u>
<u>10/19</u>	<u>---</u>
<u>10/27</u>	<u>---</u>
<u>11/2</u>	<u>---</u>
<u>11/9</u>	<u>---</u>
<u>11/16</u>	<u>---</u>
<u>11/23</u>	<u>---</u>
<u>11/30</u>	<u>---</u>
<u>12/7</u>	<u>---</u>
<u>12/14</u>	<u>---</u>
<u>12/21</u>	<u>---</u>
<u>12/29</u>	<u>---</u>
<u>1928</u>	
<u>1/5</u>	<u>location</u>
<u>1/11</u>	<u>---</u>
<u>1/18</u>	<u>---</u>
<u>1/26</u>	<u>---</u>

2/1/28 Location
abandoned

K15 KANSAS

Map No. _____ Sec. 6 Twp. 26 R. 9Well No. 1 NicholsW. W. Kiskaden Company_____
Contractor

FIRST REPORTS

SECTION PLAT

Ft. from N. Line990 Ft. from S. Line330 Ft. from E. Line_____
Ft. from W. Line

	0		

Location ☒ _____

Rig up _____

Drilling and Remarks:

RECORD

Cased _____ in., _____ ft.

Sand _____

Gas _____

Oil _____

Total Depth _____

PRODUCTION

1st 24 hrs. Nat. _____

1st 24 hrs. after shot _____

Gas _____ Cu. Ft.

Dry Hole _____

Abandoned _____

Date

AUG 24 1927

CHAS. L. SHERWOOD

192

Scout

15 KANSAS
 Map No. _____ Sec. *6* Twp. *26* R. *9*
 Well No. *1 Nichols*

W.W. Kiskadden Company
 _____ Contractor

COMPLETED

_____ Ft. from N. Line
990 Ft. from S. Line
330 Ft. from E. Line
 _____ Ft. from W. Line

ABANDONED

SECTION PLAT

	o		

Location _____
 Rig up _____
 Drilling and Remarks:

RECORD

Cased _____ in., _____ ft.
 Sand _____
 Gas _____
 Oil _____
 Total Depth _____

PRODUCTION

1st 24 hrs. Nat. _____
 1st 24 hrs. after shot _____
 Gas _____ Ca. Ft. _____
 Dry Hole _____
 Abandoned *Location*

Date
 FEB 1 1928

CHAS. L. SHERWOOD
 _____ 192 _____ Scout