
Form 51—5-19—5M—Mid-West

Map No. _____ Sec. 4 Twp. 26 R. 5

Well No. 10 Fulkerson Farm

Empire Company

NORTH

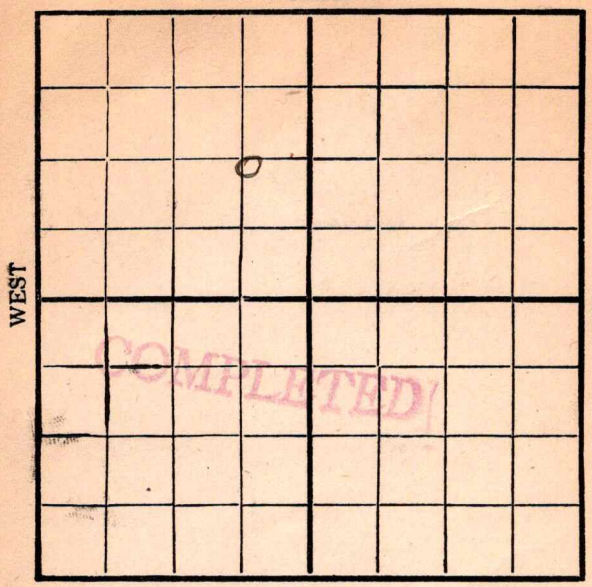

SOUTH

Location _____

Drilling Remarks:

Rig Up _____

Drilling Remarks:

RECORD

Cased _____ in. _____ ft.

Sand _____

Gas _____

Oil _____

Total Depth _____

PRODUCTION

1st 24 hrs. Nat. _____

1st 24 hrs. after shot _____

Gas _____ cu. ft.

Dry Hole _____

Abandoned _____

Form 252A 2M-9-19-CroMac.

Map No. _____ Sec. 4 Twp. 16 R. 5

Well No. 10 Tuckerman Farm

Empire G & T Co. Company

_____ Contractor


NW Quarter

_____ Ft. from N. Lice

1060 Ft. from S. Line

660' Ft. from E. Line

_____ Ft. from W. Line

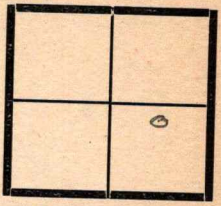

Date	REPORT
10/11	Drlg. 560
11/1/19	2525-2557'- 5 Bbls.

COMPLETED COMPLETED COMPLETED


Form 26—1M Books of 100 Sheets Each—4-15-18

Map No. K14 Sec. 4 Twp. 26 R. 5

Well No. 10 Fullerton

Empire Company

Contractor

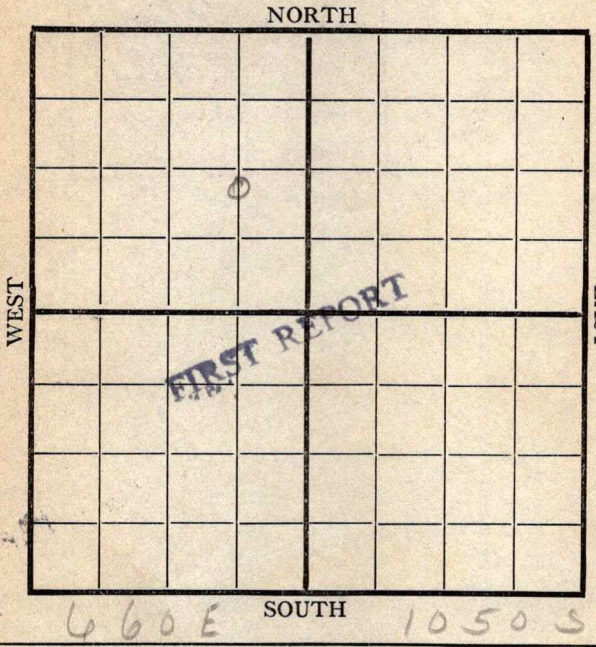

Location

Rig up

Drilling and Remarks:

560'

RECORD

Cased in., ft.

Sand

Gas

Oil

Total Depth

PRODUCTION

1st 24 hrs. Nat.

1st 24 hrs. after shot

Gas Cu. Ft.

Dry Hole

Abandoned

Date

6/3 191 9. Pyle Scout

Form 26—1M—4-19—Mid-West


Map No. K14 Sec. 4 Twp. 26 R. 5

Well No. 10 Fulkerson

Empire Company

Contractor

SECTION PLAT

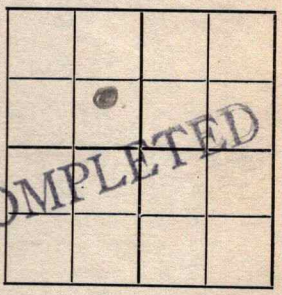

1050 Ft. from N. Line

Ft. from S. Line

660 Ft. from E. Line

Ft. from W. Line

Location

Rig up

Drilling and Remarks:

RECORD

Cased in., ft.

Sand 2525 - 2557

Gas

Oil

Total Depth

PRODUCTION

1st 24 hrs. Nat. 5 bbls

1st 24 hrs. after shot

Gas Cu. Ft.

Dry Hole

Abandoned

Date

1/2 1919

Pyle Scout