


Section 20 Township 26 Range 5E

Well No. #143 Koogler

Company Cities Seryice Oil

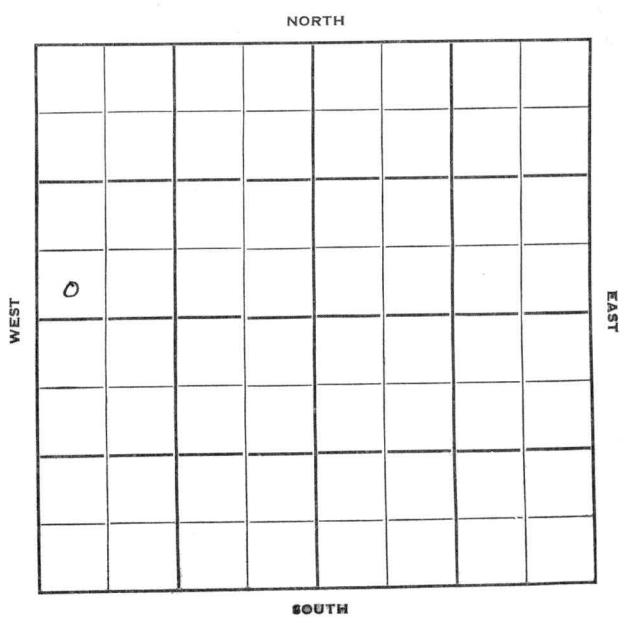

Butler

KANSAS

Sec. 20 Twp. 26 R. 5E ✓

Well No. #143 Koogler Farm

Cities Service Oil Company

El Dorado Contractor


 Ft. from N. Line

330' Ft. from S. Line

 Ft. from E. Line

330' Ft. from W. Line

SW SW NW

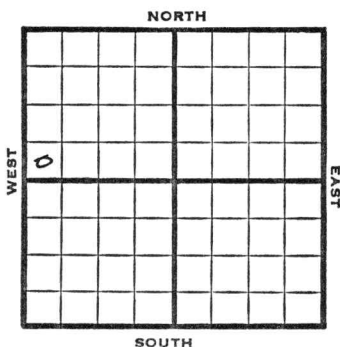

1951

Elev. 1341'

REPORT

10/17

8" @ 86'

Drlg. 1146'

11/21

Spud -

Oil Well TD 2603

8" @ 86

Viola 2535 Simp. 2563

5" @ 2566 TD 2603

87/ 2535-57 1000 A

Comp. 45 BOPD 331 BW

COMPLETED

County **Butler** State **Kansas**Sec. **20** (Blk. Twp.) **26** (Sur. Rge.) **5E** Map No.Operator **Cities Service Oil**Well No. **143** Farm **Koogler**Elev. Location **SW SW NW**

FIRST REPORT							
0							

330 Ft. From **S** Line **NW**330 Ft. From **W** Line Quarter1st. Report **OCT 17 1951**


Completion

Remarks

Spudding Date

Drlg. Data **El Dorado****8" @ 86' Drlg. 1146**

J. E. TYRA

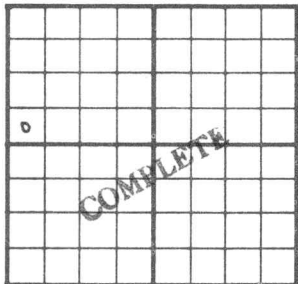County Butler State KansasSec. 20 (Blk.
Twp.) 26 (Sur.
Rge.) 5E Map No. _____Operator Cities Service OilWell No. 143 Farm KooglerElev. 1341 Location SW SW NW330 Ft. From S Line NW330 Ft. From W Line Quarter

1st. Report _____

Completion NOV 21 1951Remarks Eldorado Pool

Spudding Date _____

Drlg. Data Oil well TD 26038" @ 86 Viola 2535 Simp. 25635" @ 2566 TD 2603 87/ 2535-571000 A Comp. 45 bopd 331 bw

J. E. TYRA