

Map No. _____ Sec. 4 Twp. 26 R. 5Well No. 4 - Fulkerson Farm_____Empire Company

NORTH

WEST

EAST

SOUTH

COMPLETED

Location _____

Rig Up _____

Drilling Remarks:

Drilling Remarks:

RECORD

Cased _____ in. _____ ft.

Sand _____

Gas _____

Oil _____

Total Depth _____

PRODUCTION

1st 24 hrs. Nat. _____

1st 24 hrs. after shot _____

Gas _____ cu. ft

Dry Hole _____

Abandoned _____

Map No. 3 Sec. 4 Twp. 26 R. 5Well No. 21 Fulcrum Farm

Company

NORTH

WEST

EAST

FIRST REPORT

SOUTH

Location ✓Rig Up ✓

Drilling and remarks

FIRST REPORT

RECORD

Cased _____ in. _____ Ft.

Sand _____

Gas _____

Oil _____

Total Depth _____

PRODUCTION

1st 24 hrs. Nat. _____

1st 24 hrs. after shot _____

Gas _____ Cu. Ft.

Dry Hole _____


Abandoned _____

Date

8/8, 1917 Conley Scout

Map No. K-4 Sec. 4 Twp. No. 5
 Well No. 4 Lulkeson Farm
Empire Company

NORTH

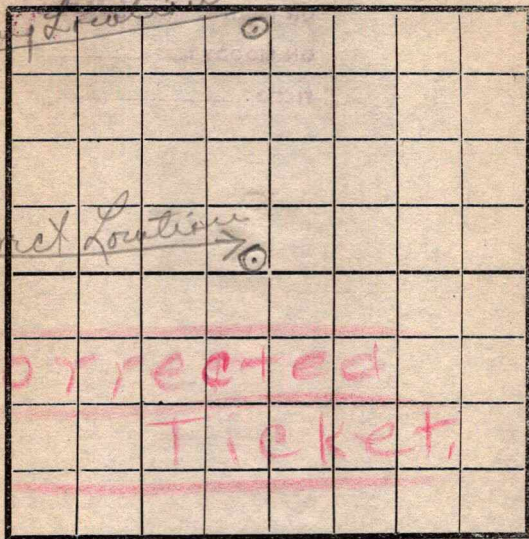

SOUTH

Location _____
 Rig Up ☒ _____
 Drilling and remarks _____

RECORD

Cased _____ in. _____ Ft.
 Sand _____
 Gas _____
 Oil _____
 Total Depth _____

PRODUCTION

1st 24 hrs. Nat. _____
 1st 24 hrs. after shot _____
 Gas _____ Cu. Ft.
 Dry Hole _____
 Abandoned _____

Date

8-23, 1917 Lantz Scout

Map No. _____ Sec. 4 Twp. 26 R. 5
Well No. * Fulcerson Farm
Empire Company
NORTH

WEST	40 your report				shows this as #4				EAST		
					OK						
					for #4						
	OK				Our map						
	Shows a #4 producing well here.										
Are there two #4 wells on this 160 acres											
								SOUTH			

Location _____
Rig Up _____
Drilling and remarks _____
Handwritten: OK

RECORD	
Cased _____ in.	_____ Ft.
Sand _____	
Gas _____	
Oil _____	
Total Depth _____	
PRODUCTION	
1st 24 hrs. Nat. _____	
1st 24 hrs. after shot _____	
Gas _____	Cu. Ft.
Dry Hole _____	
Abandoned _____	


Date _____, 191_____
Cardiff Scout

Map No. _____ Sec. 4 Twp. 26 R. 5
 Well No. 4 Fulsom Farm _____
Empire Company _____

NORTH

WEST

EAST

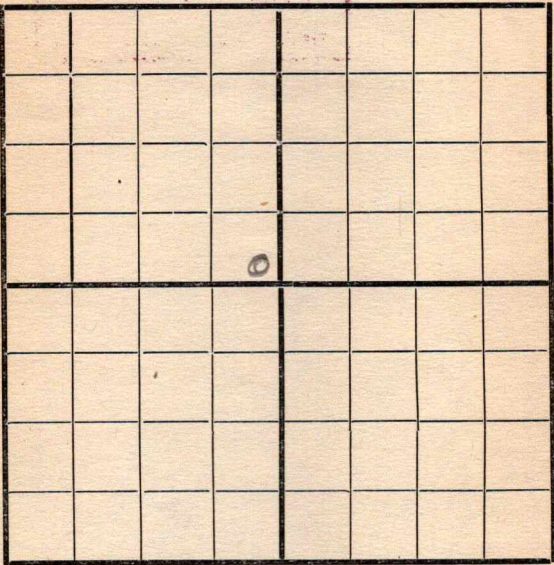

SOUTH

Location _____

Rig Up _____

Drilling and remarks

*Corrected
 location
 of 4 Fulsom*

RECORD

Cased _____ in. _____ Ft.

Sand _____

Gas _____

Oil _____

Total Depth _____

PRODUCTION

1st 24 hrs. Nat. _____

1st 24 hrs. after shot _____

Gas _____ Cu. Ft.

Dry Hole _____

Abandoned _____

Date

9/2, 191 7 *Cardiff*

1004 K14
 Map No. _____ Sec. 4 Twp. 26 R. 5
 Well No. 4 Fulcrum
Empire Company
 Contractor

NORTH

WEST

EAST

SOUTH

COMPLETED

Location _____

Rig up _____

Drilling and Remarks:

30 bbl

RECORD

Cased _____ in., _____ ft.

Sand 2520-2578

Gas _____

Oil _____

Total Depth _____

PRODUCTION

1st 24 hrs. Nat. _____

1st 24 hrs. after shot _____

Gas _____ Cu. Ft.

Dry Hole _____

Abandoned _____

Date

7/16

191

8Oyle

Scout