


Greenwood

KANSAS

Section 12 Township 26 Range 9E

Well Number #2 Christy

Company Katz Oil

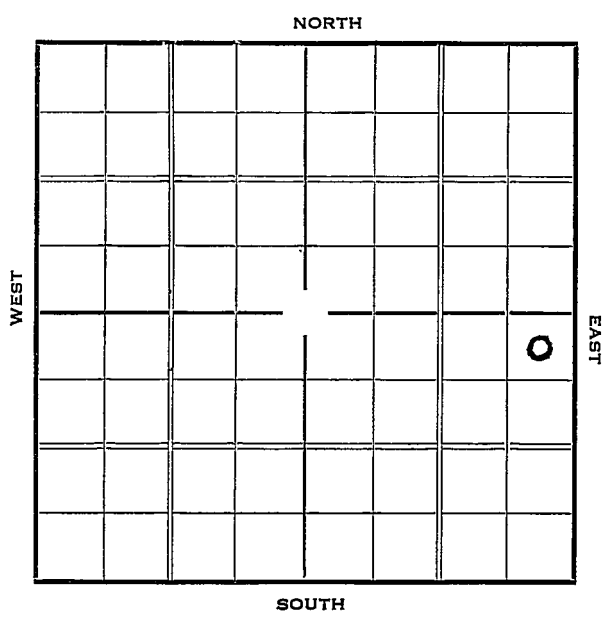

KANSAS

Greenwood

Map No. 15 Sec. 12 Twp. 26 R. 9 EWell No. 2 - ChristyKatz Oil Company

(Formerly - Lucille Oil Co. Contractor

FIRST REPORT

330 Ft. from N. Line

_____ Ft. from S. Line

330 Ft. from E. Line

_____ Ft. from W. Line

(We have no record of
This abd. well)

SECTION PLAT

			0

Location _____

Rig up _____

Drilling and Remarks:

OWDD -

QT. O. 740

Dig 1050

NO-RECORD

RECORD

Cased _____ in., _____ ft.

Sand _____

Gas _____

Oil _____

Total Depth _____

PRODUCTION

1st 24 hrs. Nat. _____

1st 24 hrs. after shot _____

Gas _____ Cu. Ft.

Dry Hole _____

Abandoned _____

Date

JUL 7 1937 19

H. D. Hatfield Scout

KANSAS *Greenwood*Map No. *15* Sec. *12* Twp. *26* R. *9 E*Well No. *2-Christy**Katz Oil* Company

Contractor

COMPLETED

SECTION PLAT

330 Ft. from N. Line*111* Ft. from S. Line*330* Ft. from E. Line

Ft. from W. Line

			0

Location

Rig up

Drilling and Remarks:

*OWDD - OTD 740**500 Acid**Per. 75'*

RECORD

Cased *5 in.* *1367* ft.Sand *K.C.* *1360*

Gas

Oil

Total Depth *1382*

PRODUCTION

1st 24 hrs. Nat.

1st 24 hrs. after shot

Gas Cu. Ft.

Dry Hole

Abandoned

Date

*AUG 11 1937**H. D. Hatfield*

Scout