


Section 12 Township 26 Range 9-E


Well No. 3 Christy

Company Katz Oil

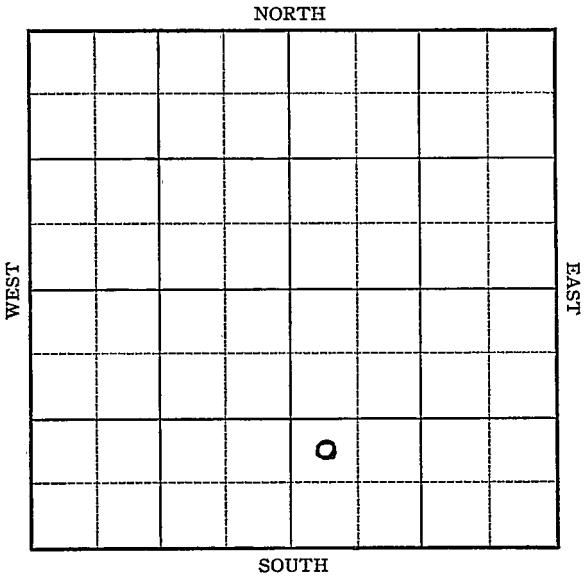

KANSAS

Greenwood

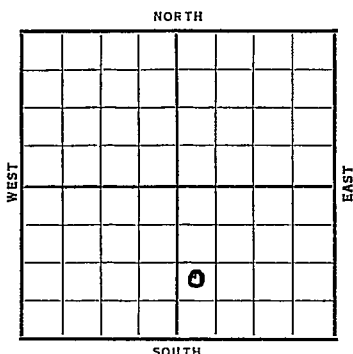Sec. 12 Twp. 26 R. 9-EWell No. #3 Christy FarmKatz Oil Company Ft. from N. Line990 Ft. from S. Line Ft. from E. Line330 Ft. from W. Line

Date	REPORT
1938	
1/26	Location
2/4	" "
2/11	" "
2/18	Drlg. 185'.
2/26	" "
3/4	12" @ 570'. Drlg. 700'.
3/11	10" @ 960'. Drlg. 1350'.
3/18	K.C.. 1313-1560'. Drlg. 2000'.
3/25	Miss. 2125'. S.O. 2125-34'.
	6" @ 2126'.
3/30	6" @ 2126'.
	Miss. 2125'.
	T.D. 2134'.
	25 oil.
	COMPLETED

Map No. 15 Sec. 12 Twp. 26 R. 9EWell No. 3 ChristyKatz Oil

Company

Contractor

FIRST REPORT

NW SW SE

 Ft. from N. Line990 Ft. from S. Line Ft. from E. Line330 Ft. from W. Line**SECTION PLAT**

		0	

Location XRig up

Drilling and Remarks:

RECORDCased in., ft.Sand Gas Oil Total Depth **PRODUCTION**1st 24 hrs. Nat. 1st 24 hrs. after shot Gas Cu. Ft.Dry Hole Abandoned

Date

JAN 26 193819H. D. Hatfield Scout

Greenwood KANSAS

Map No. 15 Sec. 12 Twp. 26 R. 9EWell No. 3 ChristyKatz Oil Company

Contractor

COMPLETED

NW SW SE

Ft. from N. Line

990 Ft. from S. Line

Ft. from E. Line

330 Ft. from W. Line

SECTION PLAT

		0	

Location _____

Rig up _____

Drilling and Remarks:

25 oil

RECORD

Cased 6 in., 2126 ft.Sand MISS 2125

Gas _____

Oil _____

Total Depth 2134

PRODUCTION

1st 24 hrs. Nat. _____

1st 24 hrs. after shot _____

Gas _____ Cu. Ft.

Dry Hole _____

Abandoned _____

Date

MAR 30 1938

19

H. D. Hatfield Scout