

Map No. 4 Sec. 26 Twp. 5 R. _____Well No. 6 millhausen Farm _____British - Am Company _____

NORTH

WEST

EAST



SOUTH

Location _____

Rig Up _____

Drilling Remarks:

Drilling Remarks:

850 = 12/111060 = 12/181050 = 12/28 =1570 = 1/111900 = 1/8/172100 = 1/15

RECORD

Cased _____ in _____ Ft.

Sand _____

Gas _____

Oil _____

Total Depth _____

PRODUCTION

1st 24 hrs. Nat. _____

1st 24 hrs. after shot _____


Gas _____ Cu. Ft.

Dry Hole _____

Abandoned _____

Map No. _____ Sec. 4 Twp. 26 R. 5
 Well No. 6 Willhisen Farm _____
British-American Company

NORTH

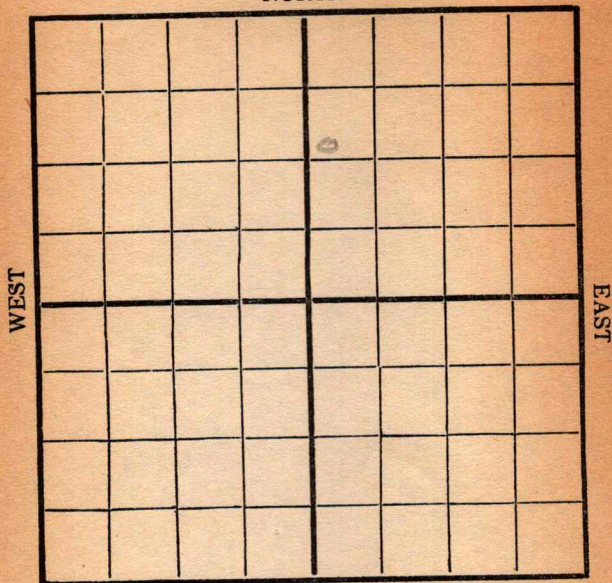

SOUTH

Location _____

Rig Up _____

Drilling and remarks

Rigging up

RECORD

Cased _____ in. _____ Ft.

Sand _____

Gas _____

Oil _____

Total Depth _____

PRODUCTION

1st 24 hrs. Nat. _____

1st 24 hrs. after shot _____

Gas _____ Cu. Ft.

Dry Hole _____


Abandoned _____

Date

11/22 191 6 *Carley* Scout

Map No. _____ Sec. 4 Twp. 26 R. 5
 Well No. 6 McIlheiser Farm
British American Company

NORTH

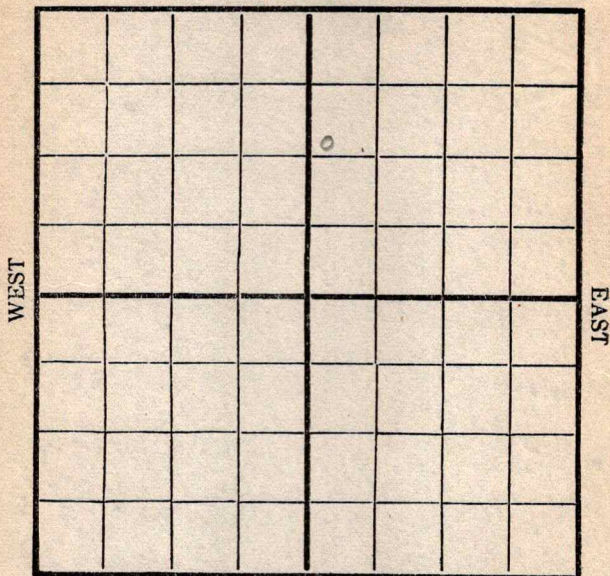

SOUTH

Location _____

Rig Up _____

Drilling and remarks

250

RECORD

Cased _____ in. _____ Ft.

Sand _____

Gas _____

Oil _____

Total Depth _____

PRODUCTION

1st 24 hrs. Nat. _____

1st 24 hrs. after shot _____

Gas _____ Cu. Ft.

Dry Hole _____


Abandoned _____

Date

12/4, 1916, Cordell Scout

Map No. _____ Sec. 4 Twp. 26 R. 5Well No. 6 Millheiser FarmBritish-American Company

NORTH

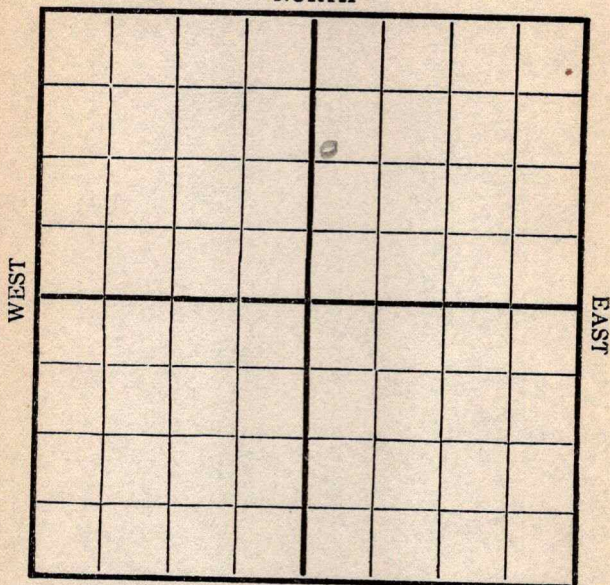

SOUTH

Location _____

Rig Up _____

Drilling and remarks

850'

RECORD

Cased _____ in. _____ Ft.

Sand _____

Gas _____

Oil _____

Total Depth _____

PRODUCTION

1st 24 hrs. Nat. _____

1st 24 hrs. after shot _____

Gas _____ Cu. Ft.

Dry Hole _____


Abandoned _____

Date

12/11, 1916, Cordell Scout

Map No. _____ Sec. 4 Twp. 26 R. 5
Well No. 6 Muller Farm
British-American Company

NORTH

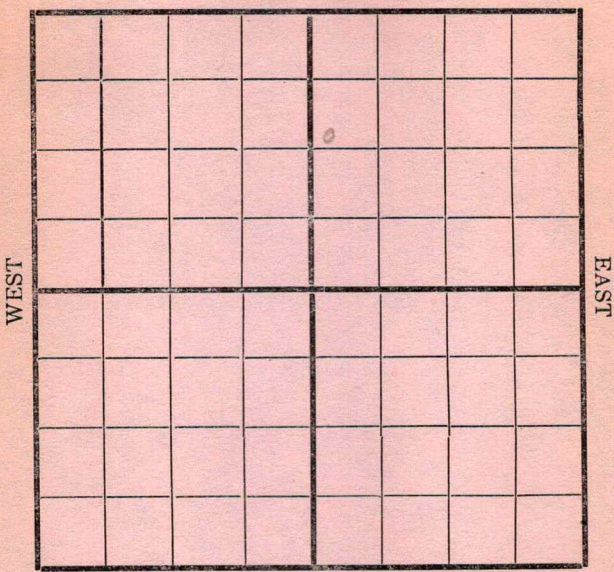

SOUTH

Location _____
Rig Up _____
Drilling and remarks

1000

RECORD

Cased _____ in. _____ Ft.
Sand _____
Gas _____
Oil _____
Total Depth _____

PRODUCTION

1st 24 hrs. Nat. _____
1st 24 hrs. after shot _____
Gas _____ Cu. Ft.
Dry Hole _____
Abandoned _____

Date 12/18, 1916 C. Muller Scout

Map No. _____ Sec. 4 Twp. 26 R. 5
 Well No. 6 Willhess Farm
British - American Company

NORTH

WEST

EAST

SOUTH

Location _____
 Rig Up _____
 Drilling and remarks _____

RECORD

Cased _____ in. _____ Ft.
 Sand _____
 Gas _____
 Oil _____
 Total Depth _____

PRODUCTION

1st 24 hrs. Nat. _____
 1st 24 hrs. after shot _____
 Gas _____ Cu. Ft.
 Dry Hole _____
 Abandoned _____


Date

11/20 1916 C. C. C. C. Scout

Map No. _____ Sec. 4 Twp. 26 R. 5

Well No. 6 Millheiser Farm

B-a Company

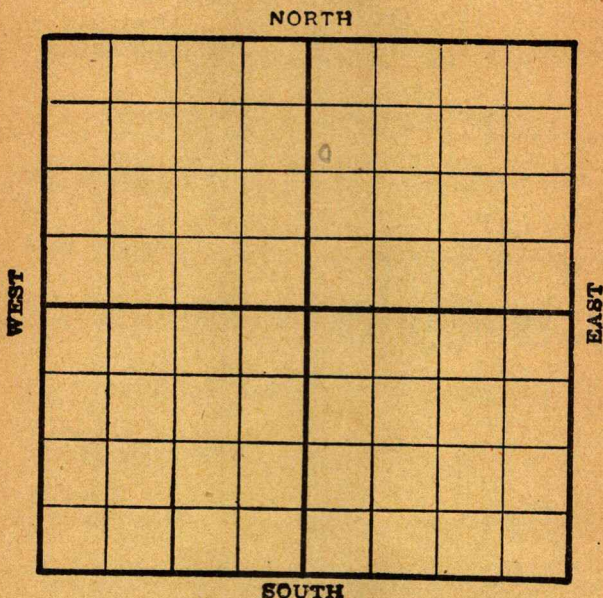

Location _____

Rig up _____

Drilling and remarks

*Shut Down
1050*

RECORD

Cased _____ in. _____ Ft.

Sand _____

Gas _____

Oil _____

Total Depth _____

PRODUCTION

1st. 24 hrs. Nat. _____

1st 24 hrs. after shot _____

Gas _____ Cu. Ft.

Dry Hole _____


Abandoned _____

Date

10/28, 1916, C. C. C. Co. Scout

Map No. _____ Sec. 4 Twp. 26 R. 5
 Well No. 6 Miller Farm _____
13 _____ Company _____

NORTH

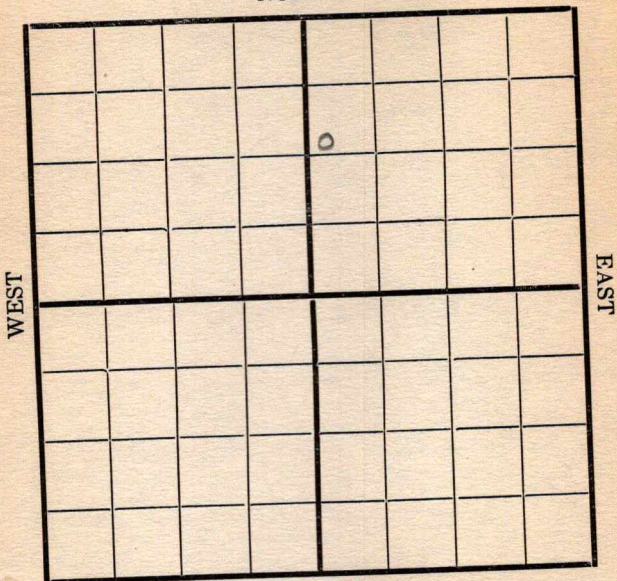

SOUTH

RECORD

Location _____
 Rig Up _____
 Drilling and remarks _____

Cased _____ in. _____ Ft.
 Sand _____
 Gas _____
 Oil _____
 Total Depth _____

1570

PRODUCTION


1st 24 hrs. Nat. _____
 1st 24 hrs. after shot _____
 Gas _____ Cu. Ft.
 Dry Hole _____
 Abandoned _____

Date

1/1, 1912 Carly Scout

Map No. _____ Sec. 4 Twp. 26 R. 5
 Well No. 6 McIlhaisen Farm
British American Company

NORTH

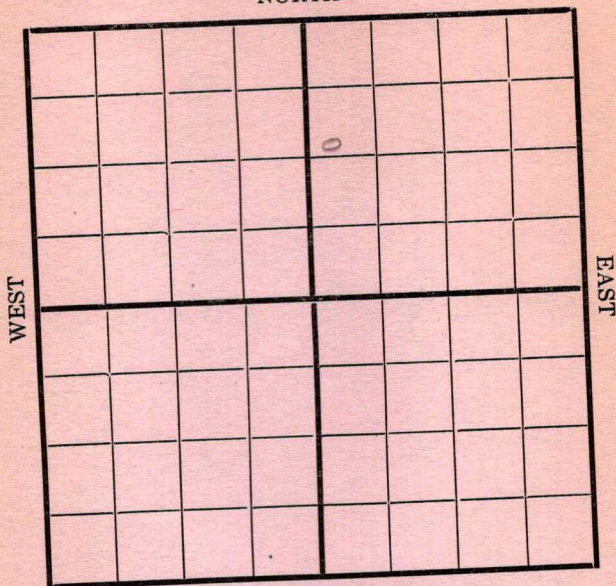

SOUTH

Location _____

Rig Up _____

Drilling and remarks

1900'

RECORD

Cased _____ in. _____ Ft.

Sand _____

Gas _____

Oil _____

Total Depth _____

PRODUCTION

1st 24 hrs. Nat. _____

1st 24 hrs. after shot _____

Gas _____ Cu. Ft.

Dry Hole _____


Abandoned _____

Date

1/8, 1917 Cardiff Scout

Map No. _____ Sec. 4 Twp. 26 R. 5
 Well No. 6 Miller Farm _____
13 _____ Company

NORTH

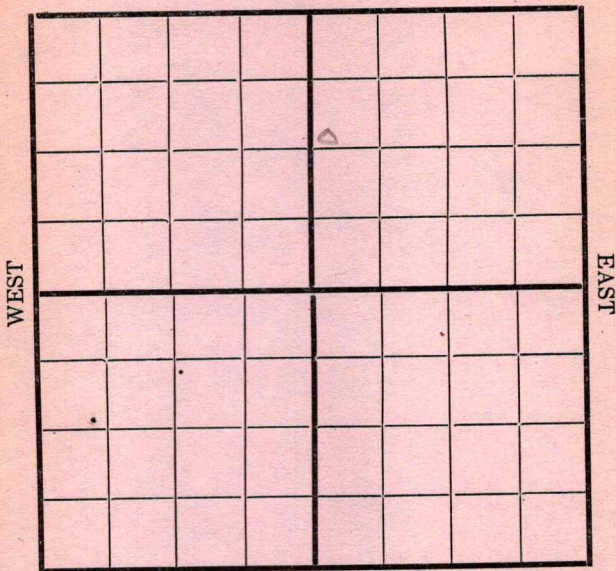

SOUTH

Location _____

Rig Up _____

Drilling and remarks

RECORD

Cased _____ in. _____ Ft.

Sand _____

Gas _____

Oil _____

Total Depth _____

PRODUCTION

1st 24 hrs. Nat. _____

1st 24 hrs. after shot _____

Gas _____ Cu. Ft.

Dry Hole _____

Abandoned _____

Date


1/15, 1917 Cardiff Scout

Map No. _____ Sec. 4 Twp. 26 R. 5
 Well No. 6 Willhisen Farm _____
British-American Company

NORTH

WEST

EAST

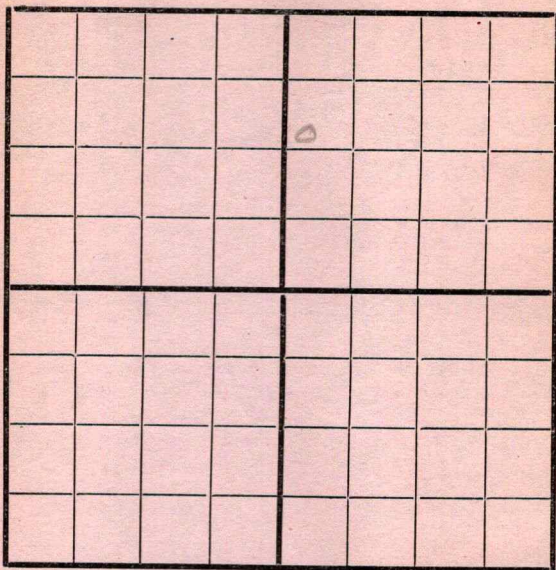

SOUTH

Location _____
 Rig Up _____
 Drilling and remarks

2300'

RECORD

Cased _____ in. _____ Ft.
 Sand _____
 Gas _____
 Oil _____
 Total Depth _____

PRODUCTION

1st 24 hrs. Nat. _____
 1st 24 hrs. after shot _____
 Gas _____ Cu. Ft.
 Dry Hole _____
 Abandoned _____


Date

1/22, 1917

Condit Scout

Map No. _____ Sec. 4 Twp. 26 R. 5
 Well No. 6 McIlhenny Farm
British American Company

NORTH

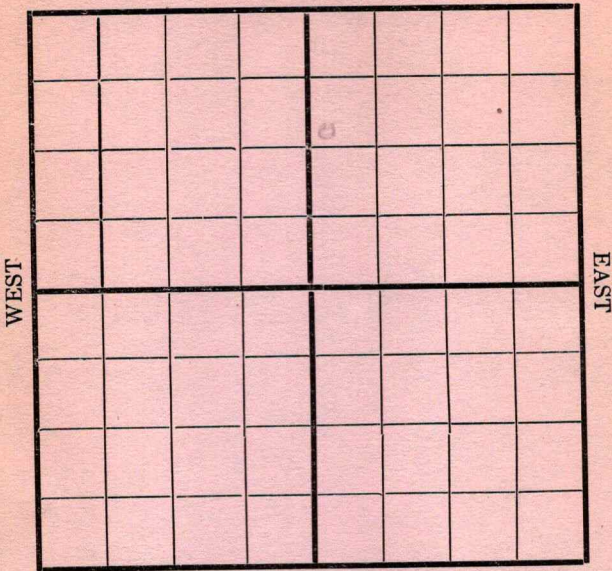

SOUTH

Location _____
 Rig Up _____
 Drilling and remarks _____

Shut Down
2300

RECORD

Cased _____ in. _____ Ft.
 Sand _____
 Gas _____
 Oil _____
 Total Depth _____

PRODUCTION

1st 24 hrs. Nat. _____
 1st 24 hrs. after shot _____
 Gas _____ Cu. Ft.
 Dry Hole _____
 Abandoned _____

Date

129, 1912 Candy Scout

Map No. _____ Sec. 4 Twp. 26 R. 5
Well No. 6 McClhain Farm
British American Company

NORTH

WEST

EAST

SOUTH

Location _____

Rig Up _____

Drilling and remarks

*Shut down
2300'*

RECORD

Cased _____ in. _____ Ft.

Sand _____

Gas _____

Oil _____

Total Depth _____

PRODUCTION

1st 24 hrs. Nat. _____

First 24 hrs. after shot _____

Gas _____ Cu. Ft.

Dry Hole _____


Abandoned _____

Date

2/5, 1917 *Cond* Scout

Map No. _____ Sec. 4 Twp. 26 R. 5
 Well No. 6 Miller Farm _____
British American Company

NORTH

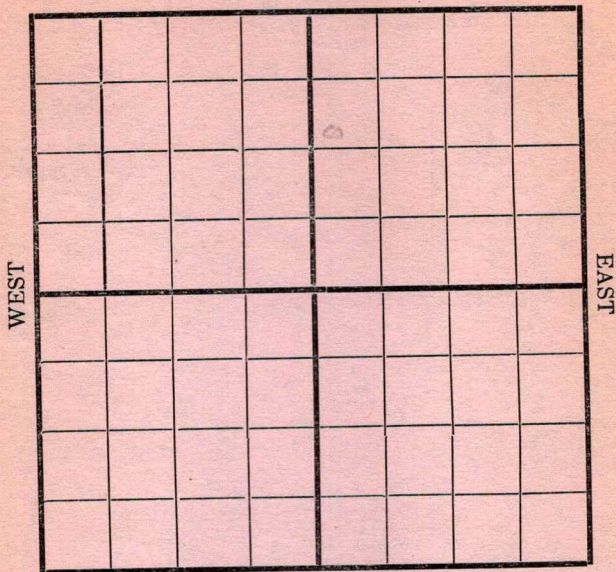

SOUTH

Location _____
 Rig Up _____
 Drilling and remarks

2430

RECORD

Cased _____ in. _____ Ft.
 Sand _____
 Gas _____
 Oil _____
 Total Depth _____

PRODUCTION

1st 24 hrs. Nat. _____
 1st 24 hrs. after shot _____
 Gas _____ Cu. Ft.
 Dry Hole _____
 Abandoned _____

Date

2/2, 1912 Candiff Scout

Map No. ^{L1004} 214 Sec. 4 Twp. 26 R. 5
 Well No. 6 Miller Farm
British American Company

NORTH

WEST

EAST

COMPLETED

SOUTH

Location

Rig Up

Drilling and remarks

Est at
 300
 Bbls

RECORD

Cased in. Ft.

Sand 2545-2560

Gas

Oil

Total Depth

PRODUCTION

1st 24 hrs. Nat.

First 24 hrs. after shot

Gas Cu. Ft.

Dry Hole

Abandoned

Date

2/22 191 7 C. D. J. Scout