

Map No. 4 Sec. 4 Twp. 26 R. 5Well No. 2-Mullheiser FarmBritish American Company

Eldorado NORTH COG

WEST

EAST

SOUTH

Location _____

Rig Up 1-8-17

Drilling Remarks:

R-1/15-

Drilling Remarks:

RECORD

Cased _____ in _____ Ft.

Sand _____

Gas _____

Oil _____

Total Depth _____

PRODUCTION

1st 24 hrs. Nat. _____


1st 24 hrs. after shot _____

Gas _____ Cu. Ft.

Dry Hole _____

Abandoned _____

Map No. _____ Sec. 4 Twp. 26 R. 5
 Well No. 9 million Farm _____
13 - a Company _____

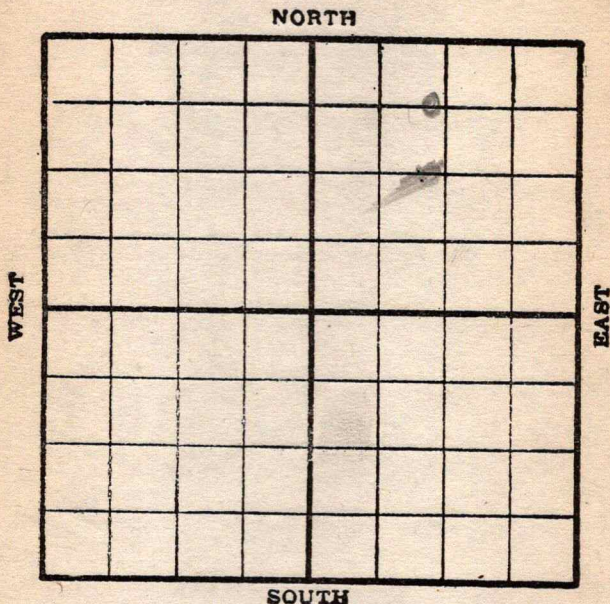

Location _____
 Rig up ☒ _____
 Drilling and remarks: _____

RECORD

Cased _____ in. _____ Ft.
 Sand _____
 Gas _____
 Oil _____
 Total Depth _____

PRODUCTION


1st. 24 hrs. Nat. _____
 1st. 24 hrs. after shot _____
 Gas _____ Cu. Ft.
 Dry Hole _____
 Abandoned _____

Date 1/8, 1917, C. O. D. Scout

Map No. _____ Sec. 4 Twp. 26 R. 5
 Well No. 9 Millhiser Farm
13 am Company

NORTH

WEST

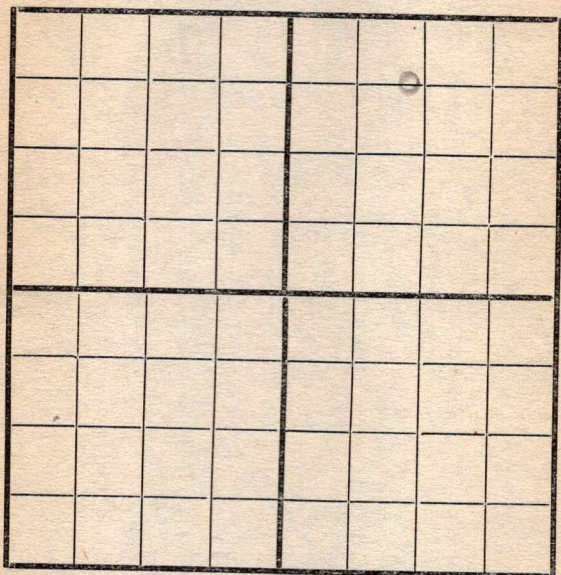

EAST

SOUTH

Location _____
 Rig Up _____
 Drilling and remarks _____

RECORD

Cased _____ in. _____ Ft.
 Sand _____
 Gas _____
 Oil _____
 Total Depth _____

PRODUCTION

1st 24 hrs. Nat. _____
 1st 24 hrs. after shot _____
 Gas _____ Cu. Ft.
 Dry Hole _____
 Abandoned _____

Date


1/15, 1919 Carroll Scout

Map No. _____ Sec. 4 Twp. 26 R. 5
 Well No. 9 Miller Farm _____
British-American Company

NORTH

WEST

EAST

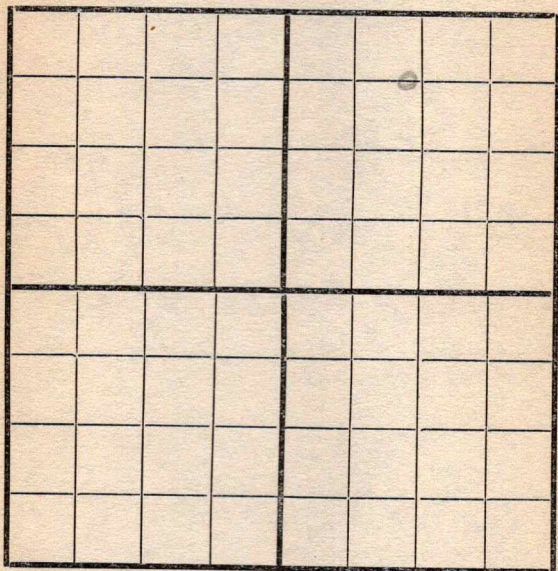

SOUTH

Location _____
 Rig Up _____
 Drilling and remarks _____

RECORD

Cased _____ in. _____ Ft.
 Sand _____
 Gas _____
 Oil _____
 Total Depth _____

PRODUCTION

1st 24 hrs. Nat. _____
 1st 24 hrs. after shot _____
 Gas _____ Cu. Ft.
 Dry Hole _____
 Abandoned _____

Date

191

Scout

Map No. _____ Sec. 4 Twp. 36 R. 5
 Well No. 9 Millchinn Farm _____
Brittania Petroleum Company

NORTH

WEST

EAST

SOUTH

Location _____
 Rig Up ☒ _____
 Drilling and remarks _____

RECORD

Cased _____ in. _____ Ft.
 Sand _____
 Gas _____
 Oil _____
 Total Depth _____

PRODUCTION

1st 24 hrs. Nat. _____
 1st 24 hrs. after shot _____
 Gas _____ Cu. Ft.
 Dry Hole _____
 Abandoned _____


Date

1/29, 1917 Cordell Scout

Map No. _____ Sec. 4 Twp. 26 R. 5
 Well No. 9 Muller Farm
British-American Company

NORTH

WEST

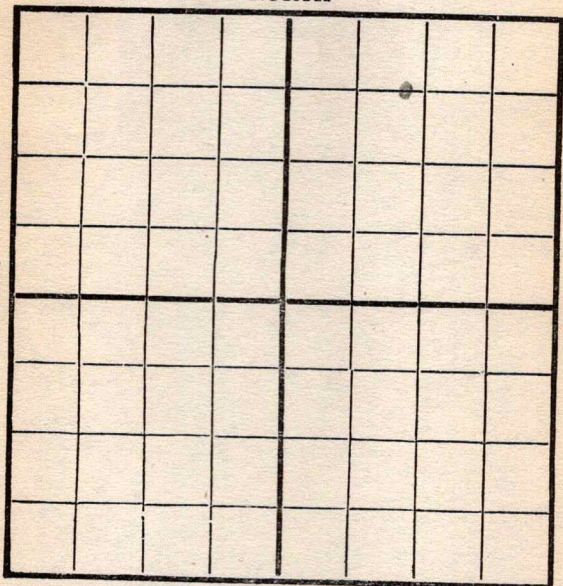

EAST

SOUTH

Location _____
 Rig Up ☒ _____
 Drilling and remarks _____

RECORD

Cased _____ in. _____ Ft.
 Sand _____
 Gas _____
 Oil _____
 Total Depth _____

PRODUCTION


1st 24 hrs. Nat. _____
 First 24 hrs. after shot _____
 Gas _____ Cu. Ft.
 Dry Hole _____
 Abandoned _____

Date

2/5, 1917 Condy Scout

Map No. _____ Sec. 4 Twp. 26 R. 5Well No. 9 Miller's FarmBritish-American Company

NORTH

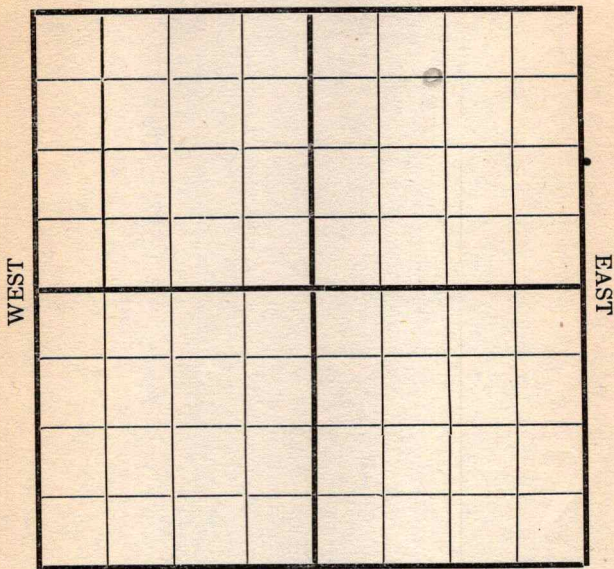

SOUTH

Location ✓Rig Up ✓

Drilling and remarks

RECORD

Cased _____ in. _____ Ft.

Sand _____

Gas _____

Oil _____

Total Depth _____

PRODUCTION

1st 24 hrs. Nat. _____

1st 24 hrs. after shot _____

Gas _____ Cu. Ft.

Dry Hole _____

Abandoned _____


Date

2/12, 1917 Cordell Scout

Map No. _____ Sec. 4 Twp. 26 R. 5
 Well No. 9 Millhiser Farm
British-American Company

NORTH

WEST

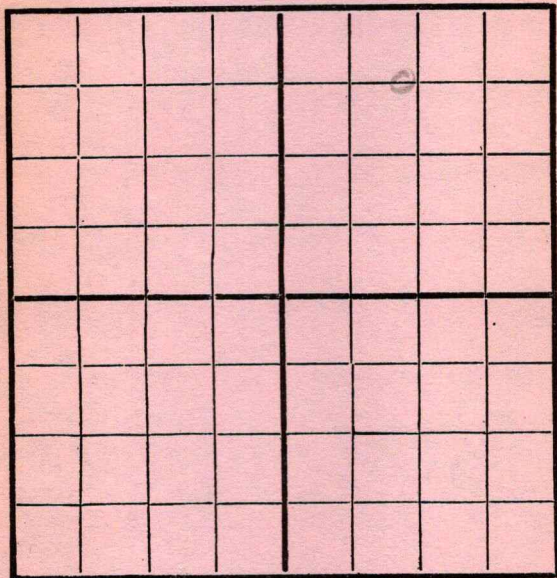

EAST

SOUTH

RECORD

Location _____

Rig Up _____

Drilling and remarks _____

Cased _____ in. _____ Ft.

Sand _____

Gas _____

Oil _____

Total Depth _____

PRODUCTION

1st 24 hrs. Nat. _____

1st 24 hrs. after shot _____

Gas _____ Cu. Ft.

Dry Hole _____

Abandoned _____

Date

4/19, 1917

Scout

Map No. _____ Sec. 4 Twp. 36 R. 5
 Well No. 9 Mullheiser Farm _____
British American Company

NORTH

WEST

EAST

SOUTH

Location _____

Rig Up ✓ _____

Drilling and remarks _____

RECORD

Cased _____ in. _____ Ft.

Sand _____

Gas _____

Oil _____

Total Depth _____

PRODUCTION

1st 24 hrs. Nat. _____

First 24 hrs. after shot _____

Gas _____ Cu. Ft.

Dry Hole _____

Abandoned _____


Date

Feb 6 1917 Cardiff Scout

Map No. _____ Sec. 4 Twp. 26 R. 5

Well No. 9 Milligan Farm
British-American Company

NORTH

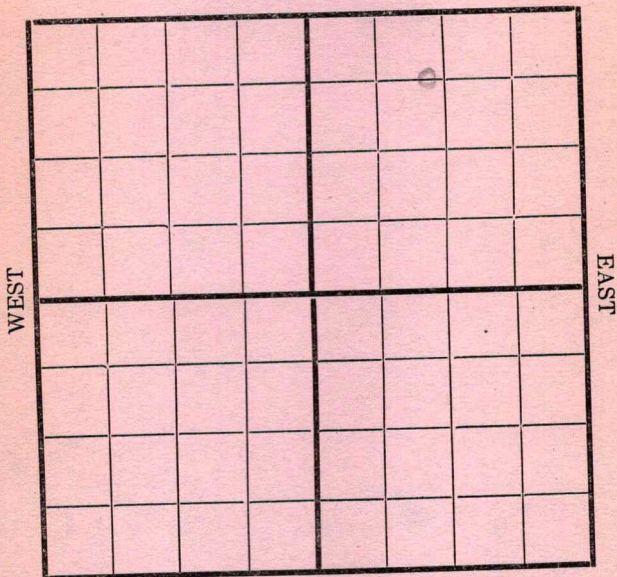

SOUTH

RECORD

Location _____
 Rig Up _____
 Drilling and remarks _____

Cased _____ in. _____ Ft.
 Sand _____
 Gas _____
 Oil _____
 Total Depth _____

PRODUCTION


1st 24 hrs. Nat. _____
 1st 24 hrs. after shot _____
 Gas _____ Cu. Ft.
 Dry Hole _____
 Abandoned _____

Date

3/5, 1917 Co. 2/5 Scout

Map No. _____ Sec. 4 Twp. 26 R. 5
Well No. 9 Willhiser Farm
British American Company

NORTH

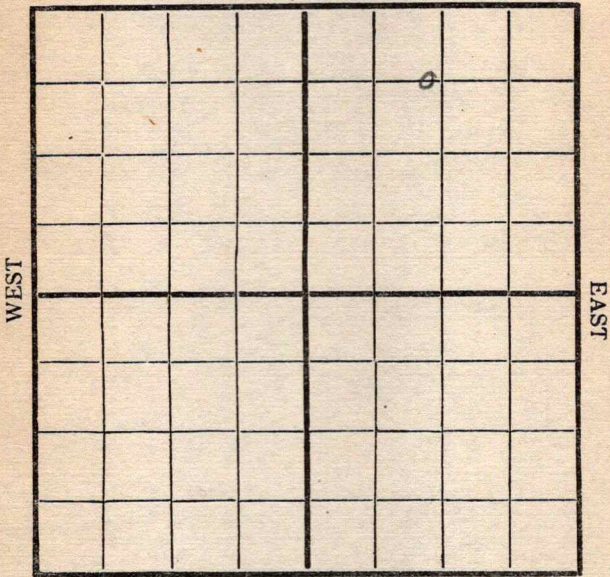

SOUTH

REMARKS:


Spudding

Date

3/12, 1912 Condy Scout

Map No. _____ Sec. 4 Twp. 26 R. 5
 Well No. 9 Millheiser Farm
British-American Company

NORTH

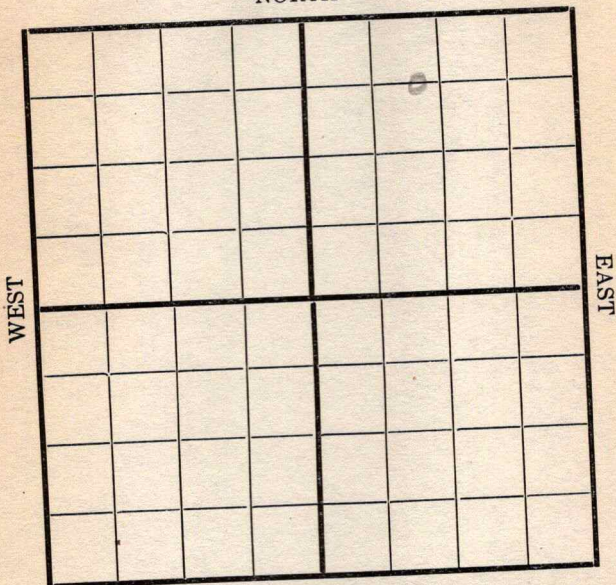

SOUTH

Location _____

Rig Up _____

Drilling and remarks

Spud drill

RECORD

Cased _____ in. _____ Ft.

Sand _____

Gas _____

Oil _____

Total Depth _____

PRODUCTION

1st 24 hrs. Nat. _____

1st 24 hrs. after shot _____

Gas _____ Cu. Ft.


Dry Hole _____

Abandoned _____

Date

3/21, 1917 *Carney* Scout

Map No. _____ Sec. 4 Twp. 36 R. 5
 Well No. 9 Millhiser Farm
British American Company

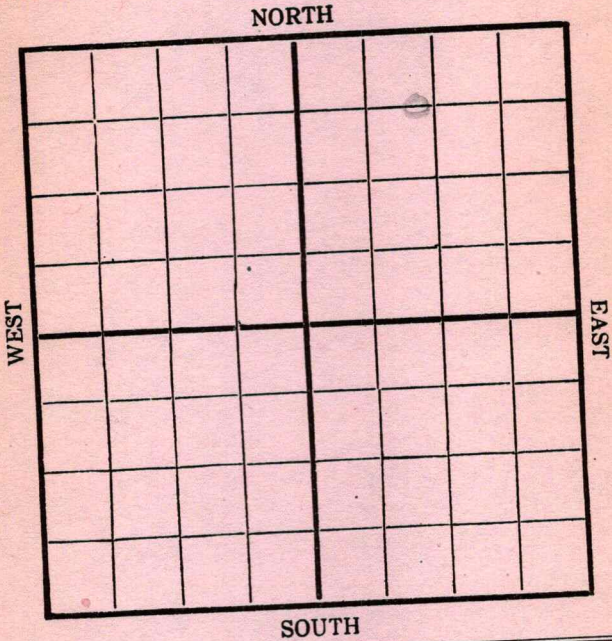

	RECORD
Location _____	Cased _____ in. _____ Ft.
Rig Up _____	Sand _____
Drilling and remarks	Gas _____
<i>Spindled in</i>	Oil _____
	Total Depth _____
	PRODUCTION
	1st 24 hrs. Nat. _____
	1st 24 hrs. after shot _____
	Gas _____ Cu. Ft.
	Dry Hole _____
	Abandoned _____


Date 3/26, 1917 Condy Scout

Map No. _____ Sec. 4 Twp. 26 R. 5
 Well No. 9 Millhouse Farm
British American Company

NORTH

WEST

EAST

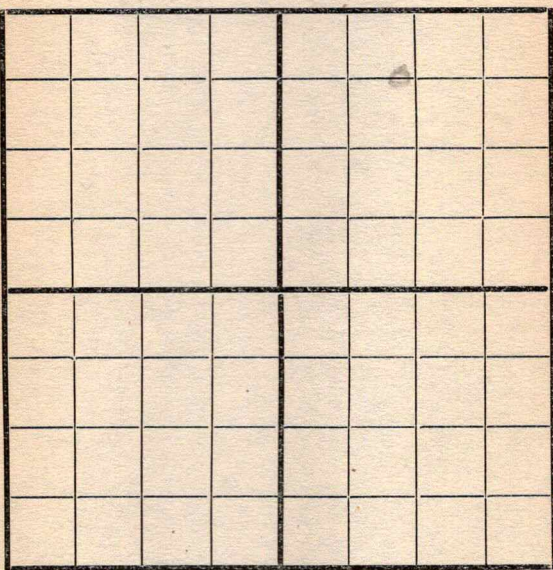

SOUTH

Location _____
 Rig Up _____
 Drilling and remarks _____

Shut Down

RECORD

Cased _____ in. _____ Ft.
 Sand _____
 Gas _____
 Oil _____
 Total Depth _____

PRODUCTION


1st 24 hrs. Nat. _____
 1st 24 hrs. after shot _____
 Gas _____ Cu. Ft.
 Dry Hole _____
 Abandoned _____

Date

4/5, 191 7 *Carney* Scout

Map No. _____ Sec. 4 Twp. 26 R. 5
Well No. 9 Millheiser Farm
British American Company

NORTH

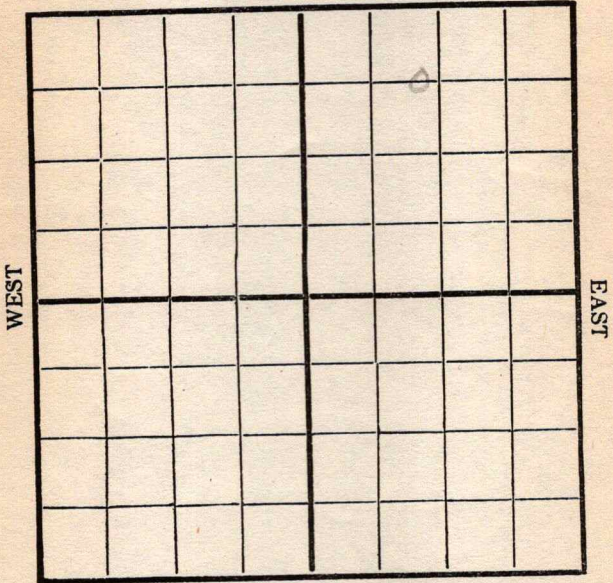

SOUTH

Location _____
Rig Up ☒ _____
Drilling and remarks _____

RECORD

Cased _____ in. _____ Ft.
Sand _____
Gas _____
Oil _____
Total Depth _____


PRODUCTION

1st 24 hrs. Nat. _____
1st 24 hrs. after shot _____
Gas _____ Cu. Ft.
Dry Hole _____
Abandoned _____

Date 4/11, 1917 Cord Scout

Map No. _____ Sec. 4 Twp. 26 R. 5
Well No. 9 Muller Farm
British-American Company

NORTH

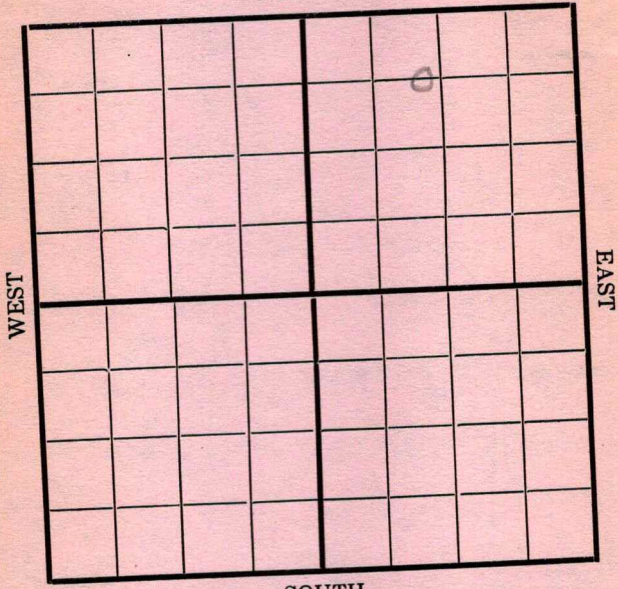

SOUTH

Location _____
Rig Up _____
Drilling and remarks

500'

RECORD

Cased _____ in. _____ Ft.
Sand _____
Gas _____
Oil _____
Total Depth _____


PRODUCTION

1st 24 hrs. Nat. _____
1st 24 hrs. after shot _____
Gas _____ Cu. Ft.
Dry Hole _____
Abandoned _____

Date 4/19, 1917 Condit Scout

Map No. _____ Sec. 4 Twp. 26 R. 5
 Well No. 9 Miller Farm
British American Company

NORTH

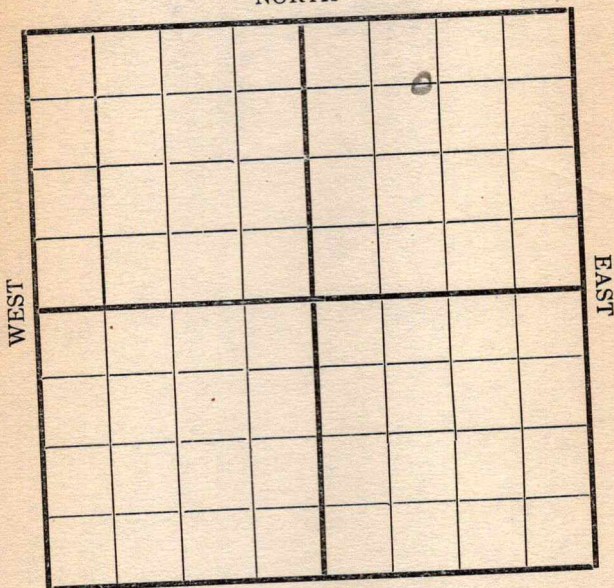

SOUTH

RECORD

Location _____
 Rig Up _____
 Drilling and remarks

Cased _____ in. _____ Ft.
 Sand _____
 Gas _____
 Oil _____
 Total Depth _____

740

PRODUCTION

1st 24 hrs. Nat. _____
 1st 24 hrs. after shot _____
 Gas _____ Cu. Ft.
 Dry Hole _____
 Abandoned _____

Date

APR 26 1917


191

Condy

Scout

Map No. _____ Sec. 4 Twp. 26 R. 5
 Well No. 9 Millheiser Farm _____
British American Company

NORTH

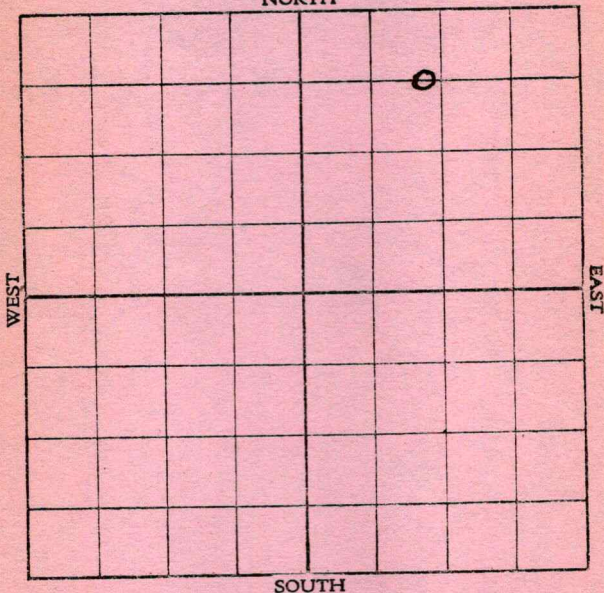

SOUTH

Location _____

Rig up _____

Drilling and remarks:

D. - 1000'

RECORD

Cased _____ in. _____ Ft.

Sand _____

Gas _____

Oil _____

Total Depth _____

PRODUCTION

1st 24 hrs. Nat. _____

1st 24 hrs. after shot _____

Gas _____ Cu. Ft.

Dry Hole _____

Abandoned _____

Date

5/5, 1917, Scout

Map No. _____ Sec. 4 Twp. 24 R. 5
 Well No. 4 Millheiser Farm _____
El Dorado O. & G. Company _____
 NORTH

WEST EAST

The no. and name
 of company has
 been changed.
 on this lease.
 No. 4 British American

SOUTH

Location _____

Rig up _____

Drilling and remarks:

D. 2205'

RECORD

Cased _____ in. _____ Ft.

Sand _____

Gas _____

Oil _____

Total Depth _____

PRODUCTION

1st 24 hrs. Nat. _____

1st 24 hrs. after shot _____

Gas _____ Cu. Ft.


Dry Hole _____

Abandoned _____

Date

5/12, 1917, Crocker Scout

Map No. _____ Sec. 4 Twp. 26 R. 5
 Well No. 4 Millhiser Farm
El Dorado O. & G. Company
 NORTH

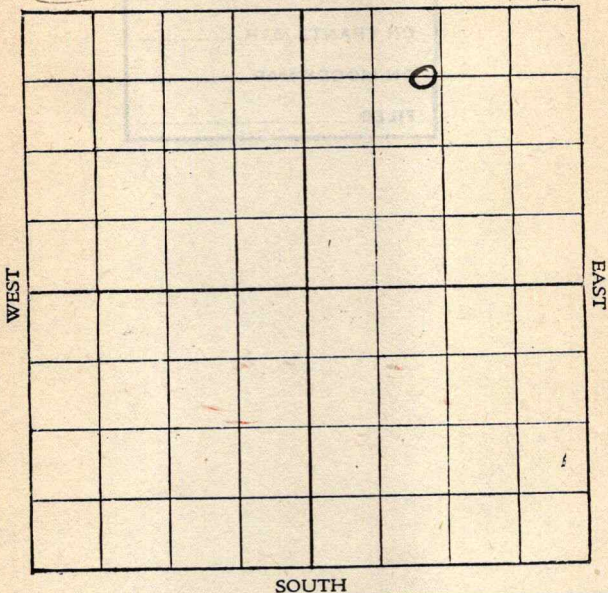

Location _____

Rig up _____

Drilling and remarks:

D-2285'

RECORD

Cased _____ in. _____ Ft.

Sand _____

Gas _____

Oil _____

Total Depth _____

PRODUCTION

1st 24 hrs. Nat. _____

1st 24 hrs. after shot _____

Gas _____ Cu. Ft.

Dry Hole _____

Abandoned _____


Date

5/19/17, Procter Scout

Map No. _____ Sec. 4 Twp. 26 R. _____

Well No. 4 Millheiser
Eldorado O. & G.

NORTH

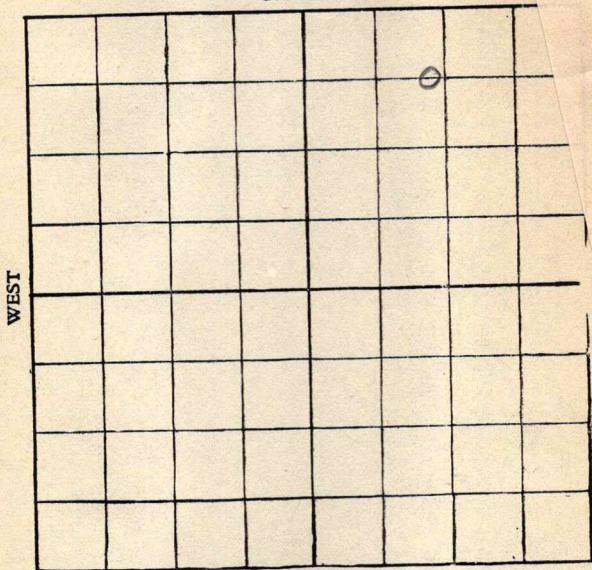

SOUTH

Location _____

Rig up _____

Drilling and remarks:

Fish 2500'

RECORD

Cased _____ in. _____ Ft.

Sand _____

Gas _____

Oil _____

Total Depth _____

PRODUCTION

1st 24 hrs. Nat. _____

1st 24 hrs. after shot _____

Gas _____ Cu. Ft.

Dry Hole _____


Abandoned _____

Date

5/26, 1917, Crocker Scout

Map No. Sec. 4 Twp. 26 R. 5Well No. 4 Millheiser FarmEl Dorado O. & G. Company

NORTH

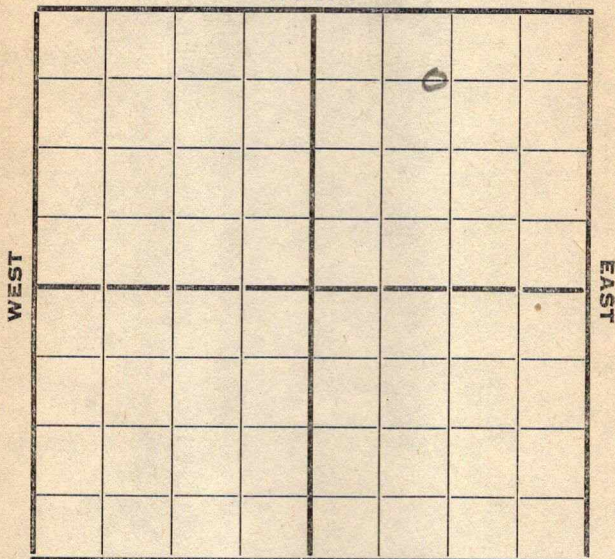

SOUTH

Location

Rig up

Drilling and Remarks:

T. Sand 2536Small show

RECORD

Cased in. Ft.

Sand

Gas

Oil

Total Depth

PRODUCTION

1st 24 hrs. Nat.

1st 24 hrs. after shot

Gas Cu. Ft.

Dry Hole


Abandoned

Date

6/2, 1917, C. J. Crocker Scout

Map No. _____ Sec. 4 Twp. 26 R. 5Well No. 4 Millheiser FarmEldorado Dr. I Company

NORTH

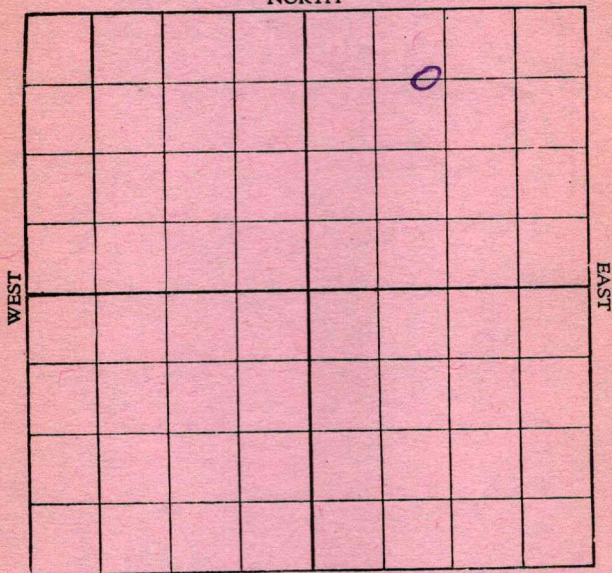

SOUTH

Location _____

Rig up _____

Drilling and remarks:

RECORD

Cased _____ in. _____ Ft.

Sand _____

Gas _____

Oil _____

Total Depth _____

PRODUCTION

1st 24 hrs. Nat. _____

1st 24 hrs. after shot _____

Gas _____ Cu. Ft.

Dry Hole _____


Abandoned _____

Date

G. J. Crocker
 _____, 191_____, Scout

Map No. _____ Sec. 4 Twp. 26 R. 5Well No. 4 Millheiser Farm
Eldorado Oil Co. Company

NORTH

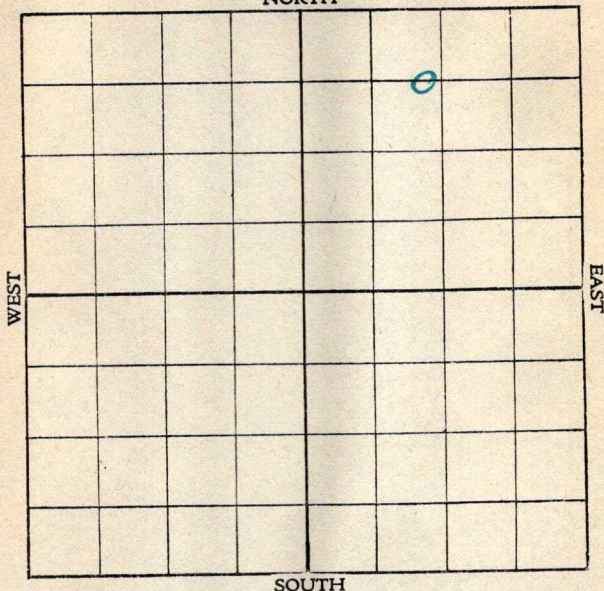

SOUTH

Location _____

Rig up _____

Drilling and remarks:

T.S. 2580'

RECORD

Cased _____ in. _____ Ft.

Sand _____

Gas _____

Oil _____

Total Depth _____

PRODUCTION

1st 24 hrs. Nat. _____

1st 24 hrs. after shot _____

Gas _____ Cu. Ft.

Dry Hole _____

Abandoned _____

Date


JUN 16 1917

, 191

E. J. Crocker Scout

Map No. _____ Sec. 4 Twp. 26 R. 5Well No. 4 Millheiser FarmEldorado. O. & G. Company

NORTH

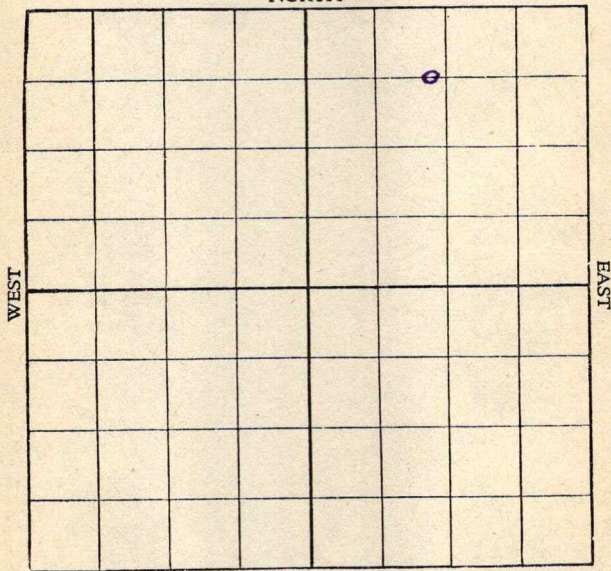

SOUTH

Location _____

Rig up _____

Drilling and remarks:

G.S. 2580D-2660Looks dry.

RECORD

Cased _____ in. _____ Ft.

Sand _____

Gas _____

Oil _____

Total Depth _____

PRODUCTION

1st 24 hrs. Nat. _____

1st 24 hrs. after shot _____

Gas _____ Cu. Ft.

Dry Hole _____

Abandoned _____


Date

JUN 22 1917C. T. Crocker

Scout

Map No. _____ Sec. 4 Twp. 26 R. 5Well No. 4 Millheiser Farm
El Dorado O & G Company

NORTH

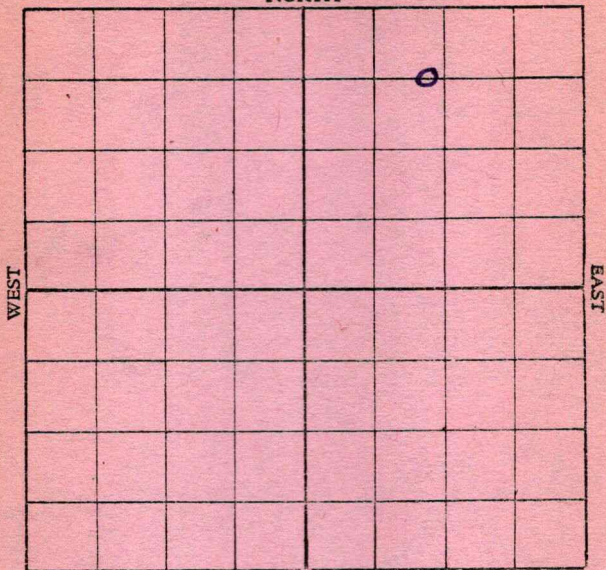

SOUTH

Location _____

Rig up _____

Drilling and remarks:

T.S. 2580'
Fish for Bailer
2665'

RECORD

Cased _____ in. _____ Ft.

Sand _____

Gas _____

Oil _____

Total Depth _____

PRODUCTION

1st 24 hrs. Nat. _____

1st 24 hrs. after shot _____

Gas _____ Cu. Ft.

Dry Hole _____

Abandoned _____


Date JUN 30 1917

, 191

C. J. Crocker Scout

Map No. _____ Sec. 4 Twp. 26 R. 5
 Well No. H Millhiser Farm _____
El Dorado O & G. Company _____

NORTH

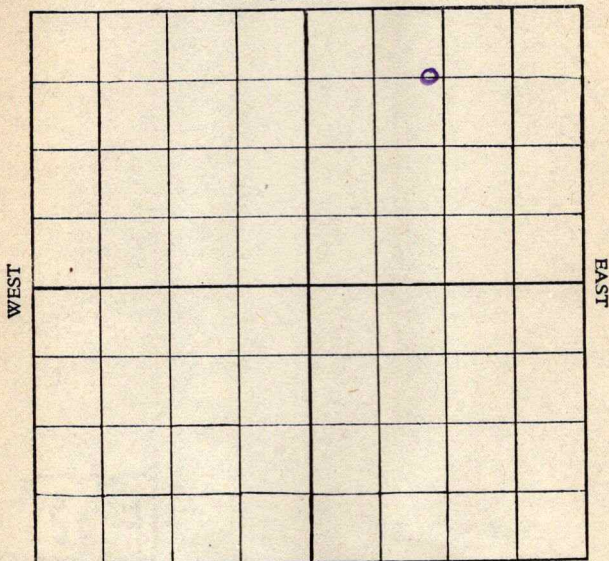

SOUTH

Location _____
 Rig up _____
 Drilling and remarks:

7/3 - Fish 2665

RECORD

Cased _____ in. _____ Ft.
 Sand _____
 Gas _____
 Oil _____
 Total Depth _____

PRODUCTION

1st 24 hrs. Nat. _____
 1st 24 hrs. after shot _____
 Gas _____ Cu. Ft.
 Dry Hole _____
 Abandoned _____

Date JUL 7 1917

, 191


E. J. Crocker Scout

Map No. _____ Sec. 4 Twp. 26 R. 5

Well No. 4 Millheiser Farm

El Dorado O. & G. Company

NORTH

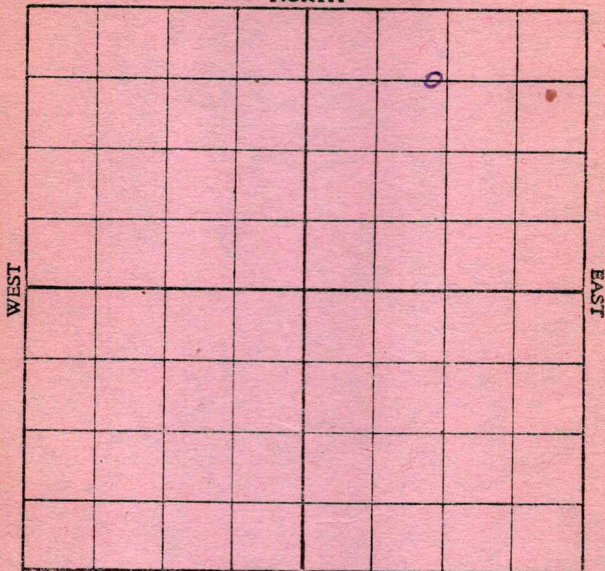

SOUTH

Location _____

Rig up _____

Drilling and remarks:

Fg. for Bailer

2665'

RECORD

Cased _____ in. _____ Ft.

Sand _____

Gas _____

Oil _____

Total Depth _____

PRODUCTION

1st 24 hrs. Nat. _____

1st 24 hrs. after shot _____

Gas _____ Cu. Ft.

Dry Hole _____

Abandoned _____

Date

JUL 14 1917, 191

E. J. Crocker Scout