


Range 11 Township 15 Section 29
 County Russell No. 1
 Farm D. Sidley
 Company Phillips Petro Co.
 Sec.

 Twp.

6	5	4	3	2	1
7	8	9	10	11	12
18	17	16	15	14	13
19	20	21	22	23	24
30	29	28	27	26	25
31	32	33	34	35	36

 Elev. _____ T.D. 3304
 Date Drilled 8-2-41
 Correlation by _____
Long & Lind.

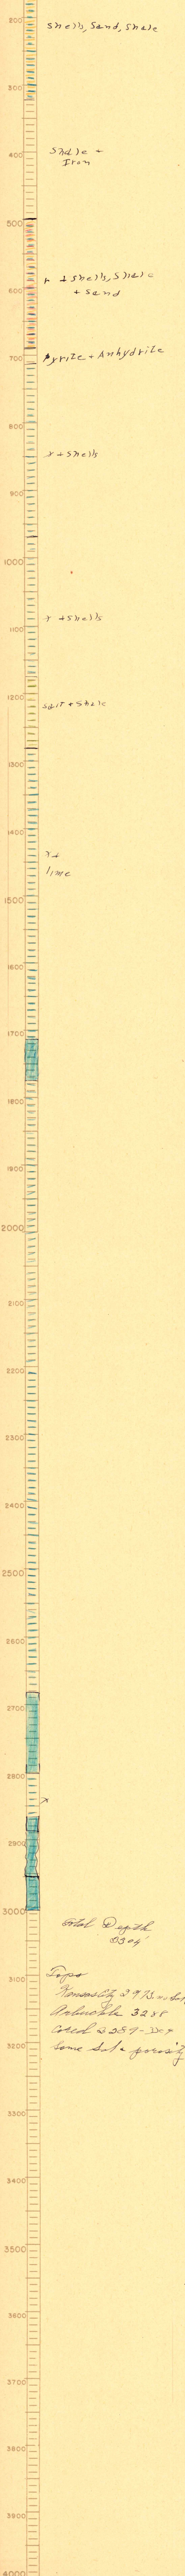

Total Depth 3304'
 Tops
 Kansas City 2973. no Sol.
 Some Sol. porosity