


Section 20 Township 26 Range 5 EWell No. # 265 KooglerCompany Cities Service Oil

NORTH

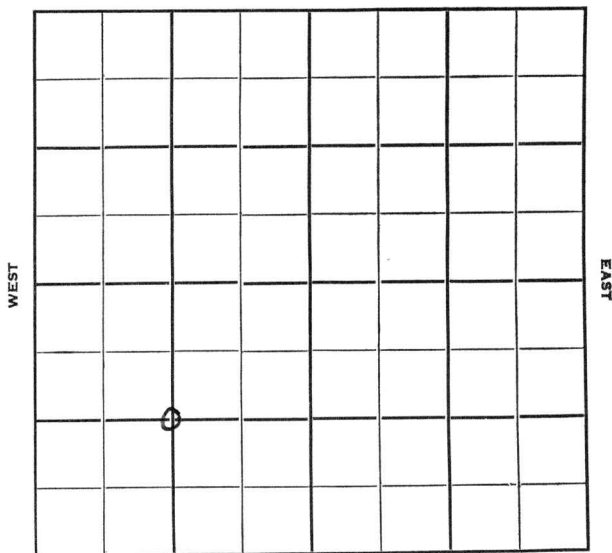

SOUTH

Butler

KANSAS

Sec. 20 Twp. 26 R. 5E

Well No. #265 Koogler Farm

Cities Service Oil Company

Contractor


Ft. from N. Line

1320' Ft. from S. Line

Ft. from E. Line

1320' Ft. from W. Line

C SW/4

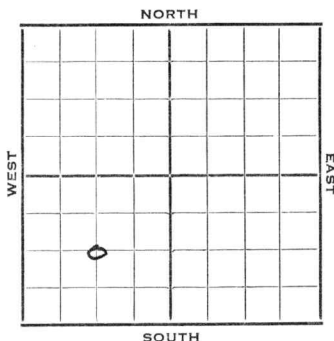


1952	Elev. 1337'	REPORT
3/12	8" @ 87 WOR	
4/2	Oil Well TD 2621 8" @ 87 Viola 2556 Simp. 2585 TD 2592 4" @ 2591 DD 2621 16 qt. 2603-18 95/ 2558-84 SP 2589 1500 A Comp. 48 BOPD 10 BW	
	COMPLETED	

County **Butler** State **KANSAS**
Sec. **20** (Blk. Twp.) **26** (Sur. Rge.) **5E** Map No.

Operator **Cities Service Oil**

Well No. **265** Farm **Koogler**

Elev. Location **C SW/4**

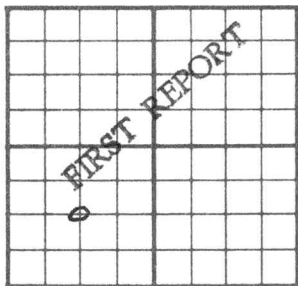

1320 Ft. From **S** Line **SW**

1320 Ft. From **W** Line Quarter

1st. Report **MAR 12 1952**

Completion

Remarks


Spudding Date

Drlg. Data

8" @ 87 WOB

J. G. McGEHEE

County Butler State Kansas
 Sec. 20 (Blk. 26 (Sur. 5E Map No.
 (Twp.) (Rge.)
 Operator Cities Service Oil
 Well No. 265 Farm Keogler
 Elev. 1337 Location C SW/4

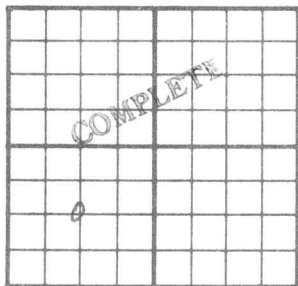

1320 Ft. From S Line SW

1320 Ft. From W Line Quarter

1st. Report

Completion APR 2 1952

Remarks

Spudding Date

Drlg. Data Oil well TD 2621

8" @ 87 Viola 2556 Simp. 2585

TD 2592 4" @ 2591 DD 2621 16 qt/

2603-18 95/ 2558-84 SP 2589 1500 A

Comp. 48 bopd 10bw

J. G. McGEHEE