


275

STATE <i>Kansas</i>		COMPANY <i>Mark</i>	
COUNTY <i>Hodgeman</i>	FARM <i>Mooney</i>	WELL NO. <i>1</i>	
BLOCK	SURVEY		
SEC. <i>29</i>		TOTAL DEPTH <i>4500</i>	
T. <i>22S</i>	R. <i>21W</i>		
0		<i>2-80-18</i>	
COMMENCED			
COMPLETED			
REMARKS <i>Elog.</i>			
ALTITUDE <i>2790</i>			
PRODUCTION <i>D.H.</i>			

CASING RECORD

SHOT	QUARTS	BETWEEN
------	--------	---------

FORM 186 - In stock and for sale by Mid-West Prtg. Co., Tulsa

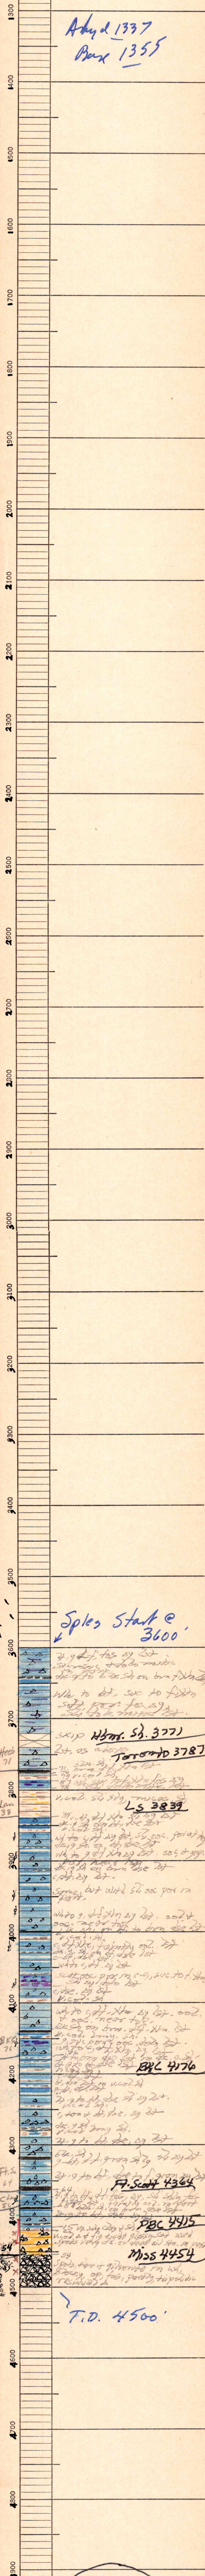

631