


Greenwood
 Map No. 1000 Sec. 21 Twp. 26 R. 9
 Well No. 1 Lawrence Farm
H. J. Smith Company

NORTH

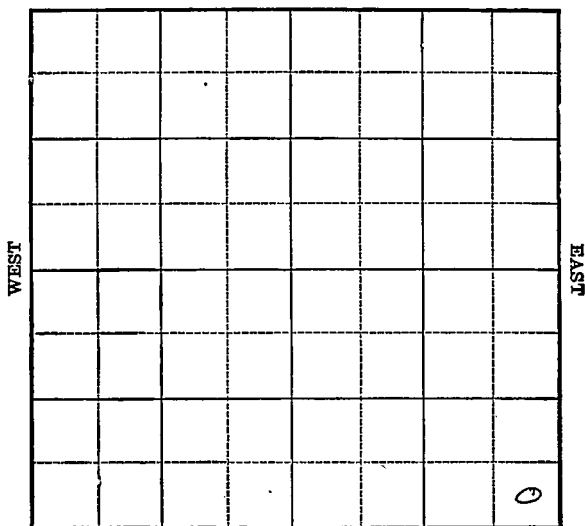

SOUTH

Location _____
 Drilling Remarks _____

Rig Up _____
 Drilling Remarks _____

RECORD

Cased _____ in. _____ ft.
 Sand _____
 Gas _____
 Oil _____
 Total Depth _____

PRODUCTION

1st 24 hrs. Nat. _____
 1st 24 hrs. after shot _____
 Gas _____ cu. ft.
 Dry Hole _____
 Abandoned _____

Greenwood


Map No. 17N Sec. 21 Twp. 26 R. 9Well No. 1 - Lowery FarmH. J. Smith Company

NORTH

_____ Ft. from N. Line

330 Ft. from S. Line330 Ft. from E. Line

_____ Ft. from W. Line

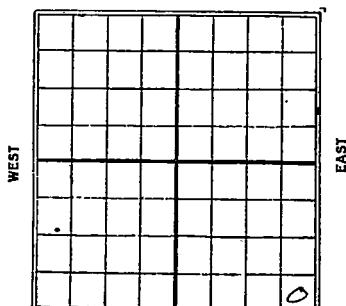

SOUTH

1926

Date

REPORT

8/25	Location
8-31	—
9/15	Rig
9/22	Digging up
9/29	Leaving
10/13	Drill 710'
10/27	fishing 1025'
11/11	same
11/17	1 1/2 M gas 910' - Drill 1250
11/23	Drill 1410'
12/8	" 1900
12/15	Sand 2290-2315' filled up 300' in 12 hrs. will shoot 40 qts.
12/22	same
12/30	shot 40 qts, swabbing & C.O.
1927	
1/6	same
1/12	Sand 2263-2299 T.D. 2301 40 qts 40 bbls some water

15 KANSAS *21* *Shoenwood*
 Map No. _____ Sec. _____ Twp. *26* R. *9*
 Well No. *1* *Howers*
H. J. Smith _____ Company
 _____ Contractor

FIRST REPORTS

SECTION PLAT

_____ Ft. from N. Line

330

_____ Ft. from S. Line

330

_____ Ft. from E. Line

_____ Ft. from W. Line

			o

Location ☒ _____

Rig up _____

Drilling and Remarks:

RECORD

Cased _____ in., _____ ft.

Sand _____

Gas _____

Oil _____

Total Depth _____

PRODUCTION

1st 24 hrs. Nat. _____

1st 24 hrs. after shot _____

Gas _____ Cu. Ft.

Dry Hole _____

Abandoned _____

Date

AUG 25 1926

CHAS. L. SHERWOOD

192

Scout

15 KANSAS

Map No. _____ Sec. 21 Twp. 26 R. 9

Well No. 1 Lowery Farm

H. J. Smith Company

NORTH

WEST

EAST

COMPLETED

330 x 330

Steel line connection in sand record.

Location _____

Rig up _____

Drilling and Remarks:

40/40 Bls.

some water

RECORD

Cased _____ in., _____ ft.

Sand 2263-2299

Gas _____

Oil _____

Total Depth 2301

PRODUCTION

1st 24 hrs. Nat. _____

1st 24 hrs. after shot _____

Gas _____ Cu. Ft.

Dry Hole _____

Abandoned _____

Date JAN 2 1927

CHAS. L. SHERWOOD

192

Scout