


Map No. Kan Sec. 22 Twp. 26 R. 9Well No. 1 Prather Farm
Magnolia Pet Company

NORTH

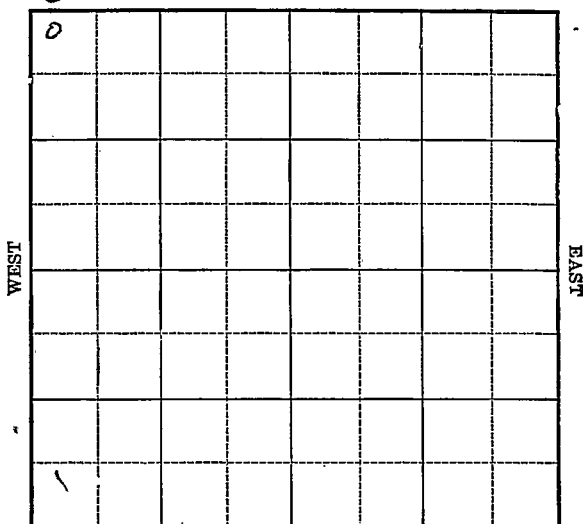

SOUTH

Location _____

Drilling Remarks

Rig Up _____

Drilling Remarks

RECORD

Cased _____ in. _____ ft.

Sand _____

Gas _____

Oil _____

Total Depth _____

PRODUCTION

1st 24 hrs. Nat. _____

1st. 24 hrs. after shot _____

Gas _____ cu. ft.

Dry Hole _____

Abandoned _____

Map No. Kan Sec. 22 Twp. 26 R. 9Well No. 1 Prather FarmMagnolia Pet Co Company200 Ft. from N. Line

_____ Ft. from S. Line

_____ Ft. from E. Line

200 Ft. from W. LineC

NORTH

WEST

EAST

SOUTH

Date

REPORT

19256/26 Rign up7/3 Spud7/10 400'7/17 11407/24 _____7/31 1675'8/7 2400'8/14 2655 - 6"8/20 S. & A. 2807

Map No. 15440 Sec. 22 Twp. 26 R. 9Well No. 1 Mather
Magnolia Oil Co Company

Contractor

FIRST REPORTS

SECTION PLAT

200 Ft. from N. Line

Ft. from S. Line

Ft. from E. Line

200 Ft. from W. Line

0			

Location

Rig up

Drilling and Remarks:

Rigging up

RECORD

Cased _____ in., _____ ft.

Sand _____

Gas _____

Oil _____

Total Depth 3

PRODUCTION

1st 24 hrs. Nat. _____

1st 24 hrs. after shot _____

Gas _____ Cu. Ft.

Dry Hole _____

Abandoned _____

Date

JUN 26, 1925

CHAS. L. SHERWOOD

192

Scout

15 KANSAS
 Map No. _____ Sec. 22 Twp. 26 R. 9
 Well No. 1 *Prather*
Magalloway Company
 _____ Contractor

COMPLETED

SECTION PLAT

200
 _____ Ft. from N. Line

_____ Ft. from S. Line

_____ Ft. from E. Line

200
 _____ Ft. from W. Line

ABANDONED

0			

Location _____

Rig up _____

Drilling and Remarks:

Top lens 2270-

2335'

Wilcox v658-
v668' HFW.

Dry & lost

RECORD

Cased _____ in., _____ ft.

Sand _____

Gas _____

Oil _____

Total Depth *2807'*

PRODUCTION

1st 24 hrs. Nat. _____

1st 24 hrs. after shot _____

Gas _____ Cu. Ft.

Dry Hole ☒Abandoned ☒

Date

AUG 20 1925
 _____ 192

CHAS. L. SHERWOOD

Scout