

Map No. _____ Sec. 4 Twp. 26 R. 5Well No. 5 Millenhausen FarmBritish American Company

NORTH

(Miller)

WEST

EAST

SOUTH

Location _____

Rig Up 10/30/16

Drilling Remarks:

Drilling Remarks:

R. 21. 11/9. 11/14300 = 11/27600 = 12/4800 = 12/11 = 12/18. 11/112/28 = 1/8/17 - F1300 = 1/15 =

RECORD

Cased _____ in _____ Ft.

Sand _____

Gas _____

Oil _____

Total Depth _____

PRODUCTION

1st 24 hrs. Nat. _____

1st 24 hrs. after shot _____

Gas _____ Cu. Ft.

Dry Hole _____

Abandoned _____

Map No. _____ Sec. 4 Twp. 26 R. 5Well No. 5 Mullhisen FarmBritish American Company

NORTH

WEST

EAST

SOUTH

Location ✓Rig up ✓

Drilling and remarks

RECORD

Cased _____ in. _____ Ft.

Sand _____

Gas _____

Oil _____

Total Depth _____

PRODUCTION

1st. 24 hrs. Nat. _____

1st 24 hrs. after shot _____

Gas _____ Cu. Ft.

Dry Hole _____

Abandoned _____


Date

10/30, 1916, Dec Scout

Map No. _____ Sec. 4 Twp. 26 R. 5
 Well No. 5 Killbuck Farm
British-American Company

NORTH

WEST

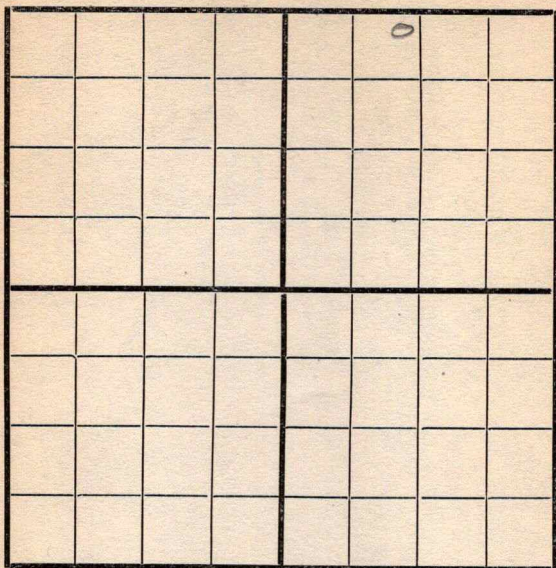

EAST

SOUTH

Location _____

Rig Up _____

Drilling and remarks _____

RECORD

Cased _____ in. _____ Ft.

Sand _____

Gas _____

Oil _____

Total Depth _____

PRODUCTION

1st 24 hrs. Nat. _____

1st 24 hrs. after shot _____

Gas _____ Cu. Ft.

Dry Hole _____

Abandoned _____

Date

11/9, 191 6 Scout

Map No. _____ Sec. 4 Twp. 26 R. 5
 Well No. 5 Miller Farm
British-American Company

NORTH

WEST

EAST

SOUTH

Location _____
 Rig Up ☒ _____
 Drilling and remarks _____

RECORD

Cased _____ in. _____ Ft.
 Sand _____
 Gas _____
 Oil _____
 Total Depth _____

PRODUCTION

1st 24 hrs. Nat. _____
 First 24 hrs. after shot _____
 Gas _____ Cu. Ft.
 Dry Hole _____
 Abandoned _____

Date

11/14, 1916 Alley Scout

Map No. _____ Sec. 4 Twp. 26 R. 5
 Well No. 5 Miller Farm _____
British-American Company

NORTH

WEST

EAST

SOUTH

Location _____

Rig Up _____

Drilling and remarks

Rigging up

RECORD

Cased _____ in. _____ Ft.

Sand _____

Gas _____

Oil _____

Total Depth _____

PRODUCTION

1st 24 hrs. Nat. _____

1st 24 hrs. after shot _____

Gas _____ Cu. Ft.

Dry Hole _____


Abandoned _____

Date

4/20, 1916 Co. 2 Scout

Map No. _____ Sec. 4 Twp. 26 R. 5
 Well No. 5 Millbrier Farm
British-American Company

NORTH

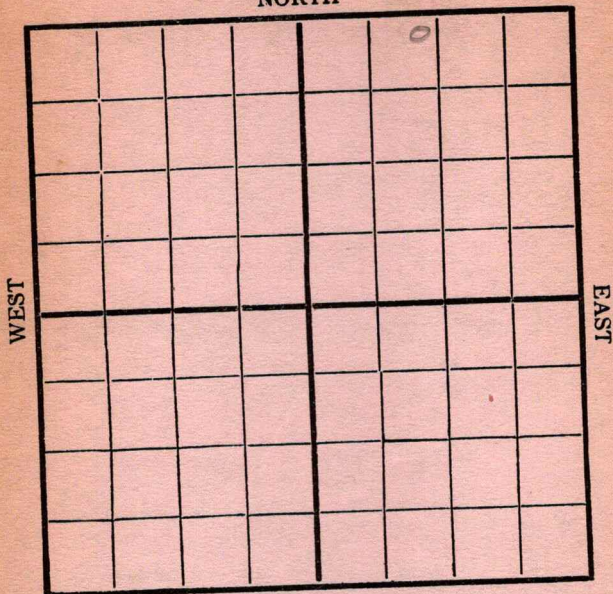

SOUTH

Location _____

Rig Up _____

Drilling and remarks

300

RECORD

Cased _____ in. _____ Ft.

Sand _____

Gas _____

Oil _____

Total Depth _____

PRODUCTION

1st 24 hrs. Nat. _____

1st 24 hrs. after shot _____

Gas _____ Cu. Ft.

Dry Hole _____


Abandoned _____

Date

11/22, 1916 Cordiff Scout

Map No. _____ Sec. 4 Twp. 26 R. 5Well No. 5 Malheiser Farm
British-American Company

NORTH

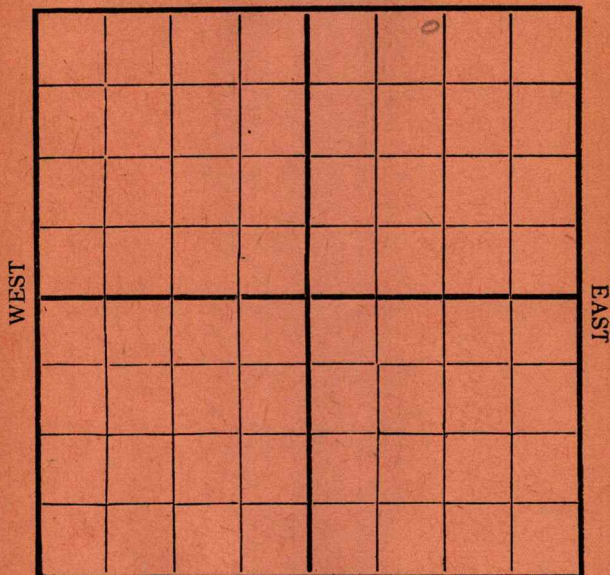

SOUTH

Location _____

Rig Up _____

Drilling and remarks

600'

RECORD

Cased _____ in. _____ Ft.

Sand _____

Gas _____

Oil _____

Total Depth _____

PRODUCTION

1st 24 hrs. Nat. _____

1st 24 hrs. after shot _____

Gas _____ Cu. Ft.

Dry Hole _____

Abandoned _____

Date

12/4, 1916, Cordell Scout

Map No. _____ Sec. 4 Twp. 26 R. 5Well No. 5 Millhiser FarmBritish American Company

NORTH

WEST

EAST

SOUTH

Location _____

Rig Up _____

Drilling and remarks

Rig Burned
at 800'

RECORD

Cased _____ in. _____ Ft.

Sand _____

Gas _____

Oil _____

Total Depth _____

PRODUCTION

1st 24 hrs. Nat. _____

1st 24 hrs. after shot _____

Gas _____ Cu. Ft.

Dry Hole _____


Abandoned _____

Date

12/11, 1916, C. O. D. Scout

Map No. _____ Sec. 4 Twp. 26 R 5
Well No. 5 Miller Farm _____
British American Company

NORTH

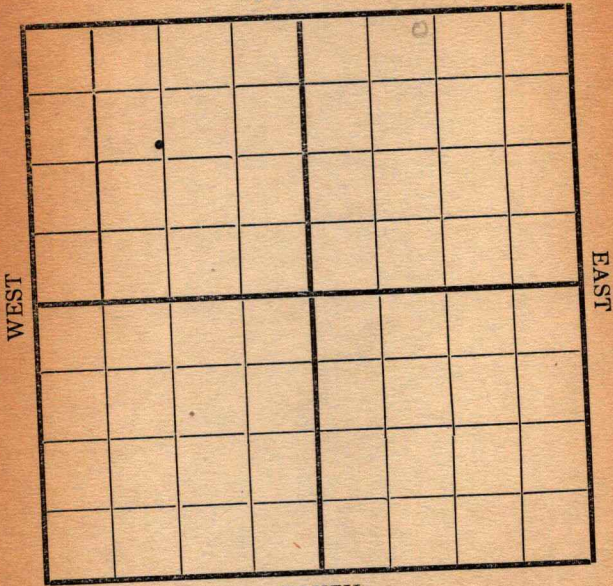

SOUTH

	RECORD
Location _____	Cased _____ in. _____ Ft.
Rig Up _____	Sand _____
Drilling and remarks	Gas _____
<u>800</u>	Oil _____
	Total Depth _____
	PRODUCTION
	1st 24 hrs. Nat. _____
	1st 24 hrs. after shot _____
	Gas _____ Cu. Ft.
	Dry Hole _____
	Abandoned _____

Date 12/18, 1916 C. C. C. Scout

Map No. _____ Sec. 4 Twp. 26 R. 5

Well No. 5 Miller Farm

B-a Company

NORTH

WEST

EAST

SOUTH

Location _____

Rig up _____

Drilling and remarks

*Fishing
at 800*

RECORD

Cased _____ in. _____ Ft.

Sand _____

Gas _____

Oil _____

Total Depth _____

PRODUCTION

1st. 24 hrs. Nat. _____

1st 24 hrs. after shot _____

Gas _____ Cu. Ft.

Dry Hole _____


Abandoned _____

Date

12/28, 1916, *Conley* Scout

Map No. _____ Sec. 4 Twp. 26 R. 5
 Well No. 5 million Farm _____
13-a Company _____

NORTH

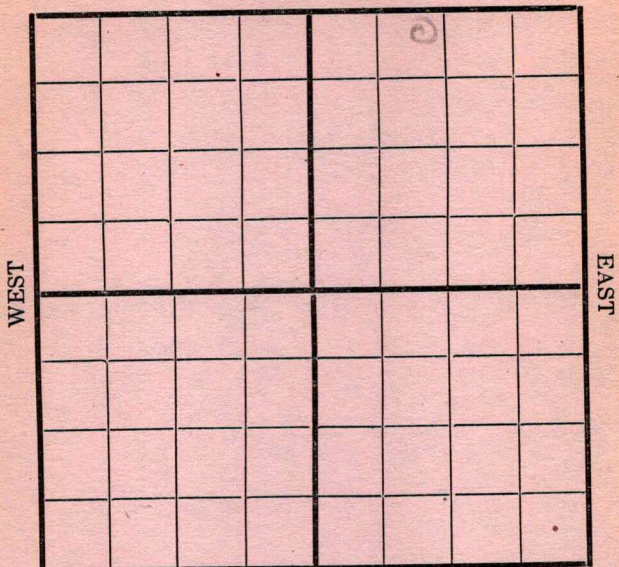

SOUTH

Location _____
 Rig Up _____
 Drilling and remarks _____

*Shut Down
 at 800*

RECORD

Cased _____ in. _____ Ft.
 Sand _____
 Gas _____
 Oil _____
 Total Depth _____


PRODUCTION

1st 24 hrs. Nat. _____
 1st 24 hrs. after shot _____
 Gas _____ Cu. Ft.
 Dry Hole _____
 Abandoned _____

Date 1/1, 191 7 Candy Scout

Map No. _____ Sec. 4 Twp. 26 R. 5
 Well No. 5 McElhiney Farm
British-American Company

NORTH

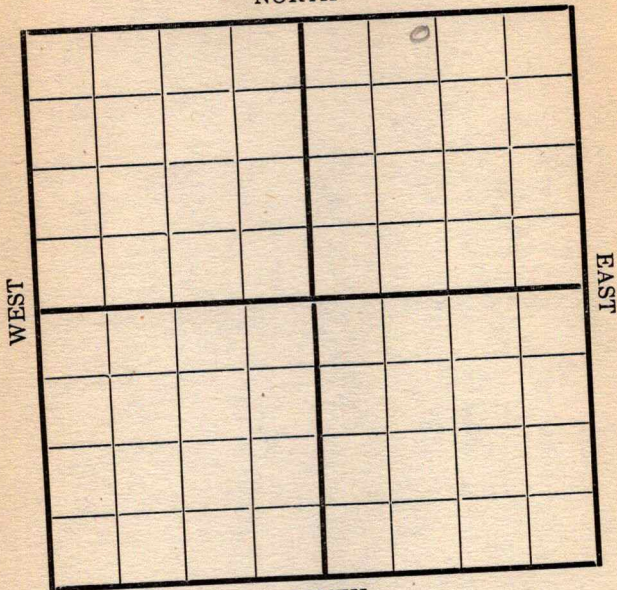

SOUTH

Location _____

Rig Up _____

Drilling and remarks

*Fishing at
800'*

RECORD

Cased _____ in. _____ Ft.

Sand _____

Gas _____

Oil _____

Total Depth _____

PRODUCTION

1st 24 hrs. Nat. _____

1st 24 hrs. after shot _____

Gas _____ Cu. Ft.

Dry Hole _____


Abandoned _____

Date

1/8, 1917 Cardiff Scout

Map No. _____ Sec. 4 Twp. 26 R. 5
 Well No. 5 Miller Farm
British-American Company

NORTH

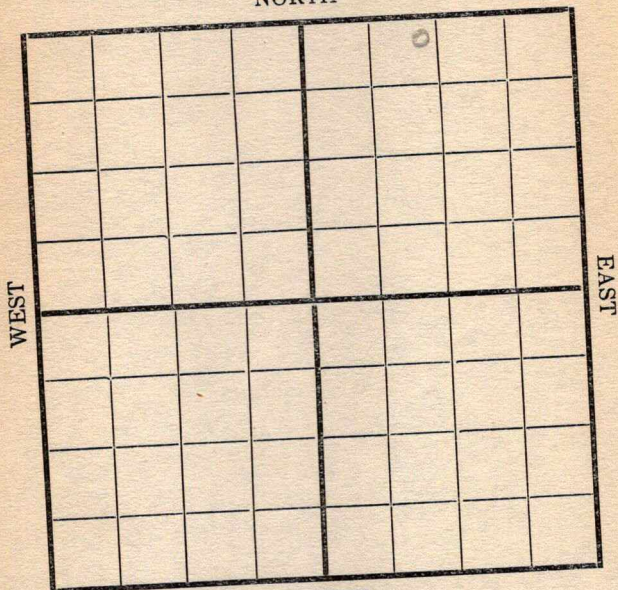

SOUTH

Location _____
 Rig Up _____
 Drilling and remarks

1300'

RECORD

Cased _____ in. _____ Ft.
 Sand _____
 Gas _____
 Oil _____
 Total Depth _____

PRODUCTION


1st 24 hrs. Nat. _____
 1st 24 hrs. after shot _____
 Gas _____ Cu. Ft.
 Dry Hole _____
 Abandoned _____

Date

1/15, 1917 C. D. J. Scout

Map No. _____ Sec. 4 Twp. 26 R. 5
 Well No 5 Miller Farm
British-American Company

NORTH

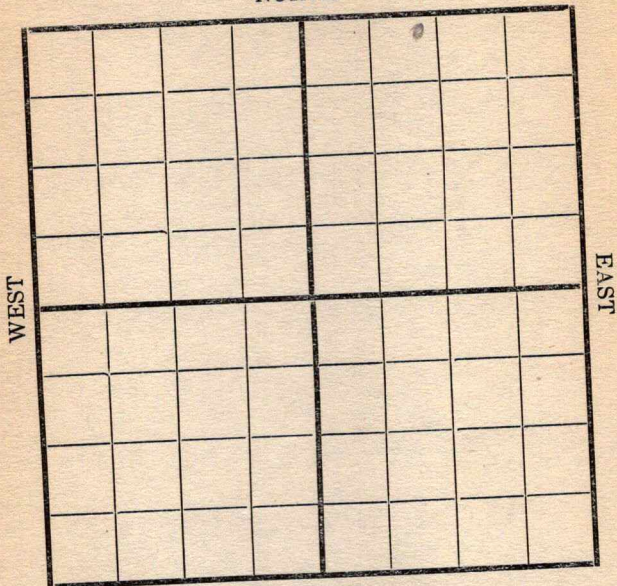

SOUTH

Location _____
 Rig Up _____
 Drilling and remarks
1520'

RECORD

Cased _____ in. _____ Ft.
 Sand _____
 Gas _____
 Oil _____
 Total Depth _____


PRODUCTION

1st 24 hrs. Nat. _____
 1st 24 hrs. after shot _____
 Gas _____ Cu. Ft.
 Dry Hole _____
 Abandoned _____

Date 1/22/1917 Cordiff Scout

Map No. _____ Sec. 4 Twp. 26 R. 5
 Well No. 5 Millhiser Farm
British-American Company

NORTH

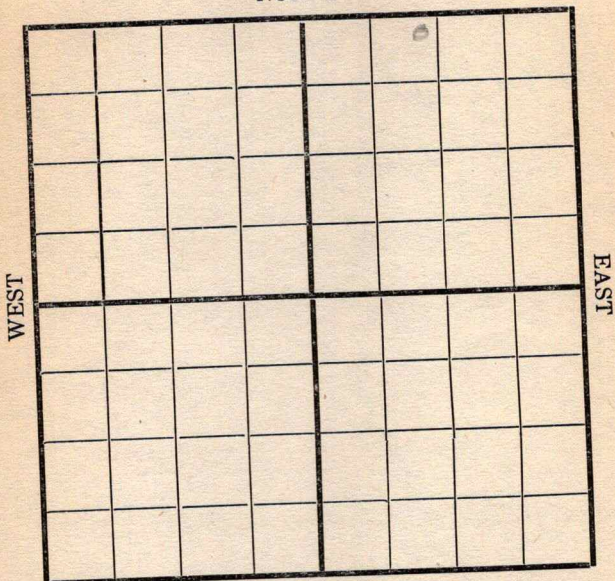

SOUTH

Location _____
 Rig Up _____
 Drilling and remarks _____

Shut Down
1520

RECORD

Cased _____ in. _____ Ft.
 Sand _____
 Gas _____
 Oil _____
 Total Depth _____


PRODUCTION

1st 24 hrs. Nat. _____
 1st 24 hrs. after shot _____
 Gas _____ Cu. Ft.
 Dry Hole _____
 Abandoned _____

Date

1/29, 1917 Conley Scout

Map No. _____ Sec. 4 Twp. 26 R. 5
 Well No. 5-Miller Farm _____
B-a Company _____

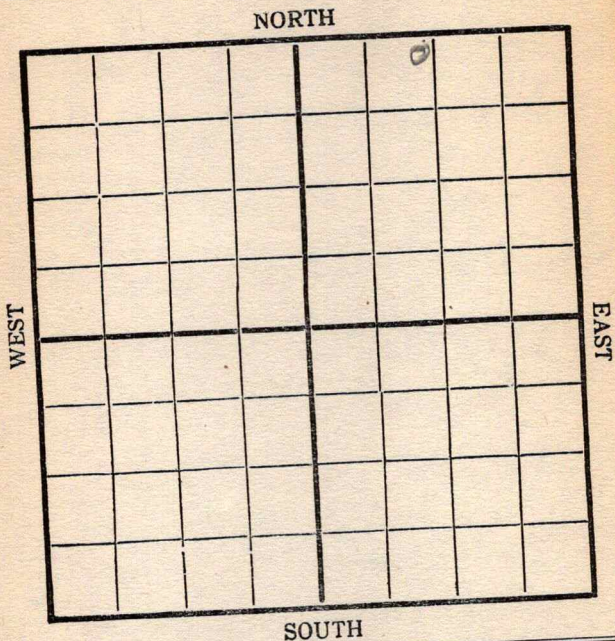

Location _____
 Rig Up _____
 Drilling and remarks _____

Shut Down
1520'

RECORD

Cased _____ in. _____ Ft.
 Sand _____
 Gas _____
 Oil _____
 Total Depth _____

PRODUCTION


1st 24 hrs. Nat. _____
 First 24 hrs. after shot _____
 Gas _____ Cu. Ft.
 Dry Hole _____
 Abandoned _____

Date _____

2/5, 1917 *Condy* Scout _____

Map No. _____ Sec. 4 Twp. 26 R. 5
Well No. 5 Millhiser Farm
British American Company

NORTH

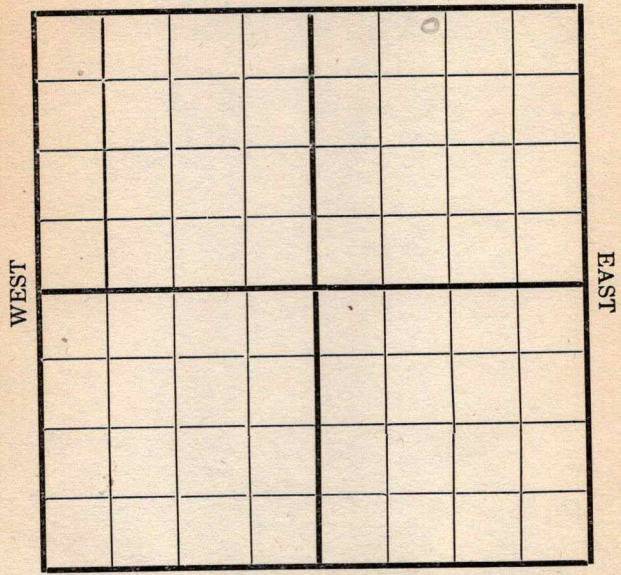


SOUTH

	RECORD
Location _____	Cased _____ in. _____ Ft.
Rig Up _____	Sand _____
Drilling and remarks <u>Shut Down</u> <u>1520'</u>	Gas _____
	Oil _____
	Total Depth _____
	PRODUCTION
	1st 24 hrs. Nat. _____
	1st 24 hrs. after shot _____
	Gas _____ Cu. Ft.
	Dry Hole _____
	Abandoned _____

Date 3/2, 1912 Cordery Scout

Map No. _____ Sec. 4 Twp. 26 R. 5
Well No. 5 Willheiser Farm
British-American Company

NORTH

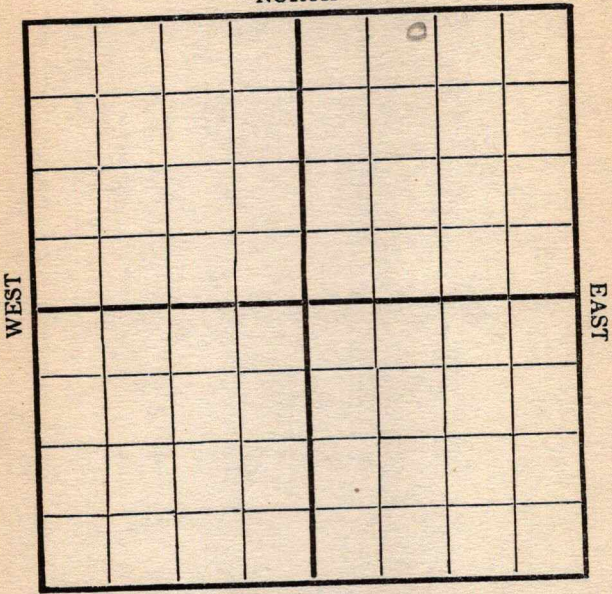

SOUTH

Location _____
Rig Up _____
Drilling and remarks

1800'

RECORD

Cased _____ in. _____ Ft.
Sand _____
Gas _____
Oil _____
Total Depth _____


PRODUCTION

1st 24 hrs. Nat. _____
1st 24 hrs. after shot _____
Gas _____ Cu. Ft.
Dry Hole _____
Abandoned _____

Date 2/19/20 1912 Caddy Scout

Map No. _____ Sec. 4 Twp. 26 R. 5
 Well No. 5 Mullheim Farm _____
British - American Company

NORTH

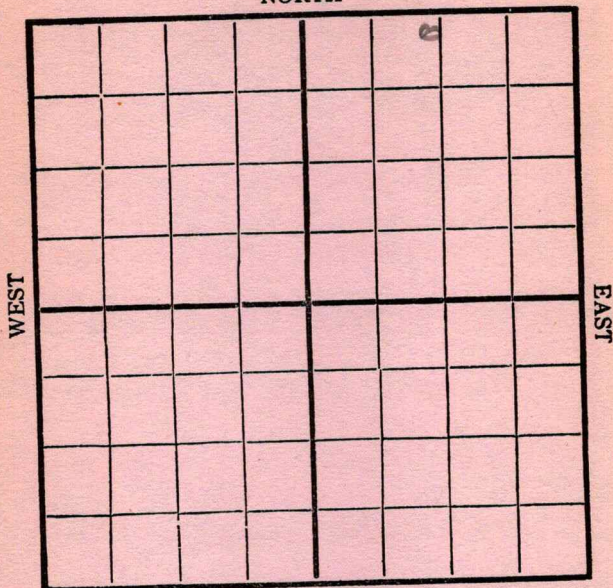

SOUTH

Location _____
 Rig Up _____
 Drilling and remarks

1830

RECORD

Cased _____ in. _____ Ft.
 Sand _____
 Gas _____
 Oil _____
 Total Depth _____

PRODUCTION

1st 24 hrs. Nat. _____
 First 24 hrs. after shot _____
 Gas _____ Cu. Ft.
 Dry Hole _____
 Abandoned _____

Date


Feb 7 1917 _____ Scout

Map No. _____ Sec. 4 Twp. 26 R. 5
 Well No. 5 Miller Farm _____
British American Company

NORTH

WEST

EAST

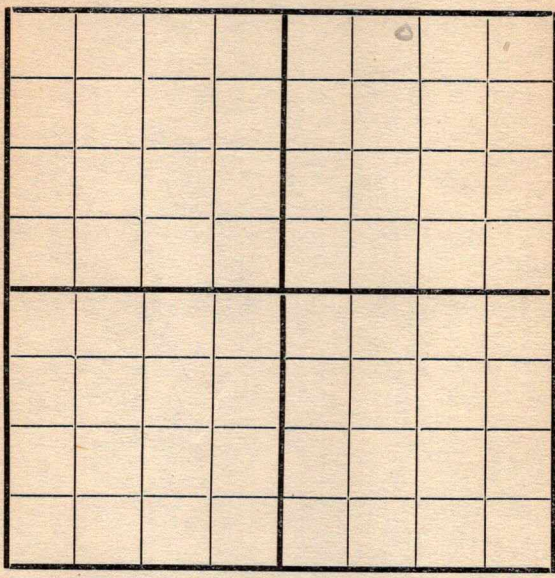

SOUTH

Location _____
 Rig Up _____
 Drilling and remarks

1720

RECORD

Cased _____ in. _____ Ft.
 Sand _____
 Gas _____
 Oil _____
 Total Depth _____

PRODUCTION


1st 24 hrs. Nat. _____
 1st 24 hrs. after shot _____
 Gas _____ Cu. Ft.
 Dry Hole _____
 Abandoned _____

Date

3/5, 1917 Cardiff Scout

Map No. _____ Sec. 4 Twp. 26 R. 5Well No. 5 Millheiser FarmBritish-American Company

NORTH

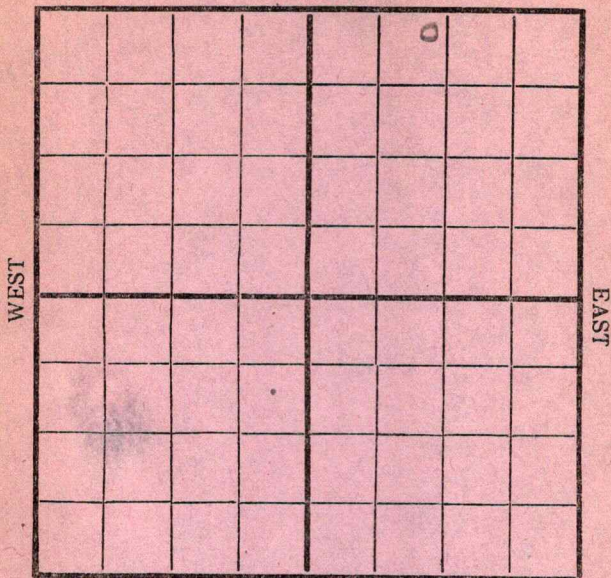

SOUTH

REMARKS:


2000'

Date

3/12, 1912 Cordell Scout

Map No. _____ Sec. 4 Twp. 26 R. 5
 Well No. 5 Millheiser Farm
British-American Company

NORTH

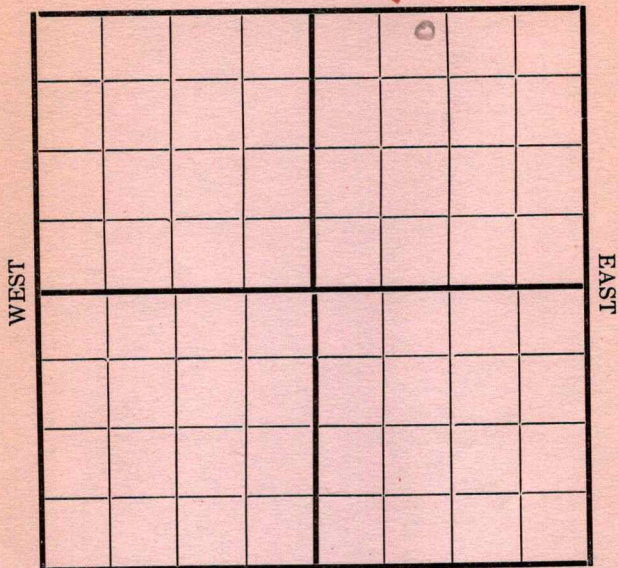

SOUTH

Location _____
 Rig Up _____
 Drilling and remarks

2400'

RECORD

Cased _____ in. _____ Ft.
 Sand _____
 Gas _____
 Oil _____
 Total Depth _____

PRODUCTION

1st 24 hrs. Nat. _____
 1st 24 hrs. after shot _____
 Gas _____ Cu. Ft.
 Dry Hole _____
 Abandoned _____

Date

3/21, 1917 Carley Scout

Map No. _____ Sec. 4 Twp. 26 R. 5
 Well No. 5 Michigan Farm
British-American Company

NORTH

WEST

COMPLETED

EAST

SOUTH

Location _____

Rig Up _____

Drilling and remarks

Lat at
150 Bbl

NO

RECORD

Cased _____ in. _____ Ft.

Sand 2537-2554

Gas _____

Oil _____

Total Depth _____

PRODUCTION

1st 24 hrs. Nat. _____

1st 24 hrs. after shot _____

Gas _____ Cu. Ft.

Dry Hole _____

Abandoned _____

Date

3/26, 1917 C. A. Duff Scout