


Map No. 5 Sec. 4 Twp. 26 R. 5
 Well No. 13 Millheiser Farm
British American Company
El Dorado NORTH OG

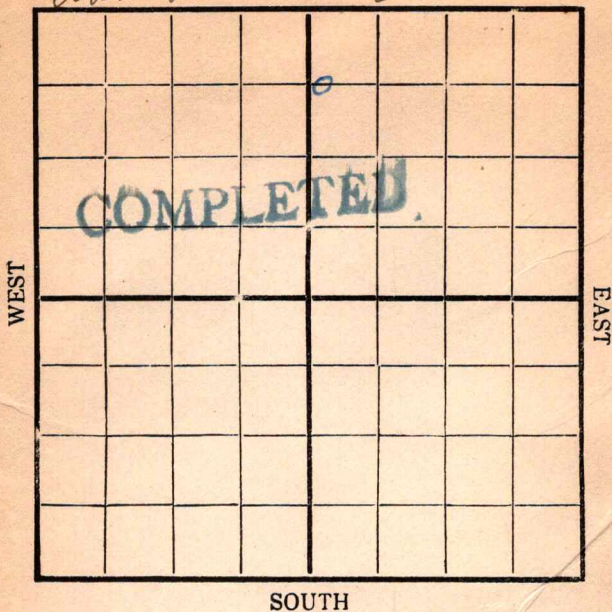

Location _____

Rig Up _____

Drilling Remarks:

Drilling Remarks:

RECORD

PRODUCTION

Cased _____ in _____ Ft.

1st 24 hrs. Nat. _____

Sand _____

1st 24 hrs. after shot _____

Gas _____

Gas _____ Cu. Ft.

Oil _____

Dry Hole _____

Total Depth _____

Abandoned _____

Map No. _____ Sec. 4 Twp. 26 R. 5
 Well No. 13 Millhiser Farm
British-American Company

NORTH

WEST

EAST

SOUTH

Location _____
 Rig Up _____
 Drilling and remarks _____

RECORD

Cased _____ in. _____ Ft.
 Sand _____
 Gas _____
 Oil _____
 Total Depth _____

FIRST REPORT

PRODUCTION


1st 24 hrs. Nat. _____
 1st 24 hrs. after shot _____
 Gas _____ Cu. Ft.
 Dry Hole _____
 Abandoned _____

Date

4/19, 1917 early Scout

Map No. _____ Sec. 4 Twp. 26 R. 5
 Well No. 13 Millburn Farm
British-American Company

NORTH

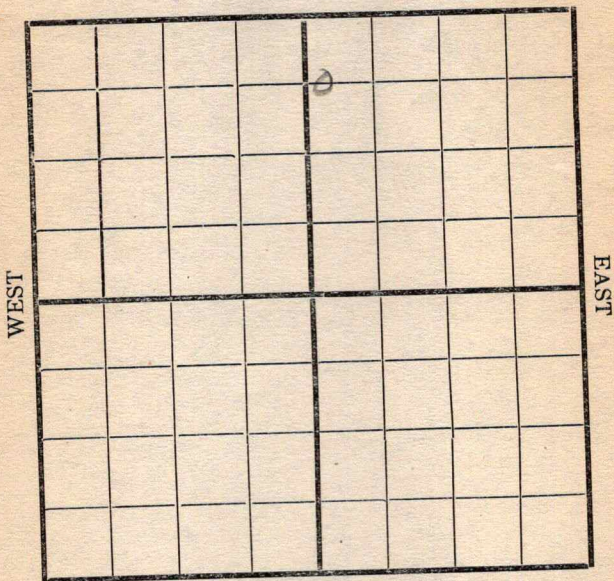

SOUTH

Location _____
 Rig Up ☒ _____
 Drilling and remarks _____

RECORD

Cased _____ in. _____ Ft.
 Sand _____
 Gas _____
 Oil _____
 Total Depth _____

PRODUCTION

1st 24 hrs. Nat. _____
 1st 24 hrs. after shot _____
 Gas _____ Cu. Ft.
 Dry Hole _____
 Abandoned _____

Date

APR 26 1917


191

Parley

Scout

Map No. _____ Sec. A Twp. 26 R. 5Well No. 13 Millhuiser FarmBritish American company

NORTH

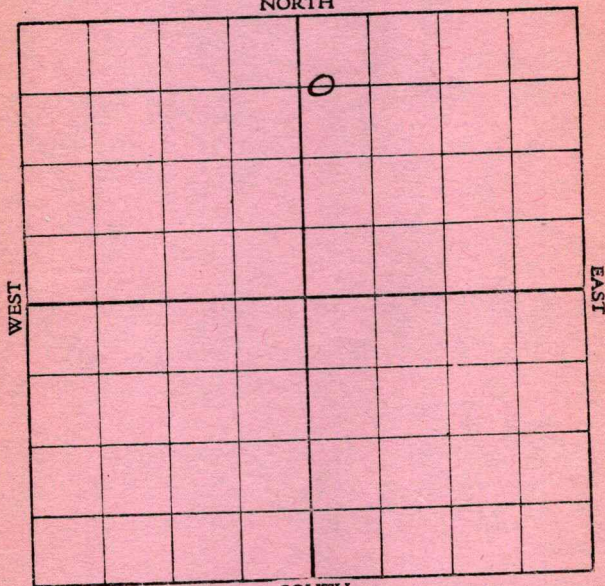

SOUTH

Location _____

Rig up _____

Drilling and remarks:

Rig.

RECORD

Cased _____ in. _____ Ft.

Sand _____

Gas _____

Oil _____

Total Depth _____

PRODUCTION

1st 24 hrs. Nat. _____

1st 24 hrs. after shot _____

Gas _____ Cu. Ft.

Dry Hole _____

Abandoned _____

Date

5/5, 1917Scout

Map No. _____ Sec. 4 Twp. 26 R. 5
 Well No. 5 Millheiser Farm _____
El Dorado O. & G. Company _____

NORTH

WEST EAST

The new name of Company
on this lease has been
changed.
was ~~#~~ 3 British American

SOUTH

Location _____

Rig up _____

Drilling and remarks:

Dry. 310'

RECORD

Cased _____ in. _____ Ft.

Sand _____

Gas _____

Oil _____

Total Depth _____

PRODUCTION

1st 24 hrs. Nat. _____

1st 24 hrs. after shot _____

Gas _____ Cu. Ft.

Dry Hole _____

Abandoned _____

Date


5/12, 1917, Crocker Scout

Map No. _____ Sec. 4 Twp. 26 R. 5

Well No. 5 Millhuiser Farm

El Dorado O & G Company

NORTH

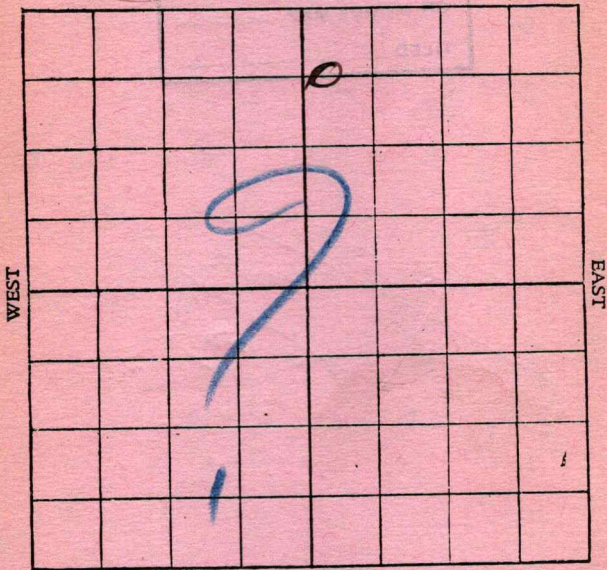

SOUTH

Location _____

Rig up _____

Drilling and remarks:

D-950'

RECORD

Cased _____ in. _____ Ft.

Sand _____

Gas _____

Oil _____

Total Depth _____

PRODUCTION

1st 24 hrs. Nat. _____

1st 24 hrs. after shot _____

Gas _____ Cu. Ft.


Dry Hole _____

Abandoned _____

Date

5/19, 1917, Brocker Scout

Map No. _____ Sec. 4 Twp. 26 R. 5
Well No. 5 Millkiser Farm
Eldorado Oil & Gas Company

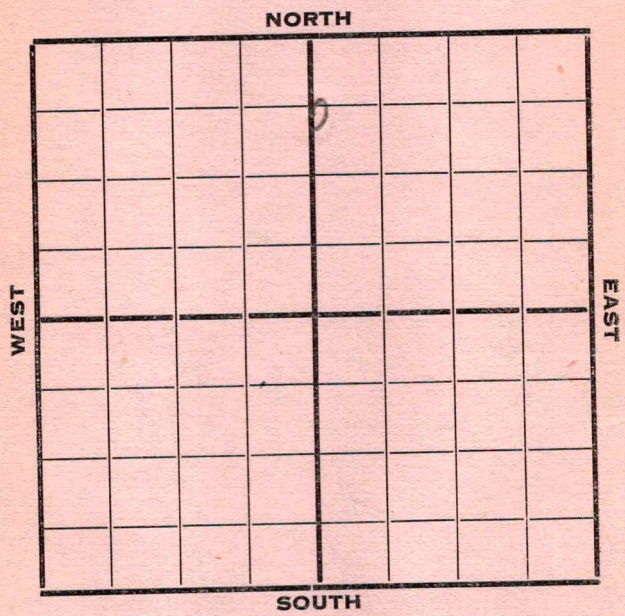


Location _____
Rig up _____
Drilling and Remarks:
Running
8 1/4 2200'

RECORD	
Cased	_____ in. _____ Ft.
Sand	_____
Gas	_____
Oil	_____
Total Depth	_____
PRODUCTION	
1st 24 hrs. Nat.	_____
1st 24 hrs. after shot	_____
Gas	_____ Cu. Ft.
Dry Hole	_____
Abandoned	_____

Date 6/2, 1917 C. J. Crocker Scout

Map No. _____ Sec. 4 Twp. 26 R. 5
 Well No. 5 Millheiser Farm
Eldorado Oil & Gas Company

NORTH

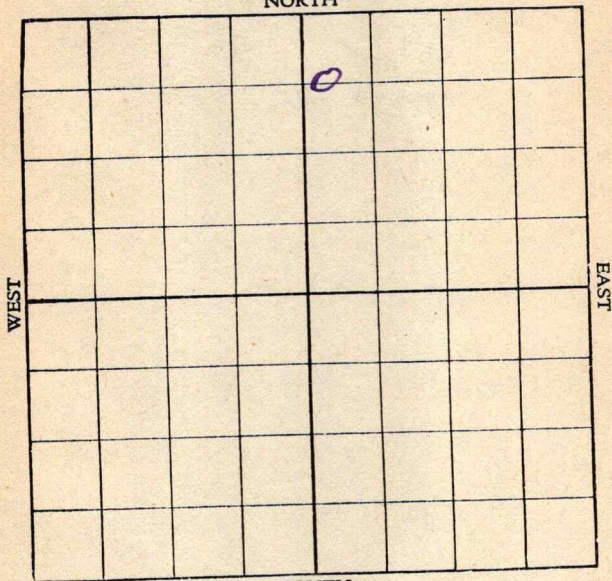

SOUTH

Location _____

Rig up _____

Drilling and remarks:

S.D. 2280'

RECORD

Cased _____ in. _____ Ft.

Sand _____

Gas _____

Oil _____

Total Depth _____

PRODUCTION

1st 24 hrs. Nat. _____

1st 24 hrs. after shot _____

Gas _____ Cu. Ft.

Dry Hole _____

Abandoned _____

Date

JUN 9 - 1917

_____, 191_____,

E. J. Crocker Scout

Map No. _____ Sec. 4 Twp. 26 R. 5

Well No. 5 Millheiser Farm
Eldorado O & G Company

NORTH

WEST

EAST

SOUTH

Location _____

Rig up _____

Drilling and remarks:

*S.D. 2280'
for Case.*

RECORD

Cased _____ in. _____ Ft.

Sand _____

Gas _____

Oil _____

Total Depth _____

PRODUCTION

1st 24 hrs. Nat. _____

1st 24 hrs. after shot _____

Gas _____ Cu. Ft.

Dry Hole _____

Abandoned _____

Date


JUN 16 1917

, 191

G. J. Crocker Scout

Map No. _____ Sec. 4 Twp. 26 R. 5

Well No. 5 Millheiser Farm
Eldorado Dr. G. Company

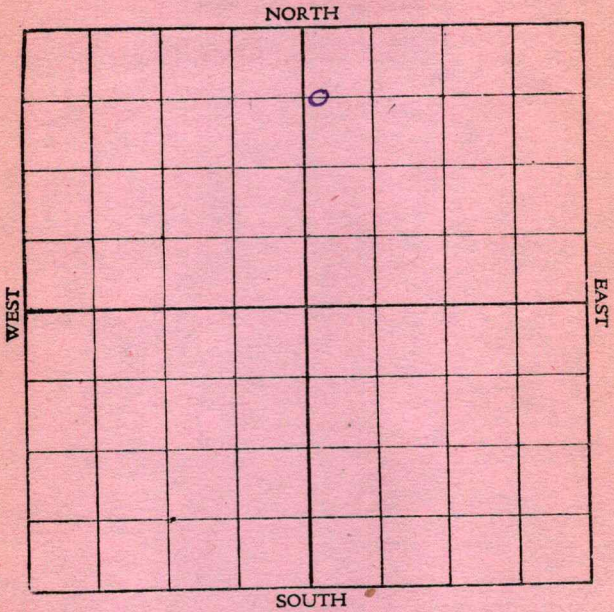

Location _____

Rig up _____

Drilling and remarks:

*S.D. 2280
for Case*

RECORD

Cased _____ in. _____ Ft.

Sand _____

Gas _____

Oil _____

Total Depth _____

PRODUCTION

1st 24 hrs. Nat. _____

1st 24 hrs. after shot _____

Gas _____ Cu. Ft.

Dry Hole _____


Abandoned _____

Date

JUN 22 1917, 191 *E. J. Crocker* Scout

Map No. _____ Sec. 4 Twp. 26 R. 5
 Well No. 5 Millhuiser Farm
Eldorado O & S. Company

NORTH

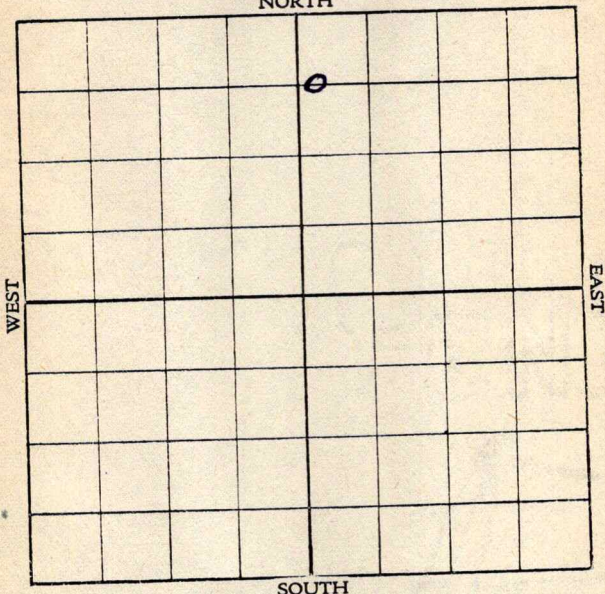

SOUTH

Location _____

Rig up _____

Drilling and remarks:

*SD for
Csg. 2280*

RECORD

Cased _____ in. _____ Ft.

Sand _____

Gas _____

Oil _____

Total Depth _____

PRODUCTION

1st 24 hrs. Nat. _____

1st 24 hrs. after shot _____

Gas _____ Cu. Ft.

Dry Hole _____

Abandoned _____

Date JUN 30 1917

, 191


E. J. Crocker Scout

Map No. _____ Sec. 4 Twp. 26 R. 5

Well No. 5 Millhiser Farm

Eldorado O & G Company

NORTH

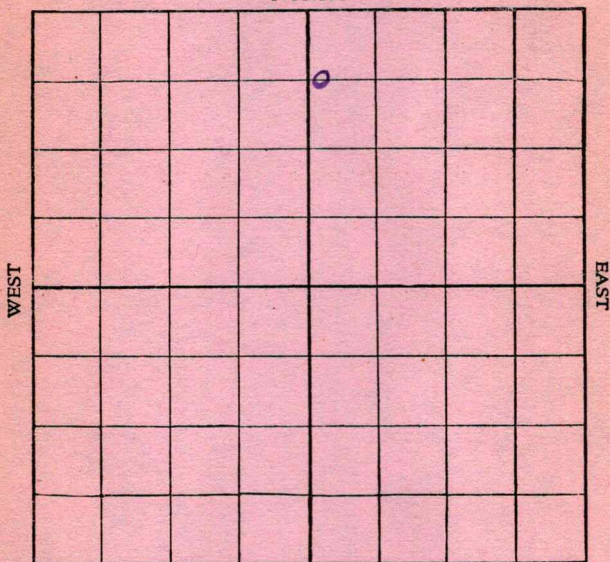

SOUTH

Location _____

Rig up _____

Drilling and remarks:

1/3-SD-2280

RECORD

Cased _____ in. _____ Ft.

Sand _____

Gas _____

Oil _____

Total Depth _____

PRODUCTION

1st 24 hrs. Nat. _____

1st 24 hrs. after shot _____

Gas _____ Cu. Ft.

Dry Hole _____

Abandoned _____


Date JUL 7 1917

, 191

G. T. Crocker Scout

Map No. _____ Sec. 4 Twp. 26 R. 5Well No. 5 Millheiser FarmEl Dorado, O. & G. Company

NORTH

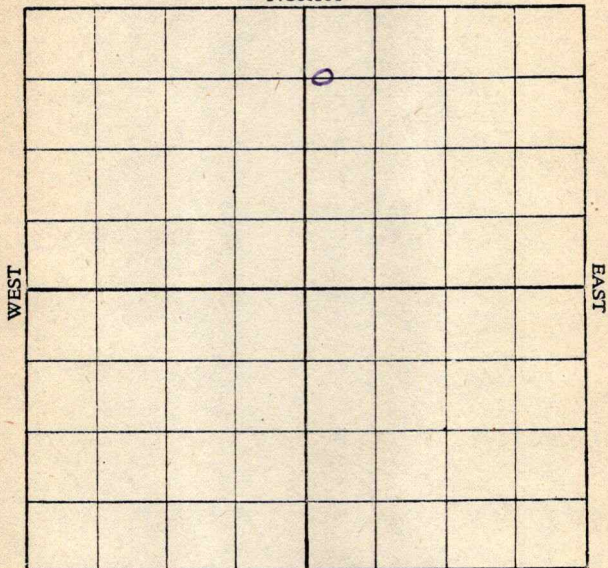

SOUTH

Location _____

Rig up _____

Drilling and remarks:

D-2300'

RECORD

Cased _____ in. _____ Ft.

Sand _____

Gas _____

Oil _____

Total Depth _____

PRODUCTION

1st 24 hrs. Nat. _____

1st 24 hrs. after shot _____

Gas _____ Cu. Ft.

Dry Hole _____


Abandoned _____

Date

JUL 14 1917, E. J. Crocker Scout

Map No. _____ Sec. 4 Twp. 26 R. 5
 Well No. 5 Millhiser Farm

NORTH

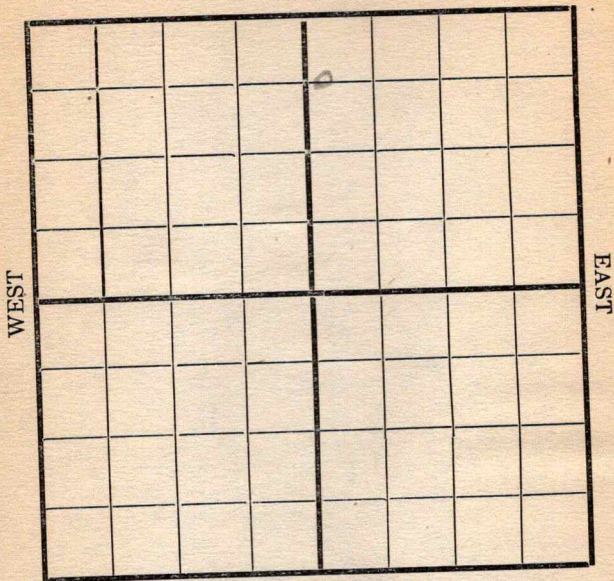

SOUTH

Location _____
 Rig Up _____
 Drilling and remarks

T.S. 2547

RECORD

Cased _____ in. _____ Ft.
 Sand _____
 Gas _____
 Oil _____
 Total Depth _____

PRODUCTION

1st 24 hrs. Nat. _____
 1st 24 hrs. after shot _____
 Gas _____ Cu. Ft.
 Dry Hole _____
 Abandoned _____

Date

8/1, 1917 Cordell Scout

Map No. _____ Sec. 4 Twp. 26 R. 5Well No. 5 Millheiser FarmE. D. Dando & Co. Company

NORTH

WEST

EAST

SOUTH

Location _____

Rig Up _____

Drilling and remarks

Top sand 2547

RECORD

Cased _____ in _____ Ft.

Sand _____

Gas _____

Oil _____

Total Depth _____

PRODUCTION

1st 24 hrs. Nat. _____

1st 24 hrs. after shot _____

Gas _____ Cu. Ft.

Dry Hole _____

Abandoned _____


Date

8/12, 1917 Carly Scout

Map No. _____ Sec. 4 Twp. 76 R. 5Well No. 5. Millheiser FarmCal. Dorado or 3 Company

NORTH

WEST

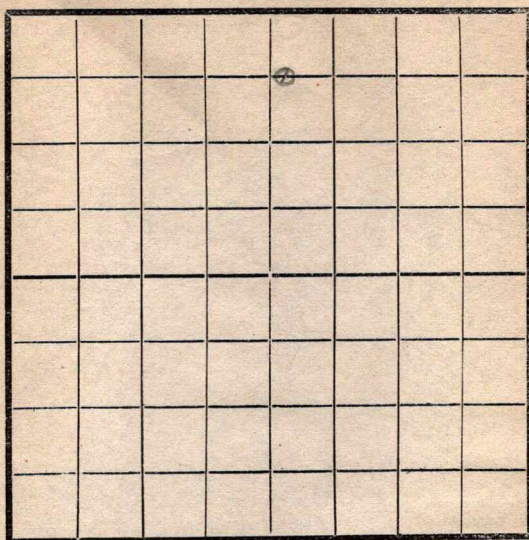

EAST

SOUTH

RECORD

Location _____

Cased _____ in. _____ Ft.

Rig Up _____

Sand _____

Drilling and remarks

Gas _____

Oil _____

Total Depth _____

PRODUCTION

1st 24 hrs. Nat. _____

1st 24 hrs. after shot _____

Gas _____ Cu. Ft.

Dry Hole _____

Abandoned _____

Date


8-23, 1917Hantz Scout

Map No. _____ Sec. 4 Twp. 26 R. 5
 Well No. 5. Millheiser Farm _____
El Dorado Company _____

NORTH

WEST

EAST

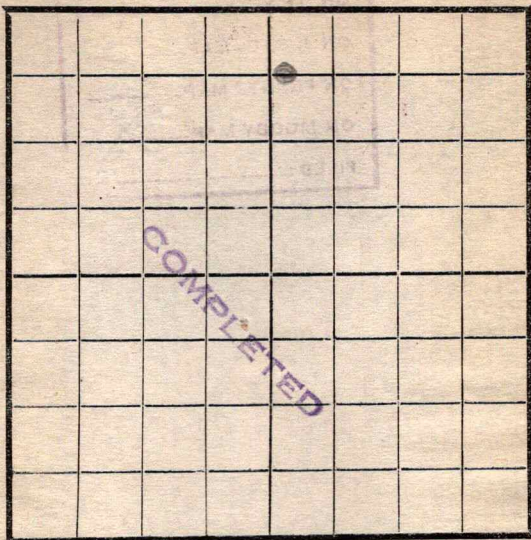

SOUTH

Location _____
 Rig Up _____
 Drilling and remarks _____

RECORD

Cased _____ in. _____ Ft.
 Sand 2493-2515
 Gas _____
 Oil ☒ _____
 Total Depth 2515

PRODUCTION

1st 24 hrs. Nat. 100 Bbls
 1st 24 hrs. after shot _____
 Gas _____ Cu. Ft.
 Dry Hole _____
 Abandoned _____

Date

8-29-1917 Lantz Scout _____