


Map No. \_\_\_\_\_ Sec. 9 Twp. 26 R. 8  
 Well No. 1 D. R. Blankenship Farm  
Cattlemen's Oil Company

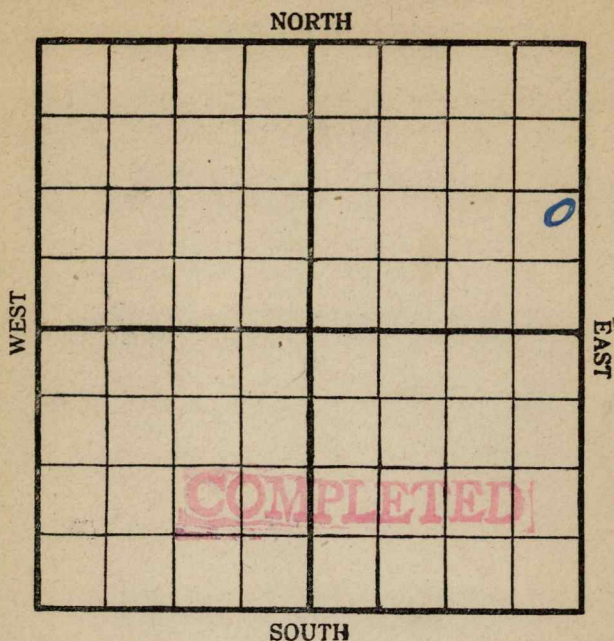

Location \_\_\_\_\_

Drilling Remarks:

\_\_\_\_\_

\_\_\_\_\_

\_\_\_\_\_

\_\_\_\_\_

\_\_\_\_\_

\_\_\_\_\_

\_\_\_\_\_

\_\_\_\_\_

\_\_\_\_\_

\_\_\_\_\_

Rig Up \_\_\_\_\_

Drilling Remarks:

\_\_\_\_\_

\_\_\_\_\_

\_\_\_\_\_

\_\_\_\_\_

\_\_\_\_\_

\_\_\_\_\_

\_\_\_\_\_

\_\_\_\_\_

\_\_\_\_\_

\_\_\_\_\_

**RECORD**

Cased \_\_\_\_\_ in. \_\_\_\_\_ ft.

Sand \_\_\_\_\_

Gas \_\_\_\_\_

Oil \_\_\_\_\_

Total Depth \_\_\_\_\_

**PRODUCTION**

1st 24 hrs. Nat. \_\_\_\_\_

1st 24 hrs. after shot \_\_\_\_\_

Gas \_\_\_\_\_ cu. ft

Dry Hole \_\_\_\_\_

Abandoned \_\_\_\_\_

Map No. H15 Sec. 9 Twp. 26 R. 8  
 Well No. 1 W. P. Blankinship Farm  
Cattlemans Oil Company

NORTH

WEST

EAST

SOUTH

Location ✓  
 Rig Up \_\_\_\_\_  
 Drilling and remarks \_\_\_\_\_

## RECORD

Cased \_\_\_\_\_ in. \_\_\_\_\_ Ft.  
 Sand \_\_\_\_\_  
 Gas \_\_\_\_\_  
 Oil \_\_\_\_\_  
 Total Depth \_\_\_\_\_

## PRODUCTION

1st 24 hrs. Nat. \_\_\_\_\_  
 1st 24 hrs. after shot \_\_\_\_\_  
 Gas \_\_\_\_\_ Cu. Ft.  
 Dry Hole \_\_\_\_\_  
 Abandoned \_\_\_\_\_

Date

4/2/10 1918

Tyler Scout

Well No. 1 Blankenship

Cattleman's Oil Company

## Contractor

NORTH

WEST

EAST

SOUTH

Location \_\_\_\_\_

Rig up \_\_\_\_\_

Drilling and Remarks:

## RECORD

Cased\_\_\_\_\_in., \_\_\_\_\_ft.

Sand\_\_\_\_\_

Gas .....

Oil \_\_\_\_\_

Total Depth.....

## PRODUCTION

1st 24 hrs. Nat. -----

1st 24 hrs. after shot-----

Gas.....Cu. Ft.

Dry Hole.....

Abandoned.....

Date \_\_\_\_\_

191

Scout

Map No. \_\_\_\_\_ Sec. 9 Twp. 26 R. 8Well No. 1 BlankinshipCattlemans Oil CompanyF. E. Miller Leona Ks Contractor

NORTH

WEST

EAST

SOUTH

Location \_\_\_\_\_

Rig up \_\_\_\_\_

Drilling and Remarks:

moving in  
tools

## RECORD

Cased \_\_\_\_\_ in., \_\_\_\_\_ ft.

Sand \_\_\_\_\_

Gas \_\_\_\_\_

Oil \_\_\_\_\_

Total Depth \_\_\_\_\_

## PRODUCTION

1st 24 hrs. Nat. \_\_\_\_\_

1st 24 hrs. after shot \_\_\_\_\_

Gas \_\_\_\_\_ Cu. Ft.

Dry Hole \_\_\_\_\_

Abandoned \_\_\_\_\_

Date

6/141918Cyle Scout

Map No. \_\_\_\_\_ Sec. 9 Twp. 26 R. 8  
 Well No. 1 Blankinship  
Cattlemans Oil Company  
 \_\_\_\_\_ Contractor

NORTH

WEST

EAST

SOUTH

Location \_\_\_\_\_

Rig up \_\_\_\_\_

Drilling and Remarks:

*Tools in*

## RECORD

Cased \_\_\_\_\_ in., \_\_\_\_\_ ft.

Sand \_\_\_\_\_

Gas \_\_\_\_\_

Oil \_\_\_\_\_

Total Depth \_\_\_\_\_

## PRODUCTION

1st 24 hrs. Nat. \_\_\_\_\_

1st 24 hrs. after shot \_\_\_\_\_

Gas \_\_\_\_\_ Cu. Ft.

Dry Hole \_\_\_\_\_

Abandoned \_\_\_\_\_


Date

6/18 1918 8 Cyle Scout

Map No. \_\_\_\_\_ Sec. 9 Twp. 26 R. 8Well No. 1 BlankinshipCattlemans Oil Company

Contractor \_\_\_\_\_

NORTH

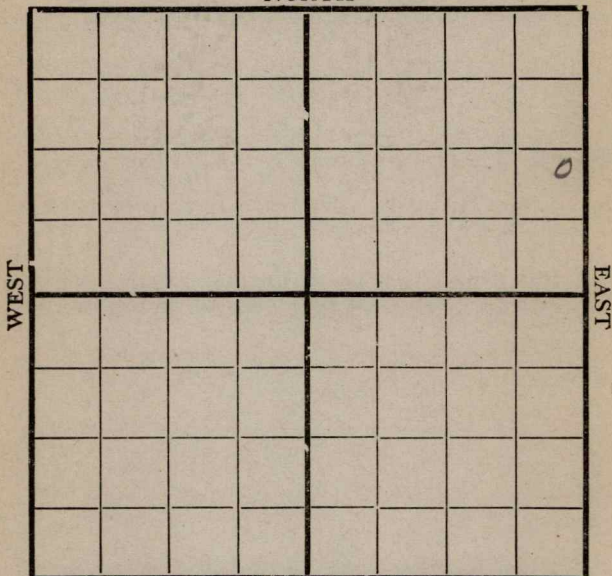

SOUTH

Location \_\_\_\_\_

Rig up \_\_\_\_\_

Drilling and Remarks:

*Spudding*

## RECORD

Cased \_\_\_\_\_ in., \_\_\_\_\_ ft.

Sand \_\_\_\_\_

Gas \_\_\_\_\_

Oil \_\_\_\_\_

Total Depth \_\_\_\_\_

## PRODUCTION

1st 24 hrs. Nat. \_\_\_\_\_

1st 24 hrs. after shot \_\_\_\_\_

Gas \_\_\_\_\_ Cu. Ft.

Dry Hole \_\_\_\_\_

Abandoned \_\_\_\_\_

Date

6/25 1918 Tyler Scout

Map No. \_\_\_\_\_ Sec. 9 Twp. 26 R. 8  
 Well No. 1 Blankenship Farm  
Cattleman's Oil Company

NORTH

WEST

EAST

SOUTH

Location \_\_\_\_\_  
 Rig Up \_\_\_\_\_  
 Drilling and remarks

230'

## RECORD

Cased \_\_\_\_\_ in. \_\_\_\_\_ Ft.  
 Sand \_\_\_\_\_  
 Gas \_\_\_\_\_  
 Oil \_\_\_\_\_  
 Total Depth \_\_\_\_\_

## PRODUCTION

1st 24 hrs. Nat. \_\_\_\_\_  
 1st 24 hrs. after shot \_\_\_\_\_  
 Gas \_\_\_\_\_ Cu. Ft.  
 Dry Hole \_\_\_\_\_  
 Abandoned \_\_\_\_\_


Date

7/2, 1918 Pyle Scout

Map No. \_\_\_\_\_ Sec. 9 Twp. 24 R. 8Well No. 1 Blankinship FarmCattleman's Oil Company

NORTH

WEST

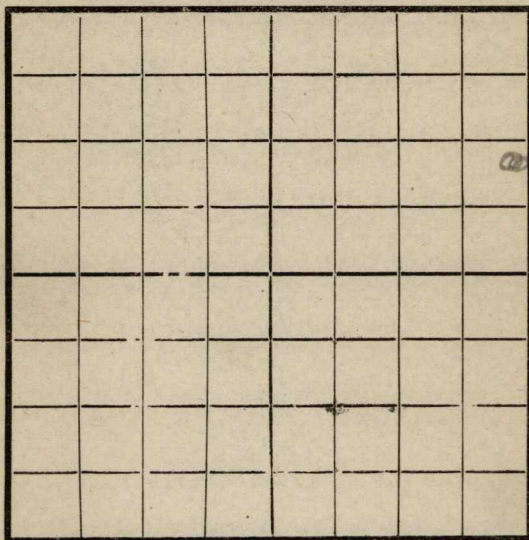

EAST

SOUTH

Location \_\_\_\_\_

Rig Up \_\_\_\_\_

Drilling and remarks

800"

## RECORD

Cased \_\_\_\_\_ in. \_\_\_\_\_ Ft.

Sand \_\_\_\_\_

Gas \_\_\_\_\_

Oil \_\_\_\_\_

Total Depth \_\_\_\_\_

## PRODUCTION

1st 24 hrs. Nat. \_\_\_\_\_

1st 24 hrs. after shot \_\_\_\_\_

Gas \_\_\_\_\_ Cu. Ft.

Dry Hole \_\_\_\_\_

Abandoned \_\_\_\_\_

Date

7/11, 1918Oyle

Scout

Map No. \_\_\_\_\_ Sec. 9 Twp. 26 R. 8  
 Well No. 1 Blankinship  
Cattlemans Oil Company  
 Contractor \_\_\_\_\_

NORTH

WEST

EAST

SOUTH

Location \_\_\_\_\_

Rig up \_\_\_\_\_

Drilling and Remarks:

1100'

## RECORD

Cased \_\_\_\_\_ in., \_\_\_\_\_ ft.

Sand \_\_\_\_\_

Gas \_\_\_\_\_

Oil \_\_\_\_\_

Total Depth \_\_\_\_\_

## PRODUCTION

1st 24 hrs. Nat. \_\_\_\_\_

1st 24 hrs. after shot \_\_\_\_\_

Gas \_\_\_\_\_ Cu. Ft.

Dry Hole \_\_\_\_\_

Abandoned \_\_\_\_\_

Date


7/16 1918

Pyle Scout

Map No. \_\_\_\_\_ Sec. 9 Twp. 26 R. 8  
 Well No. 1 Blankenship  
Cattleman's Oil Company  
 \_\_\_\_\_ Contractor

NORTH

WEST

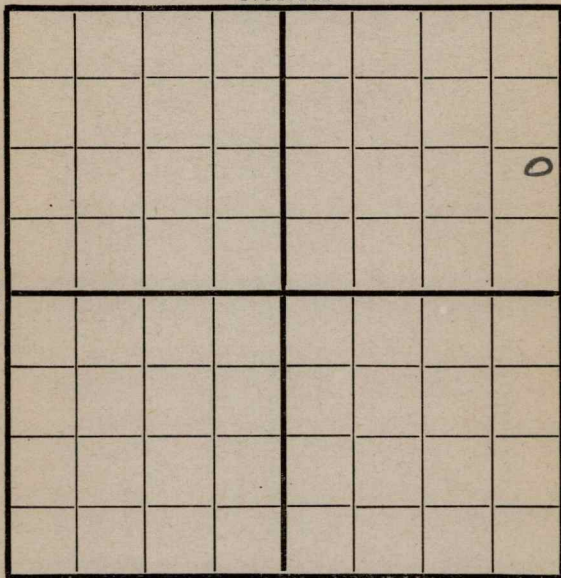

EAST

SOUTH

Location \_\_\_\_\_

Rig up \_\_\_\_\_

Drilling and Remarks:

D. N. @  
1200 for  
water

## RECORD

Cased \_\_\_\_\_ in., \_\_\_\_\_ ft.

Sand \_\_\_\_\_

Gas \_\_\_\_\_

Oil \_\_\_\_\_

Total Depth \_\_\_\_\_

## PRODUCTION

1st 24 hrs. Nat. \_\_\_\_\_

1st 24 hrs. after shot \_\_\_\_\_

Gas \_\_\_\_\_ Cu. Ft.

Dry Hole \_\_\_\_\_

Abandoned \_\_\_\_\_

Date

7/25 1918


C. L. H. Scout

Map No. \_\_\_\_\_ Sec. 9 Twp. 26 R. 8Well No. 1 BlankinshipCattlemans Oil Company

Contractor \_\_\_\_\_

NORTH

WEST

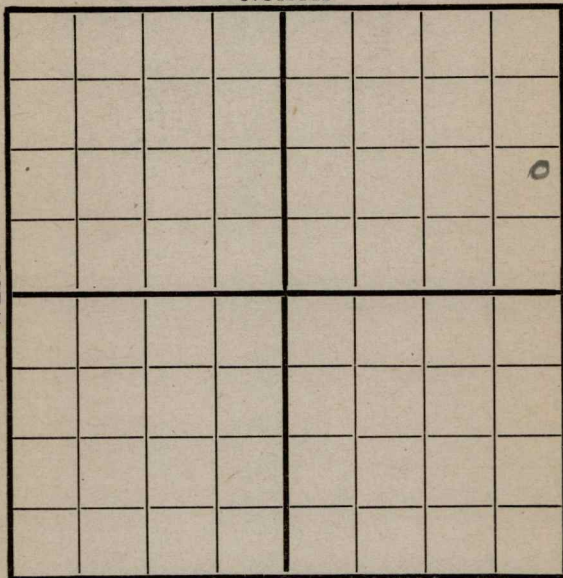

EAST

SOUTH

Location 1070 ARig up 250 E

Drilling and Remarks:

1350'

## RECORD

Cased \_\_\_\_\_ in., \_\_\_\_\_ ft.

Sand \_\_\_\_\_

Gas \_\_\_\_\_

Oil \_\_\_\_\_

Total Depth \_\_\_\_\_

## PRODUCTION

1st 24 hrs. Nat. \_\_\_\_\_

1st 24 hrs. after shot \_\_\_\_\_

Gas \_\_\_\_\_ Cu. Ft.

Dry Hole \_\_\_\_\_

Abandoned \_\_\_\_\_


Date

8/2 1918 Cyler Scout

Map No. \_\_\_\_\_ Sec. 9 Twp. 26 R. 8Well No. 1 BlankinshipCattlemans Oil Company

Contractor \_\_\_\_\_

NORTH

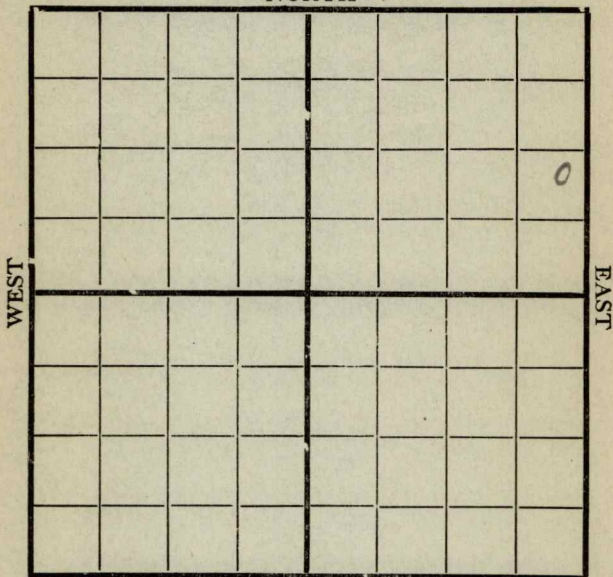

SOUTH

Location 1070' 250'

Rig up \_\_\_\_\_

Drilling and Remarks:

D. W. @  
1400' for  
water

## RECORD

Cased \_\_\_\_\_ in., \_\_\_\_\_ ft.

Sand \_\_\_\_\_

Gas \_\_\_\_\_

Oil \_\_\_\_\_

Total Depth \_\_\_\_\_

## PRODUCTION

1st 24 hrs. Nat. \_\_\_\_\_

1st 24 hrs. after shot \_\_\_\_\_

Gas \_\_\_\_\_ Cu. Ft.

Dry Hole \_\_\_\_\_

Abandoned \_\_\_\_\_

Date

8/8 191T. Oyle Scout

Map No. \_\_\_\_\_ Sec. 9 Twp. 26 R. 8  
 Well No. 1 Blankinship  
Cattlemen's Oil Company  
 Contractor \_\_\_\_\_

NORTH

WEST

EAST

SOUTH

Location 1070 S 250 E

Rig up \_\_\_\_\_

Drilling and Remarks:

D. W. @  
1400'

## RECORD

Cased \_\_\_\_\_ in., \_\_\_\_\_ ft.

Sand \_\_\_\_\_

Gas \_\_\_\_\_

Oil \_\_\_\_\_

Total Depth \_\_\_\_\_

## PRODUCTION

1st 24 hrs. Nat. \_\_\_\_\_

1st 24 hrs. after shot \_\_\_\_\_

Gas \_\_\_\_\_ Cu. Ft.

Dry Hole \_\_\_\_\_

Abandoned \_\_\_\_\_

Date

1918

Scout

Map No. \_\_\_\_\_ Sec. 9 Twp. 26 R. 8Well No. 1 BlankinshipCattlemans Oil Company

Contractor \_\_\_\_\_

NORTH

WEST

EAST

SOUTH

Location \_\_\_\_\_

Rig up \_\_\_\_\_

Drilling and Remarks:

*N. D. @  
1400' for  
water*

## RECORD

Cased \_\_\_\_\_ in., \_\_\_\_\_ ft.

Sand \_\_\_\_\_

Gas \_\_\_\_\_

Oil \_\_\_\_\_

Total Depth \_\_\_\_\_

## PRODUCTION

1st 24 hrs. Nat. \_\_\_\_\_

1st 24 hrs. after shot \_\_\_\_\_

Gas \_\_\_\_\_ Cu. Ft.

Dry Hole \_\_\_\_\_

Abandoned \_\_\_\_\_

Date

1918

Pyle

Scout

Map No. K 15 Sec. 9 Twp. 26 S R. 8 E  
 Well No. 1 Blankinship  
Cattlemans Oil Company  
 Contractor

|       |  |  |  |  |  |  |  |
|-------|--|--|--|--|--|--|--|
| NORTH |  |  |  |  |  |  |  |
| WEST  |  |  |  |  |  |  |  |
|       |  |  |  |  |  |  |  |
|       |  |  |  |  |  |  |  |
| SOUTH |  |  |  |  |  |  |  |

Location 1070 N  
250 W

Rig up

Drilling and Remarks:

D. R. to  
1430'

**RECORD**

Cased \_\_\_\_\_ in., \_\_\_\_\_ ft.  
 Sand \_\_\_\_\_  
 Gas \_\_\_\_\_  
 Oil \_\_\_\_\_  
 Total Depth \_\_\_\_\_

**PRODUCTION**

1st 24 hrs. Nat. \_\_\_\_\_  
 1st 24 hrs. after shot \_\_\_\_\_  
 Gas \_\_\_\_\_ Cu. Ft.  
 Dry Hole \_\_\_\_\_  
 Abandoned \_\_\_\_\_

Date

8/30

191

8

**Pyle**

Scout

Map No. 1415 Sec. 9 Twp. 26 R. 8Well No. 1 BlankenshipCattlemans Oil Company

Contractor

NORTH

WEST

EAST

SOUTH

Location \_\_\_\_\_

Rig up \_\_\_\_\_

Drilling and Remarks:

1070 from S250 to EStraight R.  
1430

## RECORD

Cased \_\_\_\_\_ in., \_\_\_\_\_ ft.

Sand \_\_\_\_\_

Gas \_\_\_\_\_

Oil \_\_\_\_\_

Total Depth \_\_\_\_\_

## PRODUCTION

1st 24 hrs. Nat. \_\_\_\_\_

1st 24 hrs. after shot \_\_\_\_\_

Gas \_\_\_\_\_ Cu. Ft.

Dry Hole \_\_\_\_\_

Abandoned \_\_\_\_\_

Date

9/8  
1918

Pyle

Scout

Map No. K15 Sec. 9 Twp. 26 R. 8  
 Well No. 1 Blankinship  
Cattlemans Oil Company  
 Contractor

|       |  |  |  |  |  |  |  |
|-------|--|--|--|--|--|--|--|
| NORTH |  |  |  |  |  |  |  |
| WEST  |  |  |  |  |  |  |  |
|       |  |  |  |  |  |  |  |
|       |  |  |  |  |  |  |  |
| SOUTH |  |  |  |  |  |  |  |
|       |  |  |  |  |  |  |  |
|       |  |  |  |  |  |  |  |
Location 1070' D  
250' E  
 Rig up  
 Drilling and Remarks:

D 10 @ 1430'

RECORD

Cased \_\_\_\_\_ in., \_\_\_\_\_ ft.  
 Sand \_\_\_\_\_  
 Gas \_\_\_\_\_  
 Oil \_\_\_\_\_  
 Total Depth \_\_\_\_\_

PRODUCTION

1st 24 hrs. Nat. \_\_\_\_\_  
 1st 24 hrs. after shot \_\_\_\_\_  
 Gas \_\_\_\_\_ Cu. Ft.  
 Dry Hole \_\_\_\_\_  
 Abandoned \_\_\_\_\_

Date


9/3

1918

**Pyle**

Scout

Map No. K15 Sec. 9 Twp. 26 R. 8  
 Well No. 1 Blankinship  
Cattlemans Oil Company  
 Contractor

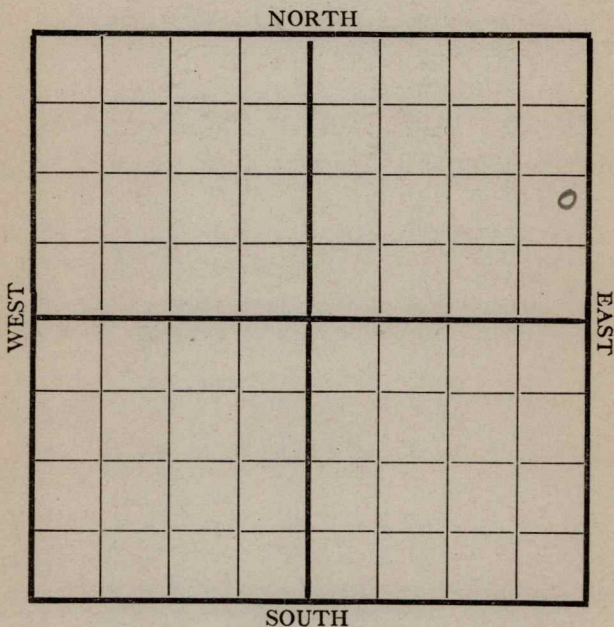

Location 1070' S  
250' E  
 Rig up \_\_\_\_\_  
 Drilling and Remarks:

D.D. @  
1500'

**RECORD**

Cased \_\_\_\_\_ in., \_\_\_\_\_ ft.  
 Sand \_\_\_\_\_  
 Gas \_\_\_\_\_  
 Oil \_\_\_\_\_  
 Total Depth \_\_\_\_\_

**PRODUCTION**

1st 24 hrs. Nat. \_\_\_\_\_  
 1st 24 hrs. after shot \_\_\_\_\_  
 Gas \_\_\_\_\_ Cu. Ft.  
 Dry Hole \_\_\_\_\_  
 Abandoned \_\_\_\_\_

Date

9/26 191 8


**Pyle**

Scout

Map No. K15 Sec. 9 Twp. 26 R. 8Well No. 1 BlankinshipCattlemans Oil Company

Contractor

NORTH

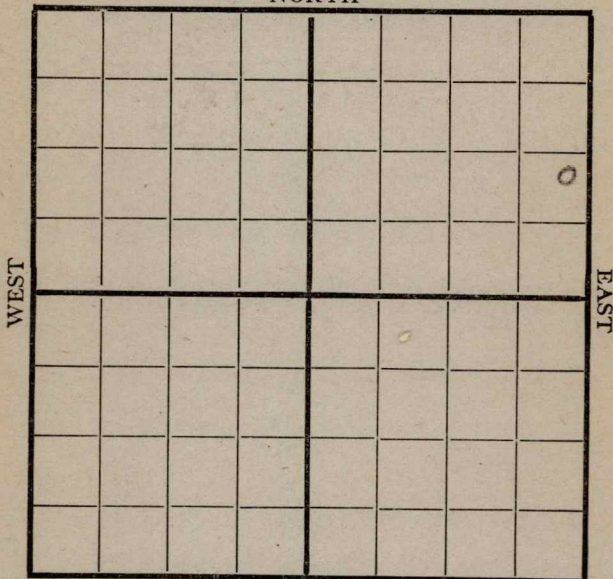

SOUTH

Location 1070' S250' E

Rig up

Drilling and Remarks:

## RECORD

Cased \_\_\_\_\_ in., \_\_\_\_\_ ft.

Sand \_\_\_\_\_

Gas \_\_\_\_\_

Oil \_\_\_\_\_

Total Depth \_\_\_\_\_

## PRODUCTION

1st 24 hrs. Nat. \_\_\_\_\_

1st 24 hrs. after shot \_\_\_\_\_

Gas \_\_\_\_\_ Cu. Ft.

Dry Hole \_\_\_\_\_

Abandoned \_\_\_\_\_

Date


9/20

191

5Pyle

Scout

Map No. K15 Sec. 9 Twp. 24 R. 8  
 Well No. 1 Blankinship  
Cattlemans' Oil Company  
 Contractor

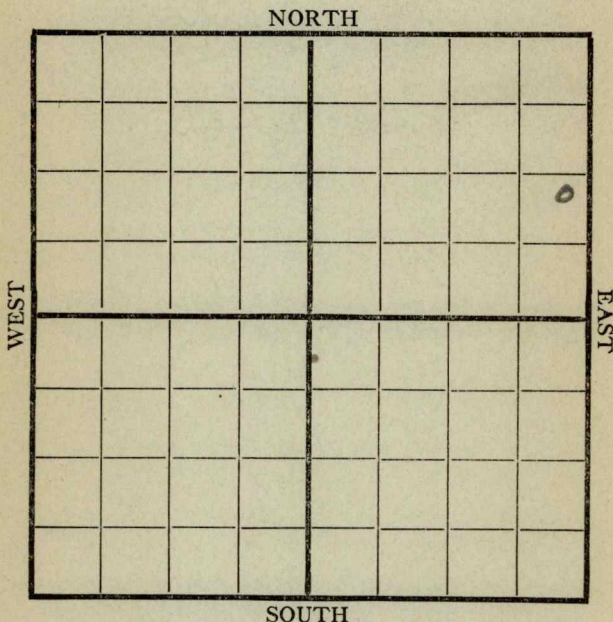

Location 1070-S  
250-E  
 Rig up \_\_\_\_\_  
 Drilling and Remarks:

D D @  
1500'

**RECORD**

Cased \_\_\_\_\_ in., \_\_\_\_\_ ft.  
 Sand \_\_\_\_\_  
 Gas \_\_\_\_\_  
 Oil \_\_\_\_\_  
 Total Depth \_\_\_\_\_

**PRODUCTION**

1st 24 hrs. Nat. \_\_\_\_\_  
 1st 24 hrs. after shot \_\_\_\_\_  
 Gas \_\_\_\_\_ Cu. Ft.  
 Dry Hole \_\_\_\_\_  
 Abandoned \_\_\_\_\_

Date

9/30 1918

**Pyle**

Scout

Map No. K15 Sec. 9 Twp. 26 R. 8  
 Well No. 1 Blankinship  
Cattlemans' Oil Company  
 Contractor

NORTH

WEST

EAST

SOUTH

Location 1070-S  
250-E  
 Rig up  
 Drilling and Remarks:

2 D @  
1500'

## RECORD

Cased \_\_\_\_\_ in., \_\_\_\_\_ ft.  
 Sand \_\_\_\_\_  
 Gas \_\_\_\_\_  
 Oil \_\_\_\_\_  
 Total Depth \_\_\_\_\_

## PRODUCTION

1st 24 hrs. Nat. \_\_\_\_\_  
 1st 24 hrs. after shot \_\_\_\_\_  
 Gas \_\_\_\_\_ Cu. Ft.  
 Dry Hole \_\_\_\_\_  
 Abandoned \_\_\_\_\_


Date

10/7 1918 Bylee Scout

Map No. 1515 Sec. 9 Twp. 26 R. 8  
 Well No. 1 Blankinship  
Cattlemans Oil Company  
 Contractor

NORTH

WEST

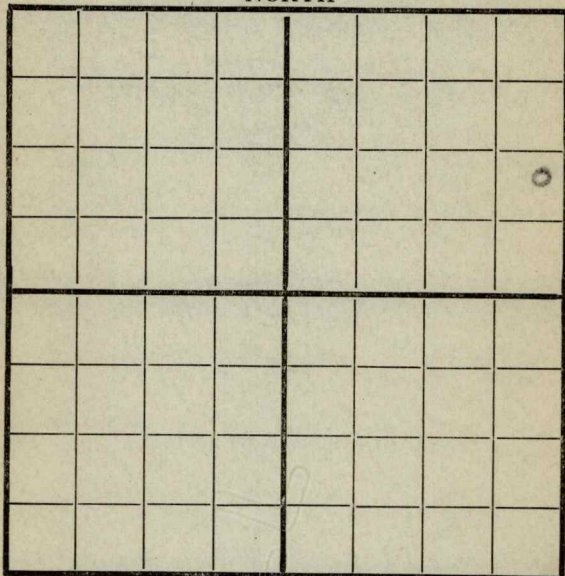

EAST

SOUTH

Location 1070-SRig up 250-E

Drilling and Remarks:

2225'

## RECORD

Cased.....in., .....ft.

Sand.....

Gas.....

Oil.....

Total Depth.....

## PRODUCTION

1st 24 hrs. Nat. ....

1st 24 hrs. after shot.....

Gas.....Cu. Ft.

Dry Hole.....

Abandoned.....

Date

10/14


191

8

Pyle

Scout

Map No. 1515 Sec. 9 Twp. 26 R. 8  
 Well No. 1 Blankinship  
Cattlemans Oil Company  
 Contractor

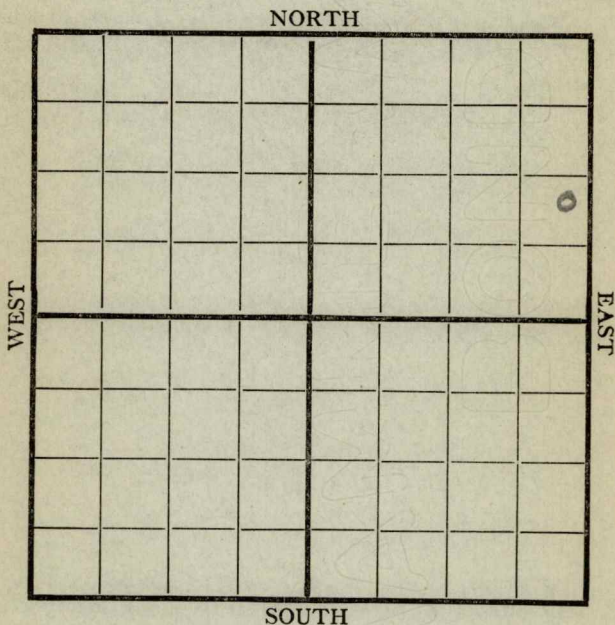Location 1070-SRig up 250-E

Drilling and Remarks:

11 @ 2320

## RECORD

Cased \_\_\_\_\_ in., \_\_\_\_\_ ft.

Sand \_\_\_\_\_

Gas \_\_\_\_\_

Oil \_\_\_\_\_

Total Depth \_\_\_\_\_

## PRODUCTION

1st 24 hrs. Nat. \_\_\_\_\_

1st 24 hrs. after shot \_\_\_\_\_

Gas \_\_\_\_\_ Cu. Ft.

Dry Hole \_\_\_\_\_

Abandoned \_\_\_\_\_


Date

10-25-1918Pyle Scout

Map No. K 15 Sec. 9 Twp. 26 R. 8Well No. 1 Blankenship  
Cattlemen's Oil Company

Contractor

NORTH

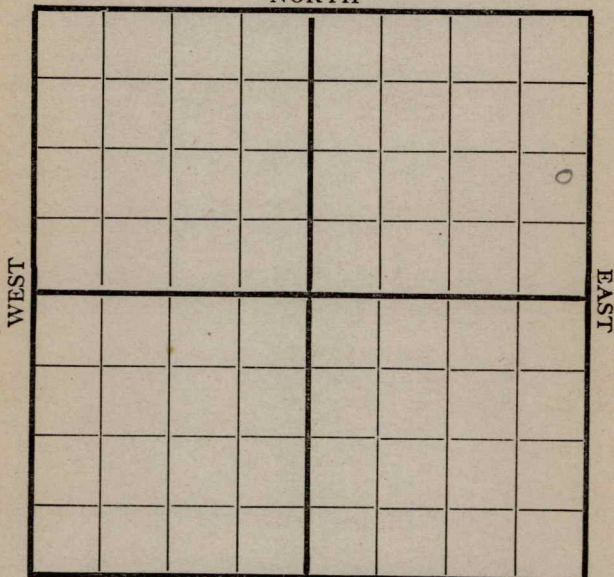

SOUTH

Location 1070-SRig up 250-E

Drilling and Remarks:

showing @  
2423-2429'llg @ 2465

## RECORD

Cased \_\_\_\_\_ in., \_\_\_\_\_ ft.

Sand \_\_\_\_\_

Gas \_\_\_\_\_

Oil \_\_\_\_\_

Total Depth \_\_\_\_\_

## PRODUCTION

1st 24 hrs. Nat. \_\_\_\_\_

1st 24 hrs. after shot \_\_\_\_\_

Gas \_\_\_\_\_ Cu. Ft.

Dry Hole \_\_\_\_\_

Abandoned \_\_\_\_\_

Date

11/2 1918

Pyle

Scout

Map No. K15 Sec. 9 Twp. 26 R. 8Well No. 1 BlankenshipCattlemens' Oil Company

Contractor

NORTH

WEST

EAST

SOUTH

Location 1070-S250-E

Drilling and Remarks:

2390 } shot 65  
 2410 } gts

2473 } shot  
 2493 } 100 gts

## RECORD

Cased \_\_\_\_\_ in., \_\_\_\_\_ ft.

Sand \_\_\_\_\_

Gas \_\_\_\_\_

Oil \_\_\_\_\_

Total Depth 2502

## PRODUCTION

1st 24 hrs. Nat. \_\_\_\_\_

1st 24 hrs. after shot \_\_\_\_\_

Gas \_\_\_\_\_ Cu. Ft.

Dry Hole \_\_\_\_\_

Abandoned \_\_\_\_\_

Date

Good showing now cleaning out11/9 1918

Pyle

Scout

Map No. K15 Sec. 9 Twp. 26 R. 8

Well No. 1 Blankinship  
Cattlemen's Oil Company

## Contractor

NORTH

WEST

EAST

SOUTH

Location 1070-S

Rig up 250 - E

Drilling and Remarks:

2390 } oil sand  
2410 }

2473 } Oil sand  
2493 }

## RECORD

Cased-----in., -----ft.

Sand\_\_\_\_\_

Gas \_\_\_\_\_

Oil \_\_\_\_\_

Total Depth 2502

## PRODUCTION

1st 24 hrs. Nat. -----

1st 24 hrs. after shot-----

Gas\_\_\_\_\_Cu. Ft.

## Dry Hole

Abandoned.....

Date \_\_\_\_\_

191

Scout


Pyle

Map No. K 15 Sec. 9 Twp. 26 R. 8  
 Well No. 1 Blankenship  
Cattlemen's Oil Company  
 Contractor

NORTH

WEST

EAST

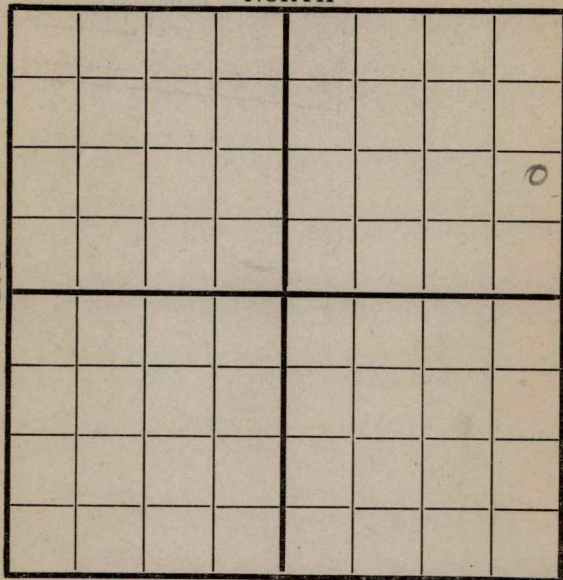

SOUTH

1070-S

250-E

Location \_\_\_\_\_

Rig up \_\_\_\_\_

Drilling and Remarks:

2390 } shot  
 2410 } 165 gals

2473 } looks  
 2493 } like  
 50 bbl  
 well

RECORD

Cased \_\_\_\_\_ in., \_\_\_\_\_ ft.

Sand \_\_\_\_\_

Gas \_\_\_\_\_

Oil \_\_\_\_\_

Total Depth 2502

PRODUCTION

1st 24 hrs. Nat. \_\_\_\_\_

1st 24 hrs. after shot \_\_\_\_\_

Gas \_\_\_\_\_ Cu. Ft.

Dry Hole \_\_\_\_\_

Abandoned \_\_\_\_\_

Date

11/1/22 1918

Oyle

Scout

Map No. K15 Sec. 9 Twp. 26 R. 8

Well No. 1 Blankinship  
Cattlemen's Oil Company

Company

Contractor

NORTH

WEST

# FEAST

# SOUTH

1070-S

250-E

Location \_\_\_\_\_

Rig up-----

Drilling and Remarks:

2340 }  
2410 }

2410)

2473  
2493

2493

Tubing

## RECORD

Cased\_\_\_\_\_in., \_\_\_\_\_ft.

Sand

Gas

Oil

Total Depth 2502

## PRODUCTION

1st 24 hrs. Nat.

1st 24 hrs. after shot

Gas.....Cu. Ft.

## Dry Hole

## Abandoned

Date \_\_\_\_\_

11/

191

Pyle


Scout

Map No. K15 Sec. 9 Twp. 26 R. 8Well No. 1 Blankenship  
Cattlemens' Oil Company

Contractor

NORTH

WEST

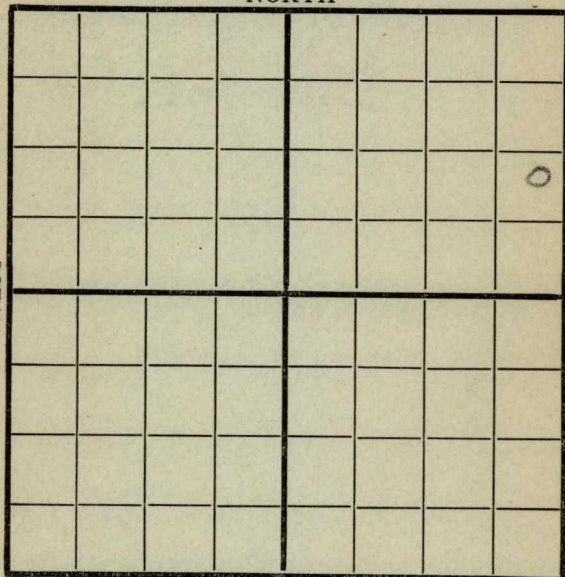

EAST

SOUTH

1070-S

250-E

Location

Rig up

Drilling and Remarks:

2390 - 2410

2473 - 2493

NO casing  
trouble

## RECORD

Cased \_\_\_\_\_ in., \_\_\_\_\_ ft.

Sand \_\_\_\_\_

Gas \_\_\_\_\_

Oil \_\_\_\_\_

Total Depth 2502

## PRODUCTION

1st 24 hrs. Nat. \_\_\_\_\_

1st 24 hrs. after shot \_\_\_\_\_

Gas \_\_\_\_\_ Cu. Ft.

Dry Hole \_\_\_\_\_

Abandoned \_\_\_\_\_

Date

12/2 1918

Pyle Scout


Map No. K15 Sec. 9 Twp. 26 R. 8Well No. 1 Blankinship  
Cattlemen's Oil Company

Contractor

NORTH

WEST

EAST

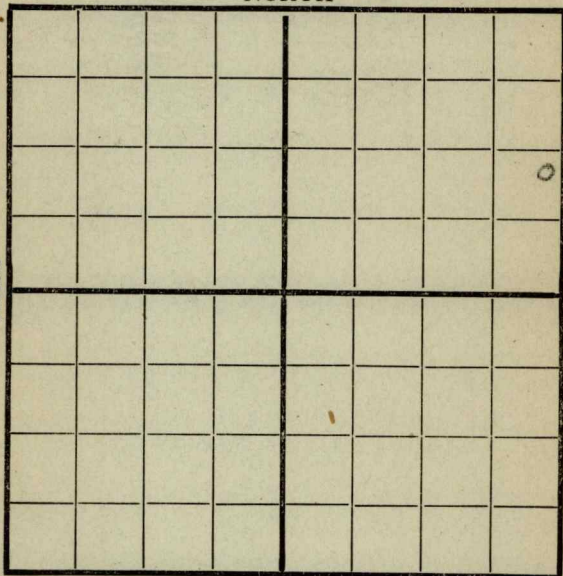

SOUTH

1070-S

250-E

Location

Rig up

Drilling and Remarks:

having  
trouble with  
6" casing.  
D.D.

## RECORD

Cased \_\_\_\_\_ in. \_\_\_\_\_ ft.

Sand 2340 - 24732410 - 2443

Gas \_\_\_\_\_

Oil \_\_\_\_\_

Total Depth 2502

## PRODUCTION

1st 24 hrs. Nat. \_\_\_\_\_

1st 24 hrs. after shot \_\_\_\_\_

Gas \_\_\_\_\_ Cu. Ft.

Dry Hole \_\_\_\_\_

Abandoned \_\_\_\_\_

Date

12/9

1918

H. B.

Scout

Map No. K 15 Sec. 9 Twp. 26 R. 8  
 Well No. 1 Blankinship  
Cattlemen's Oil Company  
 Contractor

NORTH

WEST

EAST

COMPLETED

SOUTH

1070 S

250 E

Location \_\_\_\_\_

Rig up \_\_\_\_\_

Drilling and Remarks:

Shot 165 gts

## RECORD

Cased \_\_\_\_\_ in., \_\_\_\_\_ ft.

Sand 2390 } { 2473  
2410 } { 2493

Gas \_\_\_\_\_

Oil \_\_\_\_\_

Total Depth 2502

## PRODUCTION

1st 24 hrs. Nat. \_\_\_\_\_

1st 24 hrs. after shot 50 bbls

Gas \_\_\_\_\_ Cu. Ft.

Dry Hole \_\_\_\_\_

Abandoned \_\_\_\_\_

Date

12/17 1918

Pyle

Scout