

NORTH

WEST

EAST

SOUTH

Location _____

Drilling Remarks

Rig Up _____

Drilling Remarks

RECORD

Cased _____ in. _____ ft.

Sand _____

Gas_____

Oil _____

Total Depth_____

PRODUCTION

1st 24 hrs. Nat. _____

1st 24 hrs. after shot_____


Gas _____ cu. ft. _____

Dry Hole_____

Abandoned _____

Map No. KANSAS Sec. 20 Twp. 26 R. 5^E
 Well No. 93 - Hoagler Farm
Empire O & R Company

NORTH

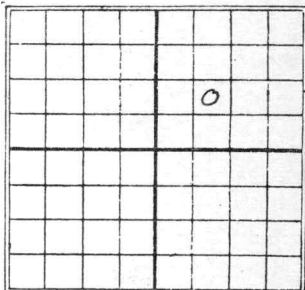

Ft. from N. Line

990 Ft. from S. Line

Ft. from E. Line

990 Ft. from W. Line

Date

REPORT

12/30	Bldg Rig
1/30	
1/8	Rig up
1/15	
1/22	
1/29	Spdg. 315'
2/4	Drilg. 1165'
2/11	" 1850'
2/19	" 2230'
2/26	set 6"-2457'
3/5	Top Viola 2457'- Sand
	2483-2547'- Shot 110
	gts - Seg. out.
3/12	Top Viola 2457'
	Pay 2483-2547'
	T.D. 2547'
	shot 110 gts
	75 bbl oil
	Comp.

Butler

E

Map No. KANSAS Sec. 20 Twp. 76 R. 5Well No. 93 BeaglerEmpire Drilling Co Company

Contractor

FIRST REPORTS

Ft. from N. Line

990 Ft. from S. Line

Ft. from E. Line

990 Ft. from W. Line

SECTION PLAT

		o	

Location Blady Ky

Rig up

Drilling and Remarks:

RECORD

Cased _____ in., _____ ft.

Sand _____

Gas _____

Oil _____

Total Depth _____

PRODUCTION

1st 24 hrs. Nat. _____

1st 24 hrs. after shot _____

Gas _____ Cu. Ft.

Dry Hole _____

Abandoned _____

Date

DEC 30 1929

192

CHAS. L. SHERWOOD

Scout

Map No. KANSAS Sec. 20 Twp. 76 R. 5
 Well No. 93 Boogler
Empire Dr Company
 Contractor

COMPLETE

SECTION PLAT

		o	

Ft. from N. Line

990 Ft. from S. Line

Ft. from E. Line

990 Ft. from W. Line

Location

Rig up

Drilling and Remarks:

top Viola 7457110 / 75 Bls.

RECORD

Cased in., ft.

Sand 7483-7547

Gas

Oil

Total Depth 7547

PRODUCTION

1st 24 hrs. Nat.

1st 24 hrs. after shot

Gas Cu. Ft.

Dry Hole

Abandoned

Date

MAR 12 1930

192

CHAS. L. SHERWOOD

Scout