

KANSAS

Greenwood

FORM 51 5M 4-41 PETROL

Section 22 Township 26 Range 13-EWell No. 3 KellerCompany Dunn**Miscellaneous**

NORTH

WEST

EAST

			0				

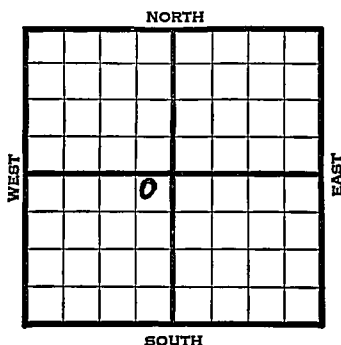
SOUTH

KANSAS

Greenwood

Sec. 22 Twp. 26 R. 13-EWell No. #3 Keller FarmDunn Company

(Misc.)

200 Ft. from N. Line Ft. from S. Line460 Ft. from E. Line Ft. from W. Line

1941	REPORT
5/7	Location
5/15	"
5/22	"
5/28	"
6/5	Machine.
6/12	"
6/19	10" - 135' Drlg. 625'
6/26	8" - 842' Drlg. 845'
7/3	Drlg. 1175'
7/10	Bart. 1448' 6" - 1448'
	Miss. 1489'
	TD 1506' SD.
7/16	Miss. 1489'
	T.D. 1506'
	Water.
	ABANDONED

Map No. 17 Sec. 22 Twp. 26 R. 13EWell No. 3 KellerDunn

Company

~~FIRST REPORT~~

Contractor

NE SW

SECTION PLAT

	0		

200 Ft. from N. Line Ft. from S. Line460 Ft. from E. Line Ft. from W. Line

MISCELLANEOUS

Location XRig up

Drilling and Remarks:

RECORD

Cased in., ft.Sand Gas Oil Total Depth

PRODUCTION

1st 24 hrs. Nat. 1st 24 hrs. after shot Gas Cu. Ft.Dry Hole Abandoned

Date

MAY 7 1941 19S. J. LEWIS

Scout

Map No. 17 Sec. 22 Twp. 26 R. 13EWell No. 3 KellerDunn

Company

Contractor

ABANDONED

NE SW

200 Ft. from N. Line

Ft. from S. Line

460 Ft. from E. Line

Ft. from W. Line

MISCELLANEOUS

SECTION PLAT

	0		

Location

Rig up

Drilling and Remarks:

*Mine 1489**Water*

RECORD

Cased _____ in., _____ ft.

Sand _____

Gas _____

Oil _____

Total Depth 1506

PRODUCTION

1st 24 hrs. Nat. _____

1st 24 hrs. after shot _____

Gas _____ Cu. Ft.

Dry Hole _____

Abandoned _____

Date

JUL 16 1941 19S. J. LEWIS

Scout