

Well No. 1 Weirshing Farm
Miller & Carlson Company

Andrew — ~~North~~ Miller

WEST

EAST

SOUTH

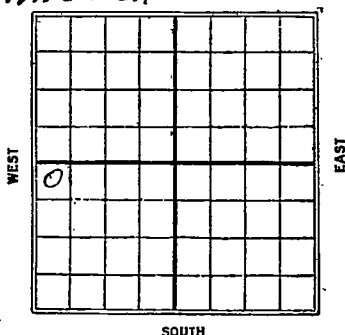
Drilling Remarks

Abandoned _____

Map No. _____ Sec. 24 Twp. 26 R. 9Well No. 1 Wersling Farm
Miller & Dargatzis CompanyAndrew NORTH250' Ft. from N. Line

_____ Ft. from S. Line

_____ Ft. from E. Line

250' Ft. from W. Line1925

Date

REPORT

10/1 1 Qrly @ 275'10/5 _____10/16 ✓ = 140011/6 Sand 2208-2220 2100
feet oil in hole11/13 Tap line pay 2208-2231 70,
pumped 120 bbls 1st 10 hrs
S.D. engine trouble12/3 Sand 2208-2231Pumping 100 Bbls

Sherwood Co
KANSAS
 Map No. _____ Sec. *24* Twp. *26* R. *9*
 Well No. *1* *Neorshing*
Miller & Carlson Company

Contractor

FIRST REPORTS

SECTION PLAT

250 Ft. from N. Line
 _____ Ft. from S. Line
 _____ Ft. from E. Line
250 Ft. from W. Line

0			

Location _____

Rig up _____

Drilling and Remarks:

Only 275'

RECORD

Cased _____ in., _____ ft.

Sand _____

Gas _____

Oil _____

Total Depth _____

PRODUCTION

1st 24 hrs. Nat. _____

1st 24 hrs. after shot _____

Gas _____ Cu. Ft.

Dry Hole _____

Abandoned _____

Date

OCT 1 1925

192

CHAS. L. SHERWOOD

Scout

Johnsonwood Co
 K15 KANSAS Map No. _____ Sec. *24* Twp. *26* R. *9*

Well No. *1* *Hoix Sheng*
and New Millers Company _____ Contractor _____

CORRECTION

SECTION PLAT

250 Ft. from N. Line

_____ Ft. from S. Line

_____ Ft. from E. Line

250 Ft. from W. Line

6			

Location _____

Rig up _____

Drilling and Remarks:

2100' Oil in hole.

chg ownership

to above.

RECORD

Cased _____ in. _____ ft.

Sand *2208-2220'*

Gas _____

Oil _____

Total Depth *2220'*

PRODUCTION

1st 24 hrs. Nat. _____

1st 24 hrs. after shot _____

Gas _____ Cu. Ft.

Dry Hole _____

Abandoned _____

Date

NOV 6 1925

192

CHAS. L. SHERWOOD

Scout

Sherwood Co
 Map No. KANSAS Sec. 24 Twp. 26 R. 9
 Well No. 1 *Washing*
Andrew Milbr Company

Contractor

COMPLETED

SECTION PLAT

250 Ft. from N. Line

_____ Ft. from S. Line

_____ Ft. from E. Line

250 Ft. from W. Line

0			

Location _____

Rig up _____

Drilling and Remarks:

Pumping 100 bks.

RECORD

Cased _____ in., _____ ft.

Sand 2208-2231'

Gas _____

Oil _____

Total Depth 2231'

PRODUCTION

1st 24 hrs. Nat. _____

1st 24 hrs. after shot _____

Gas _____ Cu. Ft.

Dry Hole _____

Abandoned _____

Date

DEC 3 1925

CHAS. L. SHERWOOD

192

Scout