


Map No. _____ Sec. 4 Twp. 26 R. 5Well No. 2 Thompson FarmEmpire Company

NORTH

WEST

EAST

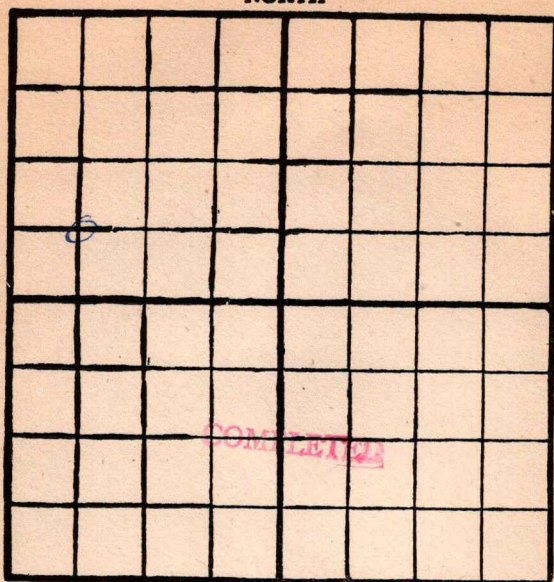

SOUTH

Location _____

Rig Up _____

Drilling Remarks:

Drilling Remarks:

RECORD

Cased _____ in. _____ ft.

Sand _____

Gas _____

Oil _____

Total Depth _____

PRODUCTION

1st 24 hrs. Nat. _____

1st 24 hrs. after shot _____

Gas _____ cu. ft.

Dry Hole _____

Abandoned _____


Map No. K 14 Sec. 4 Twp. 26 R. 5Well No. 2 ThompsonEmpire Company

Contractor

NORTH

WEST

EAST

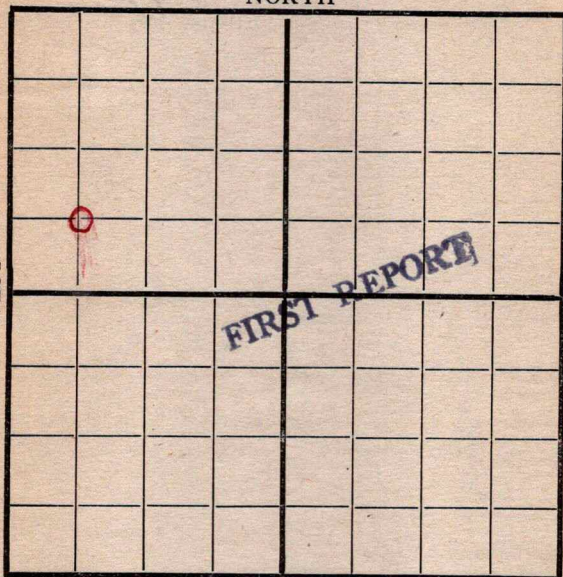

SOUTH

660 S-W

Location _____

Rig up ☒ _____

Drilling and Remarks:

RECORD

Cased _____ in., _____ ft.

Sand _____

Gas _____

Oil _____

Total Depth _____

PRODUCTION

1st 24 hrs. Nat. _____

1st 24 hrs. after shot _____

Gas _____ Cu. Ft.

Dry Hole _____

Abandoned _____

Date

12/191918Cycle Scout


Map No. K14 Sec. 4 Twp. 26 R. 5Well No. 2 Thompson
Empire Company

Contractor

NORTH

WEST

EAST

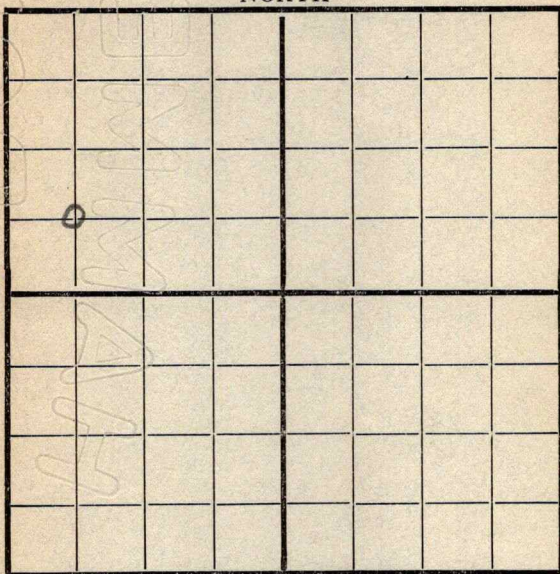

660-S-W SOUTH

Location _____

Rig up _____

Drilling and Remarks:

RECORD

Cased _____ in., _____ ft.

Sand _____

Gas _____

Oil _____

Total Depth _____

PRODUCTION

1st 24 hrs. Nat. _____

1st 24 hrs. after shot _____

Gas _____ Cu. Ft.

Dry Hole _____

Abandoned _____

Date

12/8 191

Pyle

Scout


Map No. K14 Sec. 4 Twp. 26 R. 5Well No. 2 ThompsonEmpire Company

Contractor

NORTH

WEST

EAST

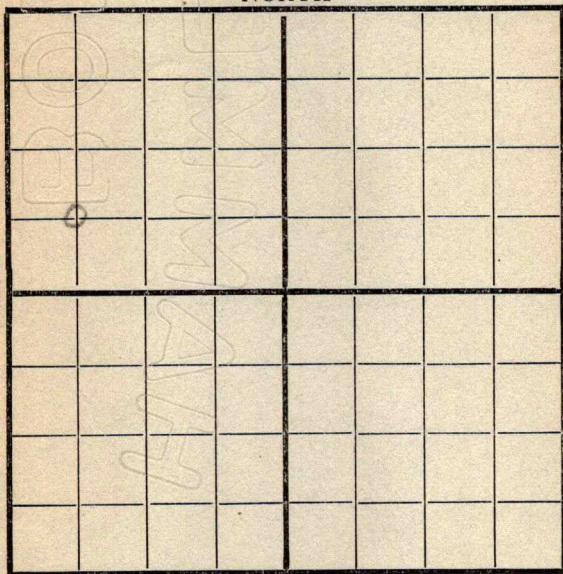

SOUTH

660-S-W

Location _____

Rig up _____

Drilling and Remarks:

RECORD

Cased _____ in., _____ ft.

Sand _____

Gas _____

Oil _____

Total Depth _____

PRODUCTION

1st 24 hrs. Nat. _____

1st 24 hrs. after shot _____

Gas _____ Cu. Ft.

Dry Hole _____

Abandoned _____

Date

Jan 16 1919

Pyle


Scout

Map No. K14 Sec. 14 Twp. 26 R. 5
 Well No. 2 Thompson
Empire Company
 Contractor

NORTH

WEST

EAST

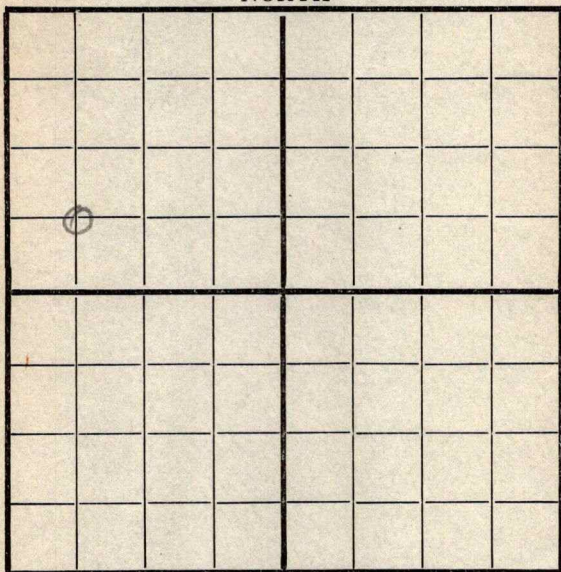

SOUTH

660 S-W

Location _____

Rig up _____

Drilling and Remarks:

1550'**RECORD**

Cased _____ in., _____ ft.

Sand _____

Gas _____

Oil _____

Total Depth _____

PRODUCTION

1st 24 hrs. Nat. _____

1st 24 hrs. after shot _____

Gas _____ Cu. Ft.

Dry Hole _____

Abandoned _____

Date

Jan 21 1919**Pyle**

Scout


Map No. K14 Sec. 4 Twp. 26 R. 5Well No. 2 ThompsonEmpire Company

Contractor

NORTH

WEST

EAST

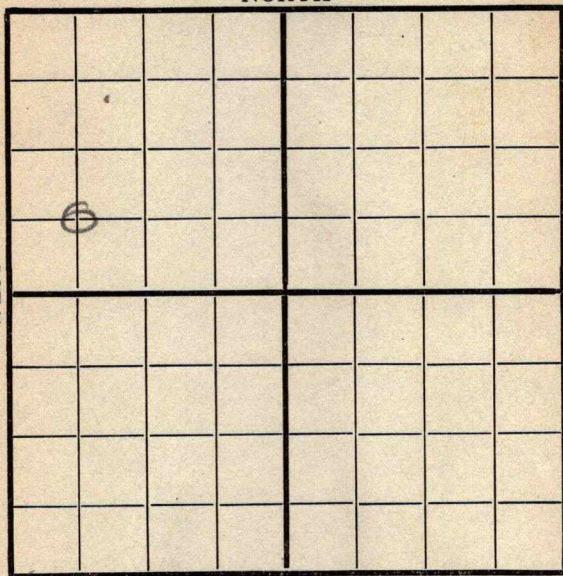

SOUTH

660 S-W

Location _____

Rig up _____

Drilling and Remarks:

D. 10bad road

RECORD

Cased _____ in. _____ ft.

Sand 2408-2463

Gas _____

Oil _____

Total Depth _____

PRODUCTION

1st 24 hrs. Nat. _____

1st 24 hrs. after shot _____

Gas _____ Cu. Ft.

Dry Hole _____

Abandoned _____

Date

3/8

191

9

Pyle

Scout


Map No. K 14 Sec. 4 Twp. 26 R. 5Well No. 2 ThompsonEmpire Company

Contractor

NORTH

WEST

EAST

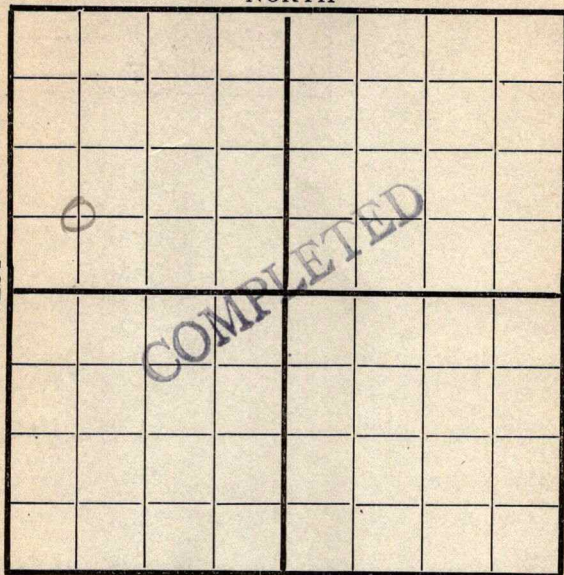

SOUTH

660 S-W

Location _____

Rig up _____

Drilling and Remarks:

RECORD

Cased _____ in., _____ ft.

Sand 2408 - 2463

Gas _____

Oil _____

Total Depth _____

PRODUCTION

1st 24 hrs. Nat. _____

1st 24 hrs. after shot _____

Gas _____ Cu. Ft.

Dry Hole _____

Abandoned 2463'

Date

4/16 1919Dyke Scout