1004


Form 51—12-17—5M—Mid-West.

Map No. K-14 Sec. 5 Twp. 26 R. 5

Well No. 33 Howe Farm

Empire Company

NORTH

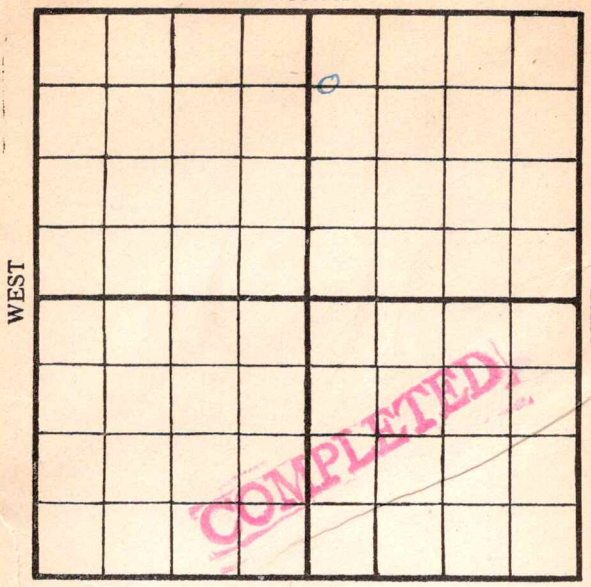

SOUTH

Location _____

Drilling Remarks:

Rig Up _____

Drilling Remarks:

RECORD

Cased _____ in. _____ ft.

Sand _____

Gas _____

Oil _____

Total Depth _____

PRODUCTION

1st 24 hrs. Nat. _____

1st 24 hrs. after shot _____

Gas _____ cu. ft.

Dry Hole _____

Abandoned _____

Form 26—1M Books of 100 Sheets Each—4-15-18


1004

Map No. K14 Sec. 5 Twp. 26 R. 5

Well No. 33 Howe

Empire Company

Hueber & Lowman Contractor

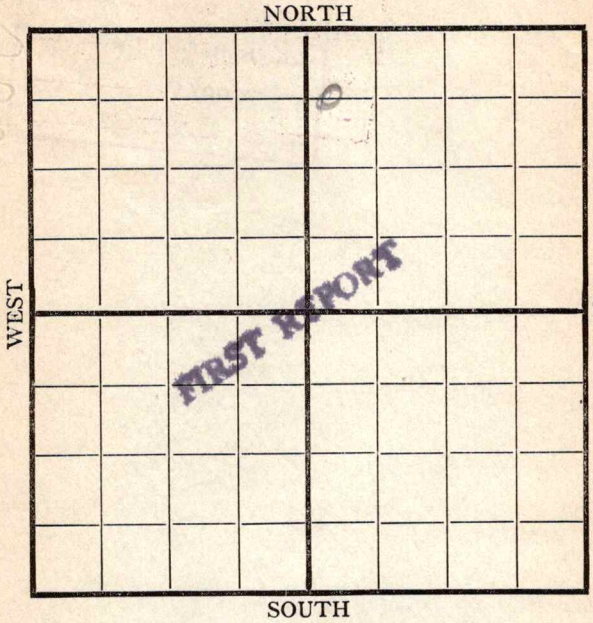

Location

Rig up ✓

Drilling and Remarks:

267E
660·S

RECORD

Cased in., ft.

Sand

Gas

Oil

Total Depth

PRODUCTION

1st 24 hrs. Nat.

1st 24 hrs. after shot

Gas Cu. Ft.

Dry Hole

Abandoned

Date

7/24 191 8 Scout


Form 26—1M Books of 100 Sheets Each—4-15-18

Map No. ____ Sec. 5 Twp. 26 R. 5

Well No. 33 Howe

Empire Company

Contractor

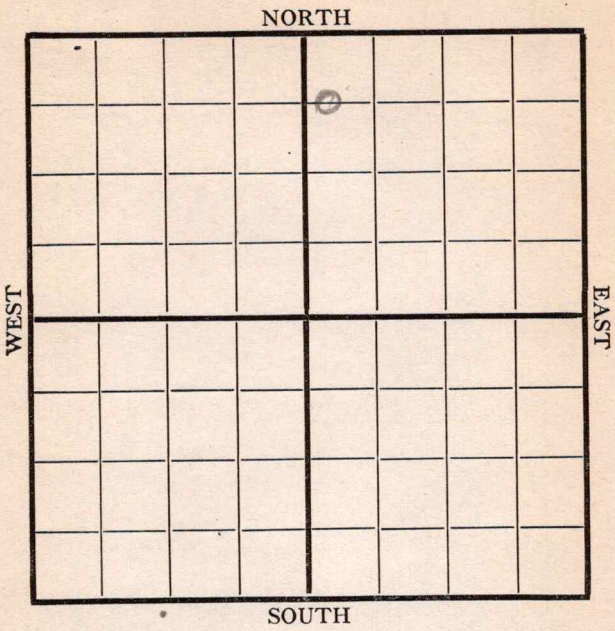

Location ✓

Rig up ✓

Drilling and Remarks:

267' W
660' N

RECORD

Cased ____ in., ____ ft.

Sand ____

Gas ____

Oil ____

Total Depth ____

PRODUCTION

1st 24 hrs. Nat. ____

1st 24 hrs. after shot ____

Gas ____ Cu. Ft.

Dry Hole ____

Abandoned ____

Date

7/31 191 8 Doyle Scout

Form 26—1M Books of 100 Sheets Each—4-15-18


Map No. ____ Sec. 5 Twp. 26 R. 5

Well No. 33 Howe

Empire Company

Contractor

NORTH

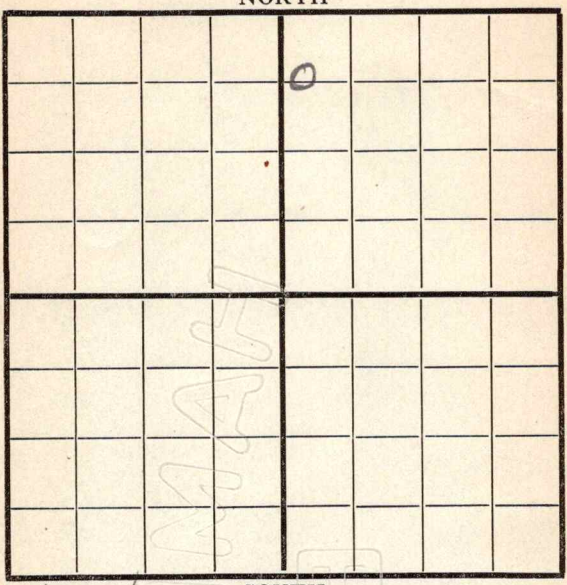

267W

Location 660 N

Rig up ✓

Drilling and Remarks:

RECORD

Cased ____ in., ____ ft.

Sand

Gas

Oil

Total Depth

PRODUCTION

1st 24 hrs. Nat.

1st 24 hrs. after shot

Gas ____ Cu. Ft.

Dry Hole

Abandoned

Date

8/7 191 ____ Scout


Form 26—1M Books of 100 Sheets Each—4-15-18

Map No. ____ Sec. 5 Twp. 26 R. 5

Well No. 33 Hawe

Empire Company

Contractor

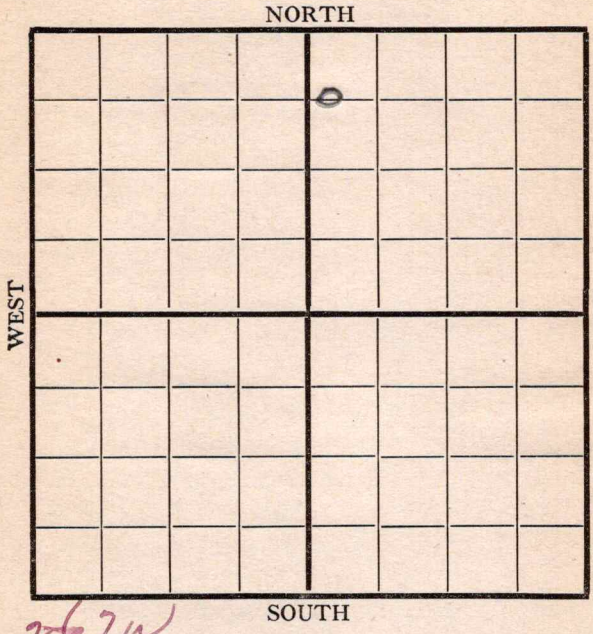

26 7W

Location 660 N

Rig up

Drilling and Remarks:

Rig blew down

RECORD

Cased ____ in., ____ ft.

Sand

Gas

Oil

Total Depth

PRODUCTION

1st 24 hrs. Nat.

1st 24 hrs. after shot

Gas ____ Cu. Ft.

Dry Hole

Abandoned

Date 8/13 191 8 Cyle Scout

Form 26—1M Books of 100 Sheets Each—4-15-18


Map No. ____ Sec. 5 Twp. 26 R. 5

Well No. 33 Hance

Empire Company

Contractor

NORTH

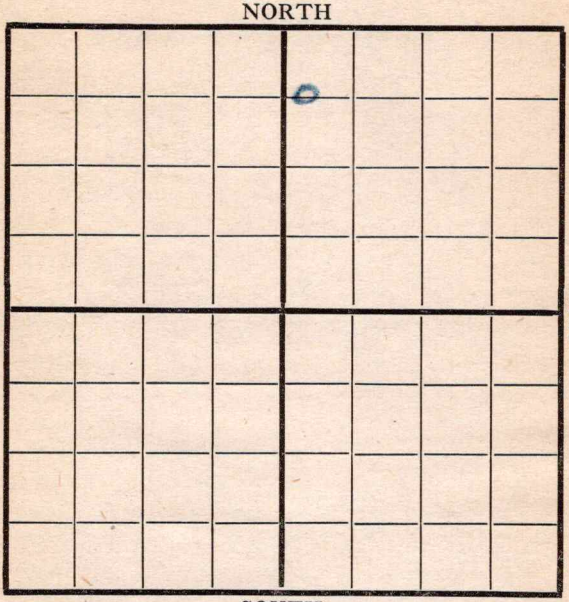

SOUTH

660' N-760' W

Location

Rig up

Drilling and Remarks:

Rig down

RECORD

Cased ____ in., ____ ft.

Sand

Gas

Oil

Total Depth

PRODUCTION

1st 24 hrs. Nat.

1st 24 hrs. after shot

Gas ____ Cu. Ft.

Dry Hole

Abandoned

Date 8/21 191 5

Pyle Scout


Form 26—1M Books of 100 Sheets Each—4-15-18

Map No. K 14 Sec. 5 Twp. 26 S R. 5 E

Well No. 33 Howe

Empire Company

Contractor

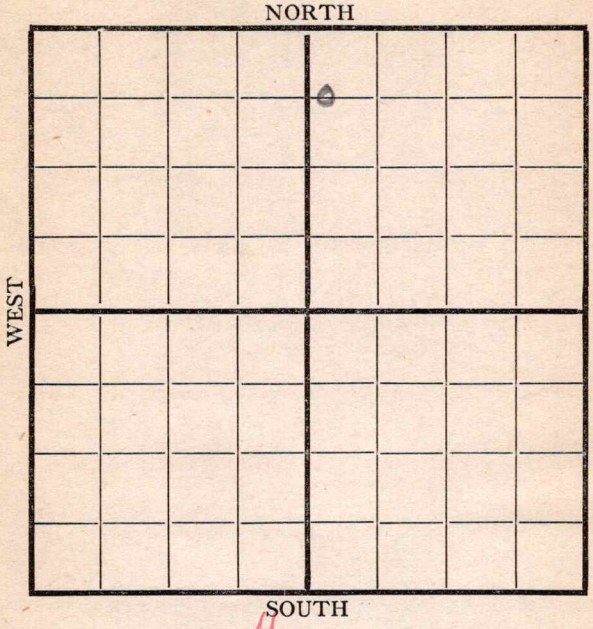

Location 267 E 660 S

Rig up

Drilling and Remarks:

Rig down

RECORD

Cased in., ft.

Sand

Gas

Oil

Total Depth

PRODUCTION

1st 24 hrs. Nat.

1st 24 hrs. after shot

Gas Cu. Ft.

Dry Hole

Abandoned

Date 8/28 191 8 Pyle Scout


Form 26—1M Books of 100 Sheets Each—4-15-18

Map No. K14 Sec. 5 Twp. 26S R. 5E

Well No. 33 Houpe

Empire Company

Contractor

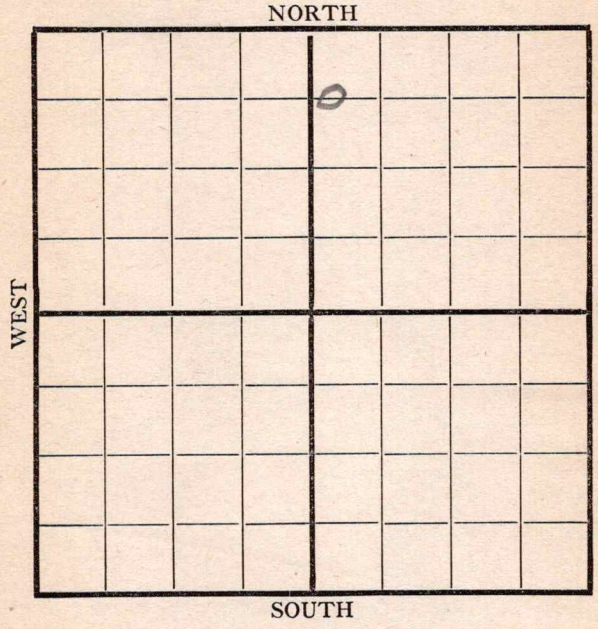

Location

Rig up

Drilling and Remarks:

660 from N

467 " W.

Rig down

RECORD

Cased in., ft.

Sand

Gas

Oil

Total Depth

PRODUCTION

1st 24 hrs. Nat.

1st 24 hrs. after shot

Gas Cu. Ft.

Dry Hole

Abandoned

Date

9/5 1918. Pyle Scout


Form 26—1M Books of 100 Sheets Each—4-15-18

Map No. K 14 Sec. 5 Twp. 26 S R. 5 E

Well No. 33 Hawe

Empire Company

Contractor

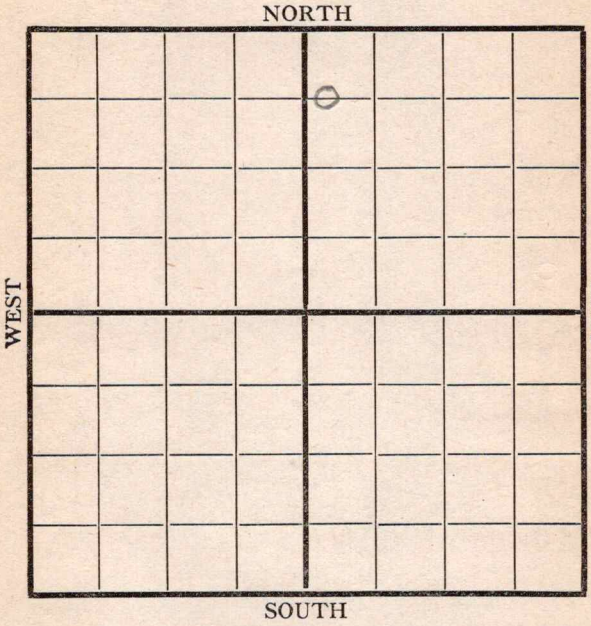

Location 660 N 264 W

Rig up

Drilling and Remarks:

Rig down

RECORD

Cased in., ft.

Sand

Gas

Oil

Total Depth

PRODUCTION

1st 24 hrs. Nat.

1st 24 hrs. after shot

Gas Cu. Ft.

Dry Hole

Abandoned

Date 9/11 191 8 Pyle Scout


Form 26—1M Books of 100 Sheets Each—4-15-18

Map No. K14 Sec. 5 Twp. 26 S R. 5 E

Well No. 33 Howe

Empire Company

Contractor

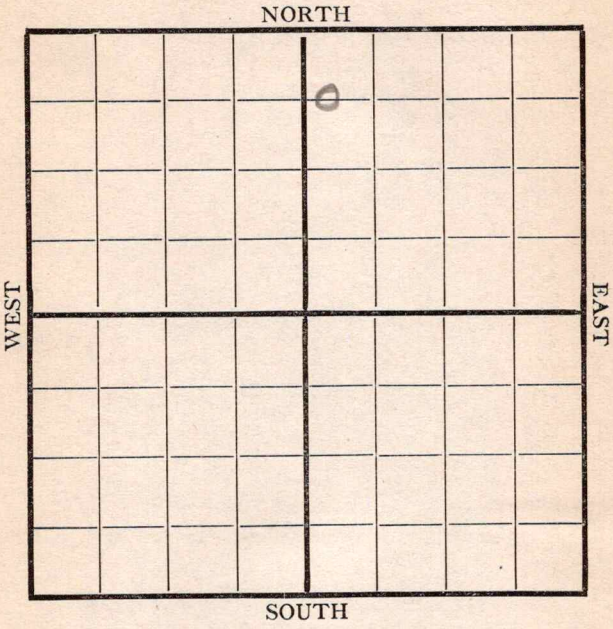

Location 267-W
660-N

Rig up

Drilling and Remarks:

Spudding

RECORD

Cased in., ft.

Sand

Gas

Oil

Total Depth

PRODUCTION

1st 24 hrs. Nat.

1st 24 hrs. after shot

Gas Cu. Ft.

Dry Hole

Abandoned

Date

9/18 191 8. Pyle Scout


Form 26—1M Books of 100 Sheets Each—4-15-18

Map No. K 14 Sec. 5 Twp. 26 R. 5

Well No. 33 Howen

Empire Company

Contractor

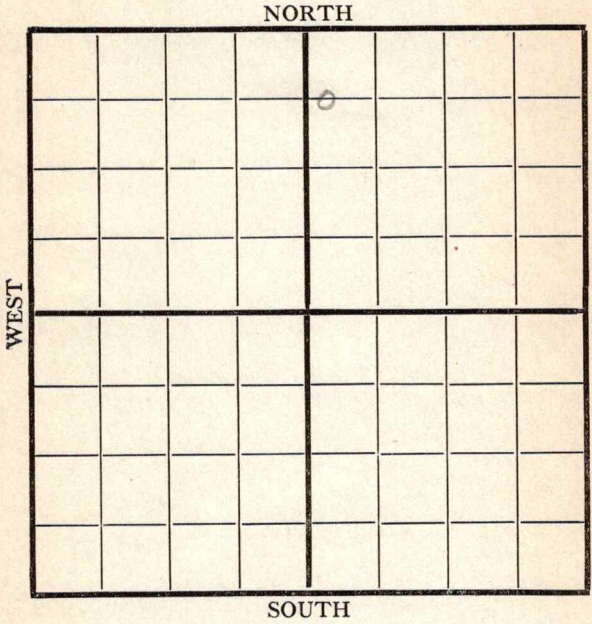

Location 267 W
660 N

Rig up

Drilling and Remarks:

635'

RECORD

Cased in., ft.

Sand

Gas

Oil

Total Depth

PRODUCTION

1st 24 hrs. Nat.

1st 24 hrs. after shot

Gas Cu. Ft.

Dry Hole

Abandoned

Date

9/26 191 8 Pyle Scout


Form 26—1M Books of 100 Sheets Each—4-15-18

Map No. K 14 Sec. 5 Twp. 26 R. 5

Well No. 33 Howe

Empire Company

Contractor

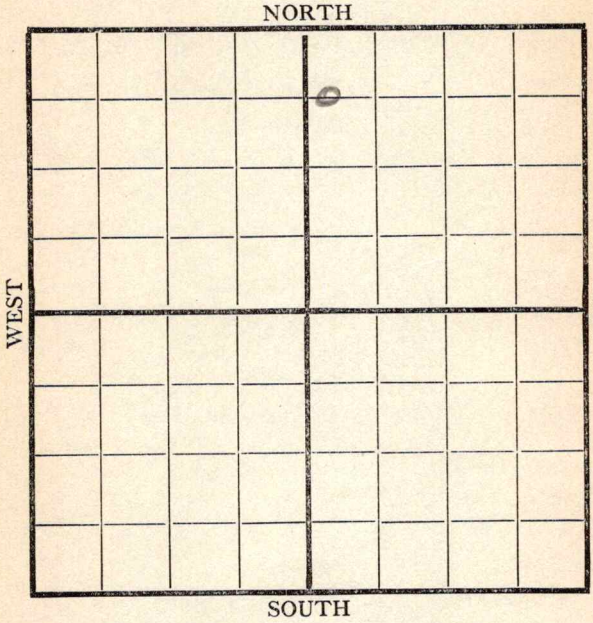

Location 267 - W
660 - N

Rig up

Drilling and Remarks:

990'

RECORD

Cased in., ft.

Sand

Gas

Oil

Total Depth

PRODUCTION

1st 24 hrs. Nat.

1st 24 hrs. after shot

Gas Cu. Ft.

Dry Hole

Abandoned

Date

10/3 191 8. Pyle Scout


Form 26—1M Books of 100 Sheets Each—4-15-18

Map No. K 14 Sec. 5 Twp. 26 R. 5

Well No. 33 Howe

Empire Company

Contractor

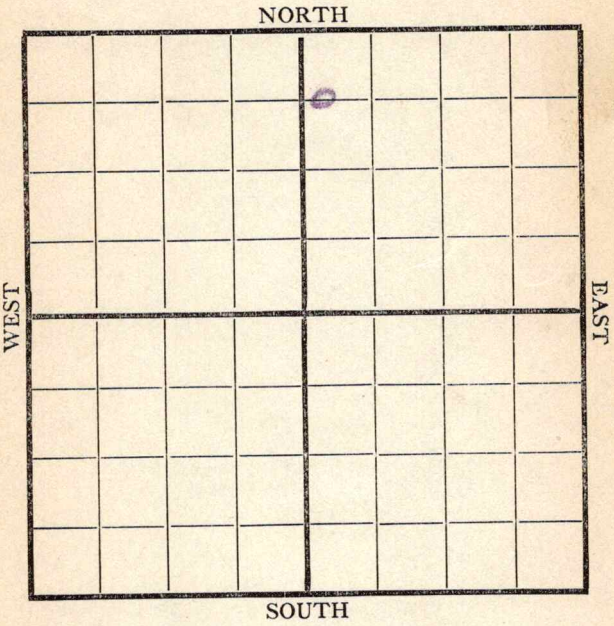

Location 267 - W
6660 - N

Rig up

Drilling and Remarks:

1480

RECORD

Cased ____ in., ____ ft.

Sand

Gas

Oil

Total Depth

PRODUCTION

1st 24 hrs. Nat.

1st 24 hrs. after shot

Gas ____ Cu. Ft.

Dry Hole

Abandoned

Date

10/9 191 8 Scout


Form 26—1M Books of 100 Sheets Each—4-15-18

Map No. K 14 Sec. 5 Twp. 26 R. 5

Well No. 33 Howe

Empire Company

Contractor

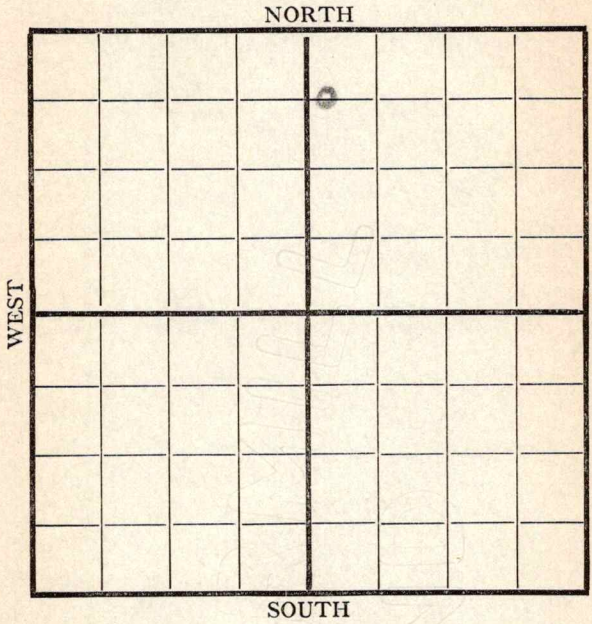

Location 267 W
660 N

Rig up

Drilling and Remarks:

1750'

RECORD

Cased in., ft.

Sand

Gas

Oil

Total Depth

PRODUCTION

1st 24 hrs. Nat.

1st 24 hrs. after shot

Gas Cu. Ft.

Dry Hole

Abandoned

Date

10/15/18

Kyle Scout

Form 26—1M Books of 100 Sheets Each—4-15-18

Map No. K14 Sec. 5 Twp. 26 R. 5

Well No. 33 Hawe

Empire Company

Contractor

NORTH

WEST

EAST

SOUTH

Location 660-N
267-W

Rig up

Drilling and Remarks:

Top D. 2423
Dly 2445

RECORD

Cased in., ft.

Sand

Gas

Oil

Total Depth

PRODUCTION

1st 24 hrs. Nat.

1st 24 hrs. after shot

Gas Cu. Ft.

Dry Hole

Abandoned

Date

11/7 191 8 Pyle Scout


Form 26—1M Books of 100 Sheets Each—4-15-18

Map No. K14 Sec. 5 Twp. 26 R. 5E

Well No. 33 Howe

Empire Company

Contractor

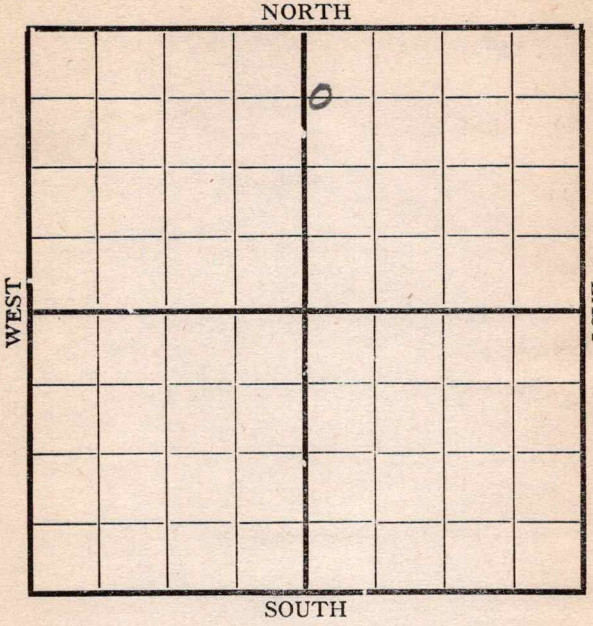

Location 367-W 660-N

Rig up

Drilling and Remarks:

D 10 @ 2447

RECORD

Cased in., ft.

Sand 2423

Gas

Oil

Total Depth

PRODUCTION

1st 24 hrs. Nat.

1st 24 hrs. after shot

Gas Cu. Ft.

Dry Hole

Abandoned

Date

11/15 1918. Pyle Scout


Form 26—1M Books of 100 Sheets Each—4-15-18

Map No. K14 Sec. 5 Twp. 26 R. 5

Well No. 33 Stone

Empire Company

Contractor

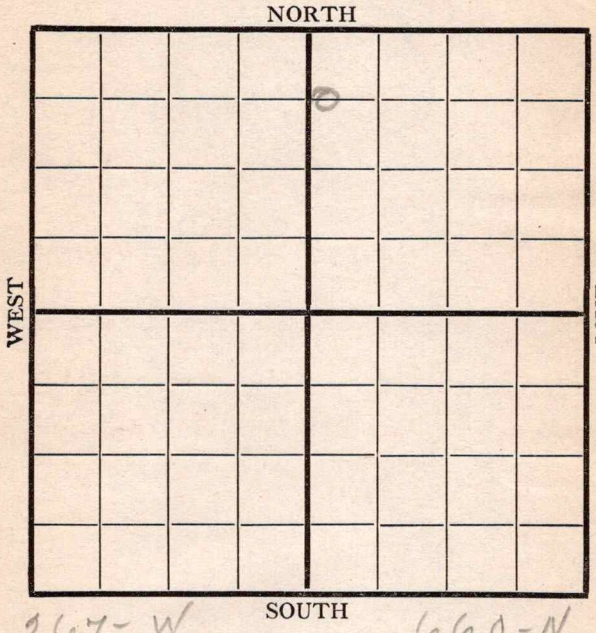

Location

Rig up

Drilling and Remarks:

D. D for liner

RECORD

Cased in., ft.

Sand 2423-2463

Gas

Oil

Total Depth

PRODUCTION

1st 24 hrs. Nat.

1st 24 hrs. after shot

Gas Cu. Ft.

Dry Hole

Abandoned

Date

1/20 191 8 Tyler Scout


Form 26—1M Books of 100 Sheets Each—4-15-18

Map No. K14 Sec. 5 Twp. 26 R. 5

Well No. 33 Howe

Empire Company

Contractor

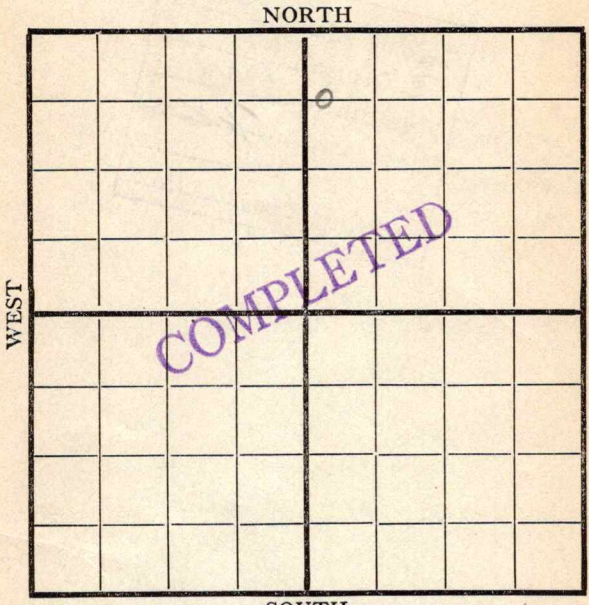

267-W 660-N

Location

Rig up

Drilling and Remarks:

RECORD

Cased in., ft.

Sand 2423- 2480

Gas

Oil

Total Depth

PRODUCTION

1st 24 hrs. Nat. 25 bbls

1st 24 hrs. after shot

Gas Cu. Ft.

Dry Hole

Abandoned

Date

11/29 1918. Gyle Scout