
FORM 51 25M 8-50 WESTERN Butler KANSAS

Section 18 Township 26 Range 5E

Well No. #1 Fry

Company White & Ellis

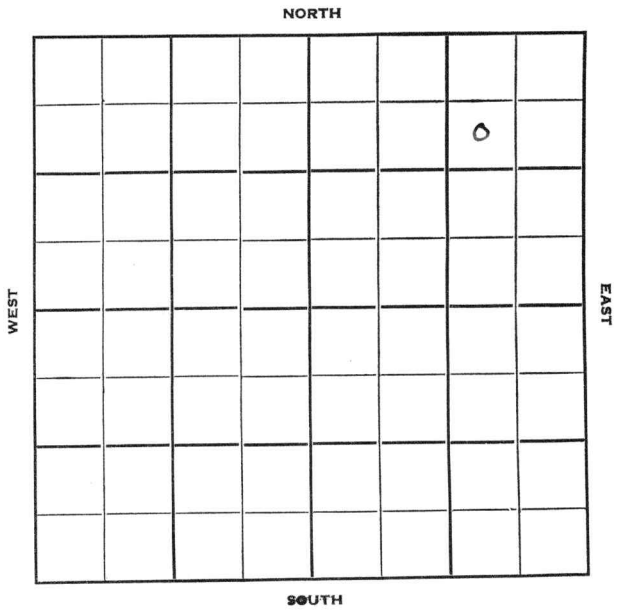

FORM 252-B
10M 10-50 PETROL

Butler KANSAS

Sec. 18 Twp. 26 R. 5E

Well No. #1 Fry Farm

White & Ellis Company

Morrison Drlg. - Contr. Contractor

El Dorado Pool


990' Ft. from N. Line

Ft. from S. Line

990' Ft. from E. Line

Ft. from W. Line

SW NE NE

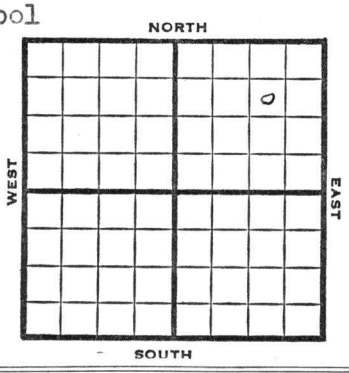

1950	Elev 1345' REPORT
12/6	Spud 11-28-50 8" @ 84 Drlg. 1665'
1951 1/10	Spud 11-28-50 8" @ 84 4" @ 2401 Viola 2401 Simp 2424 TD 2446 B/1½ bo 12 hr 40 qt/ 2424-46 Comp 25 bopd Completed COMPLETED

FORM 275 FOR SALE BY KANSAS BLUE PRINT CO.


County Butler State Kansas

Sec. 18 (Blk. Twp.) 26 (Sur. Rge.) 5E Map No.

Operator White & Ellis

Well No. 1 Farm Fry

Elev. Location SW NE NE

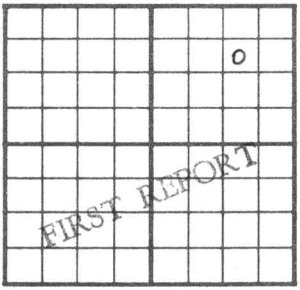

990 Ft. From N Line NE

990 Ft. From E Line Quarter

1st. Report DEC 6 1950

Completion

Remarks

Morrison Drlg. - Contr.

Spudding Date 11-28-50

Drlg. Data ElDorado Pool

8" @ 84 drlg. 1665

J. E. TYRA

FORM 275 FOR SALE BY KANSAS BLUE PRINT CO.


County Butler State Kansas

Sec. 18 (Blk. Twp.) 26 (Sur. Rge.) 5E Map No.

Operator White & Ellis

Well No. 1 Farm Fry

Elev. 1345 Location SW NE NE

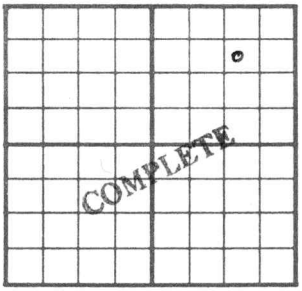

990 Ft. From N Line NE

990 Ft. From E Line Quarter

1st. Report

Completion JAN 1 6 1951

Remarks Eldorado Pool

Morrison Drlg. - Contr.

Spudding Date 11-28-50

Drlg. Data Oil well TD 2446

8" @ 84 4" @ 2401 Viola 2401 Simp.2424

TD 2446 B/ 1½ bo 12 hr. 40 qt/ 2424-46

Comp. 25 bopd

J. E. TYRA