


Greenwood

Map No. *Kansas* Sec. *28* Twp. *26* R. *9*

Well No. *1 Klein* Farm

Henderson + Holden Company

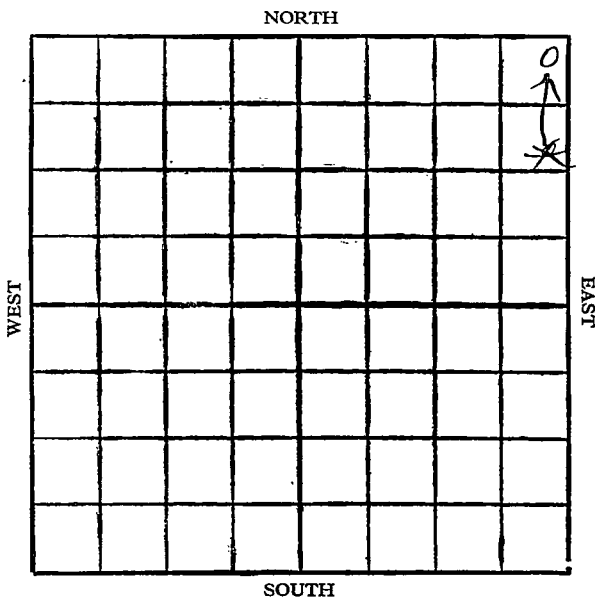

Location

Drilling Remarks

Rig Up.....

Drilling Remarks

RECORD

Cased.....in.ft.

Sand

Gas

Oil

Total Depth.....

PRODUCTION

1st 24 hrs. Nat.....

1st 24 hrs. after shot.....

Gas..... cu. ft.

Dry Hole.....

Abandoned

15 - KANSAS

Map No. _____ Sec. 28 Twp. 26 R. 9

Well No. 1 Klein,
Henderson & Holden Company

Contractor

FIRST REPORTS

SECTION PLAT

990 Ft. from N. Line

_____ Ft. from S. Line

330 Ft. from E. Line

_____ Ft. from W. Line

			0

Location _____

Rig up _____

Drilling and Remarks:

Rigging up

RECORD

Cased _____ in., _____ ft.

Sand _____

Gas _____

Oil _____

Total Depth _____

PRODUCTION

1st 24 hrs. Nat. _____

1st 24 hrs. after shot _____

Gas _____ Cu. Ft.

Dry Hole _____

Abandoned _____

Date

MAY 11 1927

CHAS. L. SHERWOOD

192

Scout

Stamwood
 15 KANSAS 78 Twp. 26 R. 9
 Map No. Sec. Twp. R.

Well No. 1 *Skin*
Henderson & Holden Company

Contractor

CORRECTION

SECTION PLAT

450 Ft. from N. Line

Ft. from S. Line

330 Ft. from E. Line

Ft. from W. Line

			9
~			

Location

Rig up

Drilling and Remarks:

Spudg

*Mediously reported
 to 990 from N.W.
 Should be 450*

RECORD

Cased in, ft.

Sand

Gas

Oil

Total Depth

PRODUCTION

1st 24 hrs. Nat.

1st 24 hrs. after shot

Gas Cu. Ft.

Dry Hole

Abandoned

Date

MAY 18 1927

CHAS. L. SHERWOOD

192

Scout

Sherwood

15 KANSAS Map No. Sec. 28 Twp. 26 R. 9

Well No. 1 Klein
Henderson & Halden Company

Contractor

COMPLETED

SECTION PLAT

450 Ft. from N. Line

_____ Ft. from S. Line

330 Ft. from E. Line

_____ Ft. from W. Line

ABANDONED

			0

Location _____

Rig up _____

Drilling and Remarks:

✓ 14 Sbs 911-24
Show Oil 1150'
Top Run 2265'
Small Show 2265-90'
897 2680

RECORD

Cased _____ in., _____ ft.

Sand _____

Gas _____

Oil _____

Total Depth *2680*

PRODUCTION

1st 24 hrs. Nat. _____

1st 24 hrs. after shot _____

Gas _____ Cu. Ft.

Dry Hole *✓*

Abandoned *✓*

Date

July 13 1927

CHAS. L. SHERWOOD

Scout