

KANSAS


Greenwood

Section 3 Township 26 Range 10E

Well No. 1 Weishing *(Wiershing)*

Company L.C. Jones

Misc.
NORTH

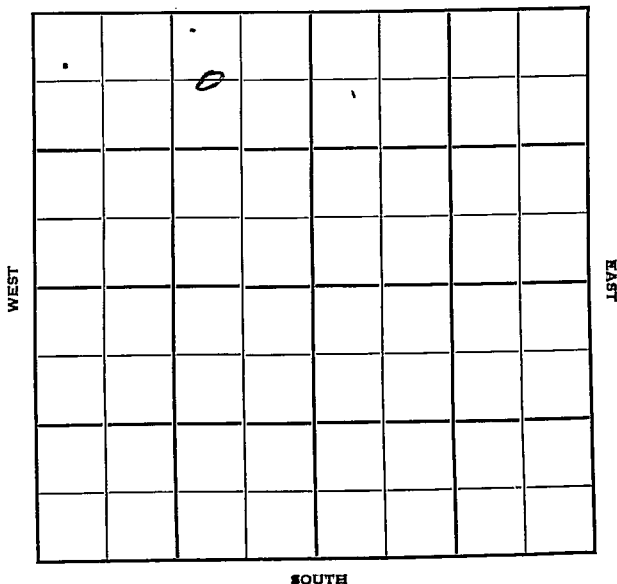

Sec. 3 Twp. 26 R. 10E

Well No. #1 Weishing Farm

L. C. Jones Company

Miscellaneous (Jones, Cont.) NORTH


660' Ft. from N. Line

 Ft. from S. Line

990' Ft. from E. Line

 Ft. from W. Line

C W L NE NW

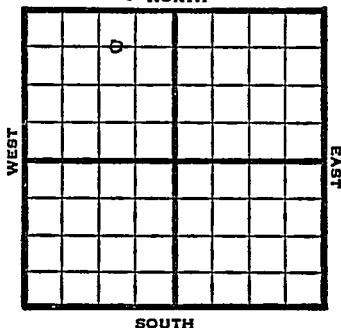

1949

REPORT

8/10 10" @ 765'
Drlg. 940'
8/16 Drlg. 1200'
8/24 8" @ 1385'
Drlg. 1665'
8/31 Mississippi 1946'-53
TD 1953'
Run 4"
9/7 "
9/14 TD 1955'
Miss 1946'
4 @ 1952'
500 acid
Pump 60 Oil Pot
38° Gr.
Comp

COMPLETED

Kansas

Map No. _____ Sec. 3 Twp. 26 R. 10EWell No. 1 Weishing_____
L. C. Jones _____ Company_____
Jones _____ Contractor

C W L NE NW

FIRST REPORT
SECTION PLAT

	o		

660 Ft. from N. Line_____
Ft. from S. Line990 Ft. from E. Line_____
Ft. from W. Line

Greenwood County

Location _____

Rig up _____

Drilling and Remarks: _____

10" @ 765'

drlg. 940

RECORD

Cased _____ in., _____ ft.

Sand _____

Gas _____

Oil _____

Total Depth _____

PRODUCTION

1st 24 hrs. Nat. _____

1st 24 hrs. after shot _____

Gas _____ Cu. Ft.

Dry Hole _____

Abandoned _____

Date

AUG 10 1949 19

S. J. LEWIS Scout

Map No. K16 Sec. 3 Twp. 26 R. 10E

Well No. 1 Weishing

L. C. Jones

Company

COMPLETE

Contractor

C W L NE NW

SECTION PLAT


660 Ft. from N. Line

Ft. from S. Line

990 Ft. from E. Line

Ft. from W. Line

Greenwood County

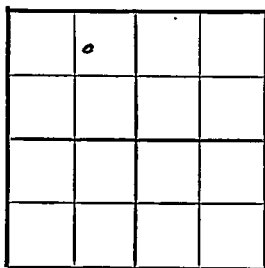

Location:

Rig up

Drilling and Remarks:

Mus 1946

4" @ 1952

500 acft

Prod 60 oil 1st

38 cu

RECORD

Cased _____ in., _____ ft.

Sand _____

Gas _____

Oil _____

Total Depth 1955

PRODUCTION

1st 24 hrs. Nat. _____

1st 24 hrs. after shot _____

Gas _____ Cu. Ft.

Dry Hole _____

Abandoned _____

Date

SEP 14 1949

19

S. J. LEWIS

Scout