

Map No. _____ Sec. 5 Twp. 26 R. 5Well No. 2 Lin Farm __________Smclair_____
Company

NORTH

WEST

EAST

COMPLETED

SOUTH

Location _____

Drilling Remarks

10/3 completedRig Up 8/17

Drilling Remarks

RECORD

Cased _____ in. _____ Ft.

Sand _____

Gas _____

Oil _____

Total Depth _____

PRODUCTION

1st 24 hrs. Nat. _____

1st 24 hrs. after shot _____


Gas _____ Cu. Ft.

Dry Hole _____

Abandoned _____

Map No. _____ Sec. 5 Twp. 26 R. 5
 Well No. 27 _____ Farm _____
Shelby _____ Company _____

NORTH

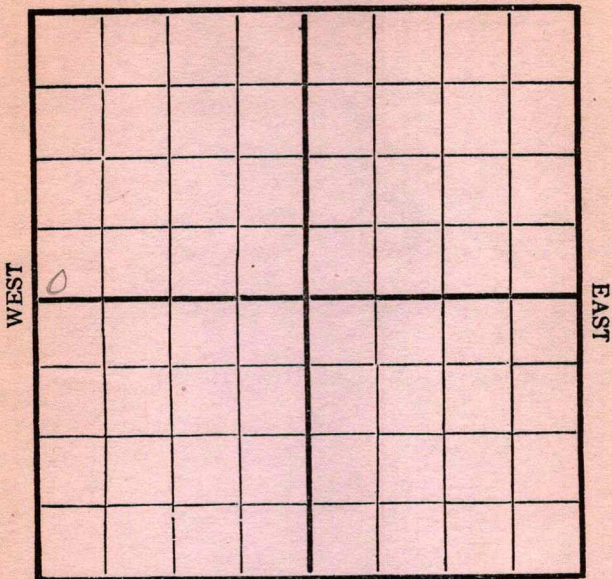

SOUTH

Location _____
 Rig Up _____
 Drilling and remarks _____

RECORD

Cased _____ in. _____ Ft.
 Sand _____
 Gas _____
 Oil _____
 Total Depth _____

PRODUCTION

1st 24 hrs. Nat. _____
 First 24 hrs. after shot _____
 Gas _____ Cu. Ft.
 Dry Hole _____
 Abandoned _____

Date


8/17, 1916 W. C. Card Scout

Map No. _____ Sec. 5 Twp. 26 R. 5
 Well No. 3 Lincoln Farm _____
Shelton Company _____

NORTH

WEST

EAST

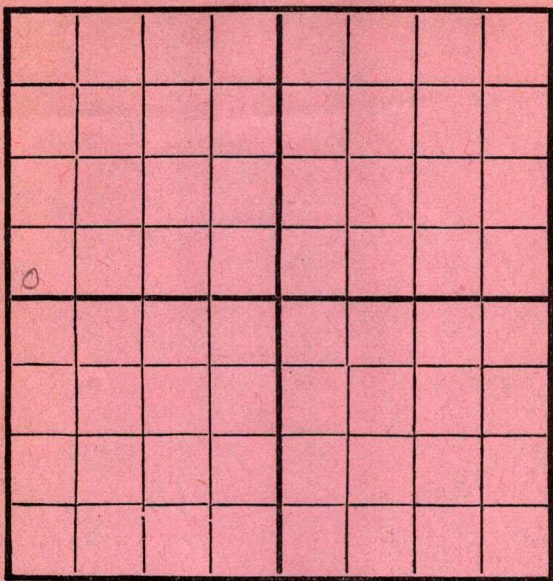

SOUTH

Location _____
 Rig Up _____
 Drilling and remarks _____

Rigging up

RECORD

Cased _____ in. _____ Ft.
 Sand _____
 Gas _____
 Oil _____
 Total Depth _____

PRODUCTION

1st 24 hrs. Nat. _____
 First 24 h.s. after shot _____
 Gas _____ Cu. Ft.
 Dry Hole _____
 Abandoned _____

Date 8/23, 1916 Leeland A Scout

Map No. _____ Sec. 5 Twp. 26 R. 5
Well No. 2 Lion Farm _____
Shelton Company _____

NORTH

WEST

EAST

SOUTH

Location ✓
Rig Up ✓
Drilling and remarks _____

RECORD

Cased _____ in. _____ Ft.
Sand _____
Gas _____
Oil _____
Total Depth _____

PRODUCTION

1st 24 hrs. Nat. _____
First 24 h. s. after shot _____
Gas _____ Cu. Ft.
Dry Hole _____
Abandoned _____

Date Feb 3 1916 Scout

Map No. _____ Sec. 5 Twp. 26 R. 5
 Well No. 2 _____ Farm _____
Simclair _____ Company _____

NORTH

WEST

EAST

SOUTH

Location _____

Rig Up _____

Drilling and remarks

RECORD

Cased _____ in. _____ Ft.

Sand _____

Gas _____

Oil _____

Total Depth _____

PRODUCTION

1st 24 hrs. Nat. _____

1st 24 hrs. after shot _____

Gas _____ Cu. Ft.

Dry Hole _____

Abandoned _____

Date


191

Scout

Map No. _____ Sec. 5 Twp. 26 R. 5
 Well No. 2 Linn Farm _____
Quicksilver Company _____

NORTH

WEST

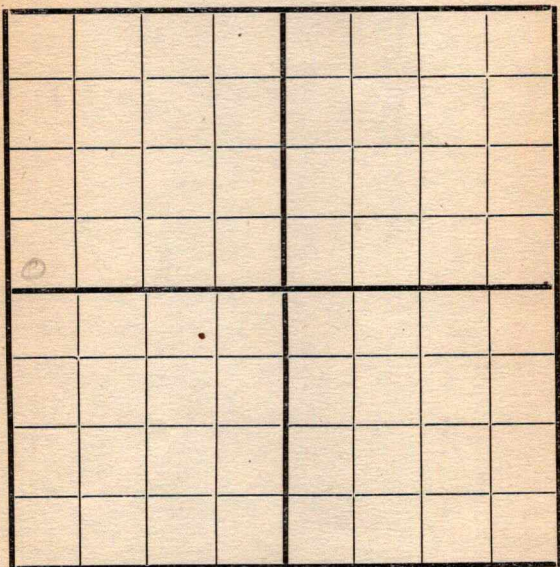

EAST

SOUTH

Location _____
 Rig Up _____
 Drilling and remarks _____

700

RECORD

Cased _____ in. _____ Ft.
 Sand _____
 Gas _____
 Oil _____
 Total Depth _____

PRODUCTION

1st 24 hrs. Nat. _____
 1st 24 hrs. after shot _____
 Gas _____ Cu. Ft.
 Dry Hole _____
 Abandoned _____

Date 9/6, 1916 6 Linn Scout _____

Map No. _____ Sec. 5 Twp. 26 R. 5
 Well No. 3 Lin Farm _____
Lin Company _____

NORTH

WEST

EAST

SOUTH

Location _____

Rig Up _____

Drilling and remarks

RECORD

Cased _____ in. _____ Ft.

Sand _____

Gas _____

Oil _____

Total Depth _____

PRODUCTION

1st 24 hrs. Nat. _____

1st 24 hrs. after shot _____

Gas _____ Cu. Ft.

Dry Hole _____

Abandoned _____

Date

9/13, 1916 Lin Scout

Map No. _____ Sec. 5 Twp. 26 R. 5
 Well No. 2 Linn Farm _____
Smiley Company _____

NORTH

WEST

EAST

SOUTH

Location _____

Rig Up _____

Drilling and remarks

1765

RECORD

Cased _____ in. _____ Ft.

Sand _____

Gas _____

Oil _____

Total Depth _____

PRODUCTION

1st 24 hrs. Nat. _____

1st 24 hrs. after shot _____

Gas _____ Cu. Ft.

Dry Hole _____

Abandoned _____

Date

9/20, 1916 L. Smiley Scout

Map No. _____ Sec. 5 Twp. 26 R. 5
 Well No. 2 _____ Farm _____
Lincoln _____ Company _____

NORTH

WEST

EAST

SOUTH

Location _____

Rig Up _____

Drilling and remarks

2160

RECORD

Cased _____ in. _____ Ft.

Sand _____

Gas _____

Oil _____

Total Depth _____

PRODUCTION

1st 24 hrs. Nat. _____

First 24 hrs. after shot _____

Gas _____ Cu. Ft.

Dry Hole _____

Abandoned _____


Date

9/26 1916 Scout

Scou

Map No. _____ Sec. 5 Twp. 26 R. 5
 Well No. 2 Linn Farm _____
Amalain Company _____

NORTH

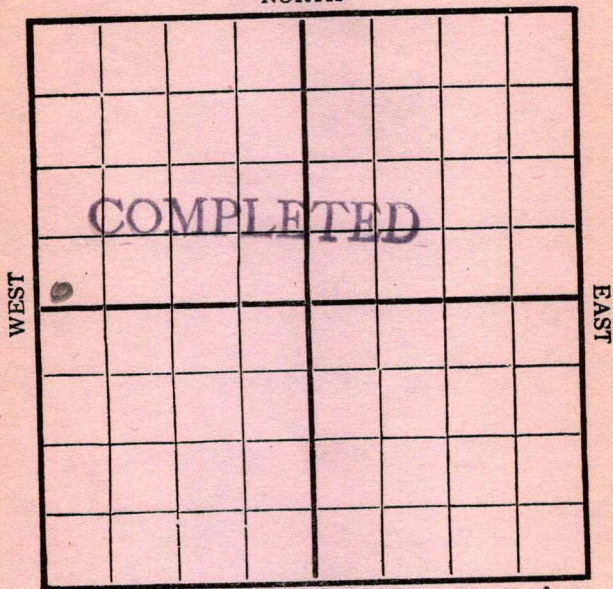

SOUTH

Location _____

Rig Up _____

Drilling and remarks

Light well -
Possibly make
75 bbls

RECORD

Cased _____ in. _____ Ft.

Sand 2445-2477

Gas _____

Oil _____

Total Depth _____

PRODUCTION

1st 24 hrs. Nat. _____

First 24 hrs. after shot _____

Gas _____ Cu. Ft.

Dry Hole _____

Abandoned _____

Date

10/3, 191 6 Scout