

Map No. _____ Sec. 5 Twp. 26 R. 5Well No. 30 _____ Farm _____

_____ Sinclair _____ Company

NORTH

WEST

EAST

SOUTH

Location _____

Rig Up 10/17

Drilling Remarks:

Drilling Remarks:

10/18 - Rigging up
10/25 = 240
11/9 = 850
11/14 = 1050
11/27 = 1915
12/4 = 2200

RECORD

Cased _____ in _____ Ft.

Sand 2440 - 2455'

Gas _____

Oil _____

Total Depth _____

PRODUCTION

1st 24 hrs. Nat. 250 bbls

1st 24 hrs. after shot _____


Gas _____ Cu. Ft.

Dry Hole _____

Abandoned _____

Map No. _____ Sec. 5 Twp. 26 R. 5
Well No. 6 _____ Farm _____
Shindler _____ Company _____

NORTH

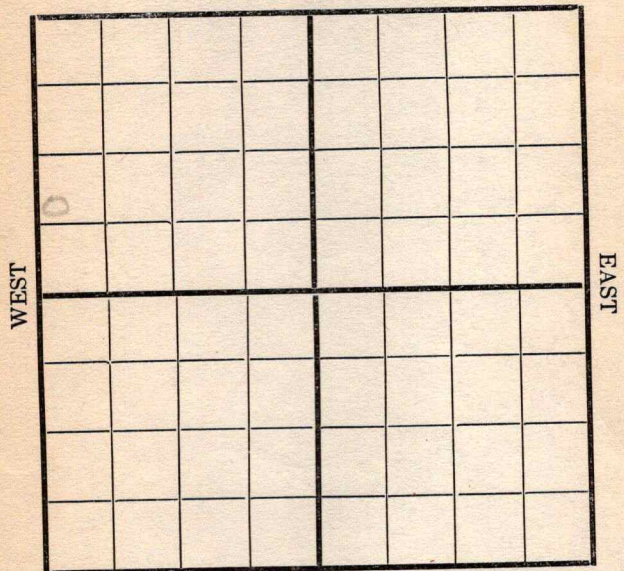

SOUTH

Location _____
Rig Up ☒ _____
Drilling and remarks _____

RECORD

Cased _____ in. _____ Ft.
Sand _____
Gas _____
Oil _____
Total Depth _____

PRODUCTION

1st 24 hrs. Nat. _____
1st 24 hrs. after shot _____
Gas _____ Cu. Ft.
Dry Hole _____
Abandoned _____

Date


10/11, 1916 L. D. Dandy Scout

Map No. _____ Sec. 5 Twp. 26 R. 5
 Well No. 6 Linn Farm _____
Sinaloa Company _____

NORTH

WEST

EAST

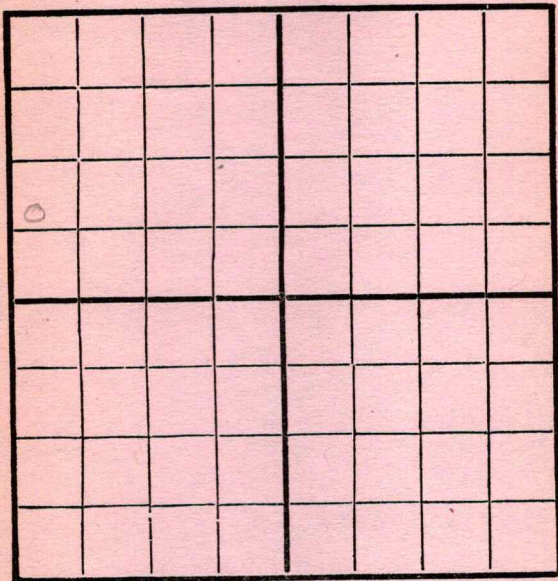

SOUTH

Location _____
 Rig Up _____
 Drilling and remarks _____

Rigging up

RECORD

Cased _____ in. _____ Ft.
 Sand _____
 Gas _____
 Oil _____
 Total Depth _____

PRODUCTION


1st 24 hrs. Nat. _____
 First 24 hrs. after shot _____
 Gas _____ Cu. Ft.
 Dry Hole _____
 Abandoned _____

Date

10/18, 1916 Scout

Map No. _____ Sec. 5 Twp. 26 R. 5
Well No. 65 Farm _____
Lincoln Company _____

NORTH

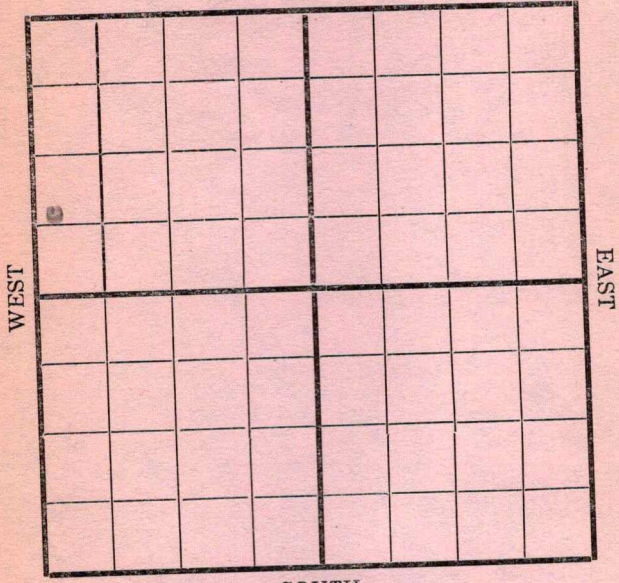

SOUTH

RECORD	
Location _____	Cased _____ in. _____ Ft.
Rig Up _____	Sand _____
Drilling and remarks _____	Gas _____
<u>200</u>	Oil _____
	Total Depth _____
PRODUCTION	
1st 24 hrs. Nat. _____	
1st 24 hrs. after shot _____	
Gas _____ Cu. Ft.	
Dry Hole _____	
Abandoned _____	

Date 10/25/1916 Scout

Map No. _____ Sec. 5 Twp. 26 R. 5Well No. 6 Linn Farm _____Company Seitain

NORTH

WEST

EAST

SOUTH

Location _____

Rig up _____

Drilling and remarks

550

RECORD

Cased _____ in. _____ Ft.

Sand _____

Gas _____

Oil _____

Total Depth _____

PRODUCTION

1st. 24 hrs. Nat. _____

1st 24 hrs. after shot _____

Gas _____ Cu. Ft.

Dry Hole _____

Abandoned _____


Date

10/30, 1916, LLC

Scout

Map No. _____ Sec. 5 Twp. 26 R. 5
Well No. 26 _____ Farm _____
Simola _____ Company _____

NORTH

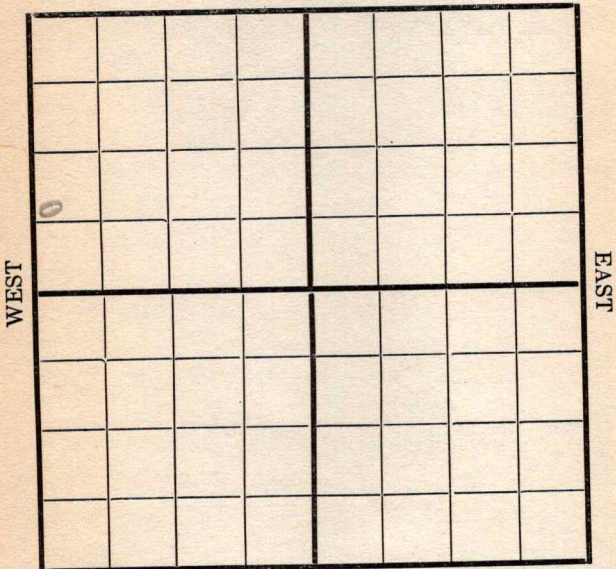

SOUTH

	RECORD
Location _____	Cased _____ in. _____ Ft.
Rig Up _____	Sand _____
Drilling and remarks	Gas _____
<u>850</u>	Oil _____
	Total Depth _____
	PRODUCTION
	1st 24 hrs. Nat. _____
	1st 24 hrs. after shot _____
	Gas _____ Cu. Ft.
	Dry Hole _____
	Abandoned _____

Date 11/9, 1916 Harvey Scout

Map No. _____ Sec. 5 Twp. 26 R. 5
 Well No. 306 _____ Farm _____
Lincoln _____ Company _____

NORTH

WEST

EAST

SOUTH

Location _____

Rig Up _____

Drilling and remarks

1050

RECORD

Cased _____ in. _____ Ft.

Sand _____

Gas _____

Oil _____

Total Depth _____

PRODUCTION

1st 24 hrs. Nat. _____

First 24 hrs. after shot _____

Gas _____ Cu. Ft.

Dry Hole _____

Abandoned _____

Date

11/14, 1916Scout

Map No. 6 Sec. 5 Twp. 26 R. 5
 Well No. 30 Farm Scout
 Company

NORTH

WEST

EAST

SOUTH

Location _____
 Rig Up _____
 Drilling and remarks

RECORD

Cased _____ in. _____ Ft.
 Sand _____
 Gas _____
 Oil _____
 Total Depth _____

PRODUCTION

1st 24 hrs. Nat. _____
 1st 24 hrs. after shot _____
 Gas _____ Cu. Ft.
 Dry Hole _____
 Abandoned _____


Date

11/20, 1916 Scout

Map No. _____ Sec. 5 Twp. 26 R. 5
Well No. 30 Line Farm _____
Swickin Company _____

NORTH

WEST

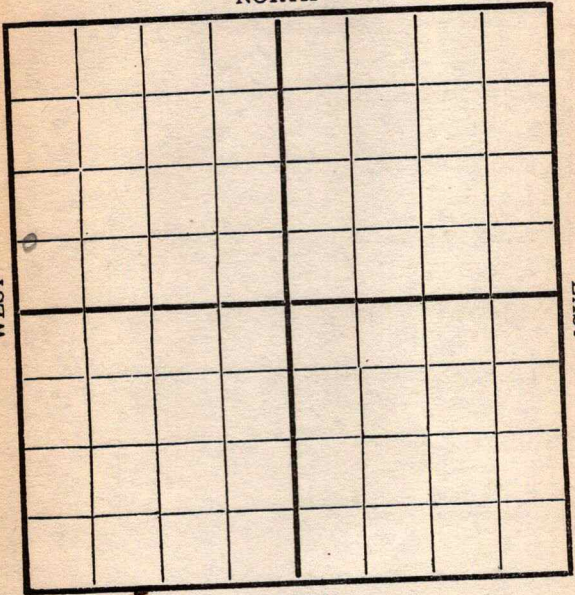

EAST

SOUTH

Location _____
Rig Up _____
Drilling and remarks _____

1915'

RECORD

Cased _____ in. _____ Ft.
Sand _____
Gas _____
Oil _____
Total Depth _____

PRODUCTION

1st 24 hrs. Nat. _____
1st 24 hrs. after shot _____
Gas _____ Cu. Ft.
Dry Hole _____
Abandoned _____

Date


11/27, 1916 Candry Scout _____

Map No. _____ Sec. 5 Twp. 26 R. 5
 Well No. 30 Linn Farm _____
Snicklin Company _____

NORTH

WEST

EAST

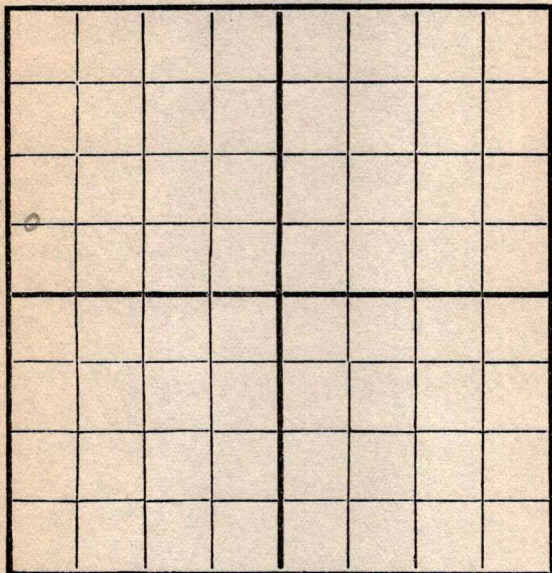

SOUTH

Location _____
 Rig Up _____
 Drilling and remarks _____

RECORD

Cased _____ in. _____ Ft.
 Sand _____
 Gas _____
 Oil _____
 Total Depth _____

PRODUCTION

1st 24 hrs. Nat. _____
 1st 24 hrs. after shot _____
 Gas _____ Cu. Ft.
 Dry Hole _____
 Abandoned _____

Date

12/4, 1916, Cordiff Scout

Map No. _____ Sec. 5 Twp. 26 R. 5Well No. 30 _____ Farm _____

Company _____

NORTH

WEST

EAST

SOUTH

Location _____

Rig Up _____

Drilling and remarks

RECORD

Cased _____ in. _____ Ft.

Sand 2440 - 2455

Gas _____

Oil _____

Total Depth _____

PRODUCTION

1st 24 hrs. Nat. _____

1st 24 hrs. after shot _____

Gas _____ Cu. Ft.

Dry Hole _____

Abandoned _____

Date

12/11, 1916, Condy Scout