

Map No. 5 Sec. 5 Twp. 26 R. 5Well No. 6-Manning Farm 1Empire Company

NORTH

WEST

EAST

COMPLETED

SOUTH

Location ✓ ✓Rig Up 12-4-16

Drilling Remarks:

Drilling Remarks:

12/11-12/18-12/28
185-1/151/1-1/8/17

RECORD

Cased in Ft.

S and

Gas

Oil

Total Depth

PRODUCTION

1st 24 hrs. Nat.

1st 24 hrs. after shot

Gas Cu. Ft.

Dry Hole


Abandoned

Map No. _____ Sec. 5 Twp. 26 R. 5
 Well No. 6 Manning Farm _____
Empire Company _____

NORTH

WEST

EAST

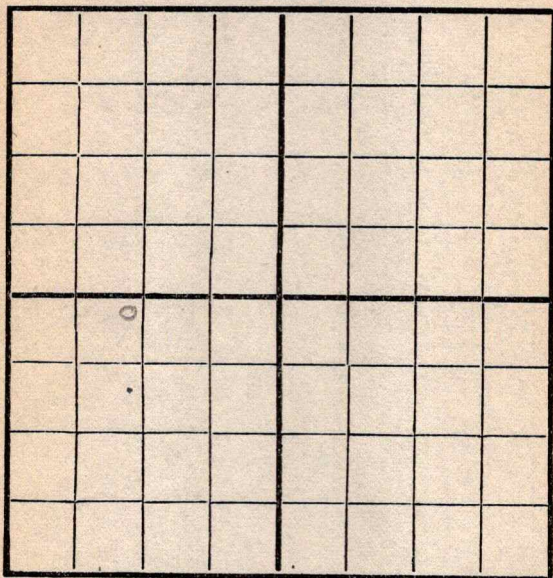

SOUTH

Location ☒Rig Up ☒

Drilling and remarks

RECORD

Cased _____ in. _____ Ft.

Sand _____

Gas _____

Oil _____

Total Depth _____

PRODUCTION

1st 24 hrs. Nat. _____

1st 24 hrs. after shot _____

Gas _____ Cu. Ft.

Dry Hole _____

Abandoned _____

Date

12/4, 1916 Cardiff Scout

Map No. _____ Sec. 5 Twp. 26 R. 5Well No. 6 Manning Farm _____8 engine Company _____

NORTH

WEST

EAST

SOUTH

Location _____

Rig Up ☒ _____

Drilling and remarks _____

RECORD

Cased _____ in. _____ Ft.

Sand _____

Gas _____

Oil _____

Total Depth _____

PRODUCTION

1st 24 hrs. Nat. _____

1st 24 hrs. after shot _____

Gas _____ Cu. Ft.

Dry Hole _____

Abandoned _____

Date

12/11, 1916, C. C. Cady Scout

Map No. _____ Sec. 5 Twp. 26 R. 5
 Well No. 6 Manning Farm _____
Engine Company _____

NORTH

WEST

EAST

SOUTH

Location _____
 Rig Up ☒ _____
 Drilling and remarks _____

RECORD

Cased _____ in. _____ Ft.
 Sand _____
 Gas _____
 Oil _____
 Total Depth _____

PRODUCTION

1st 24 hrs. Nat. _____
 1st 24 hrs. after shot _____
 Gas _____ Cu. Ft.
 Dry Hole _____
 Abandoned _____

Date

12/8 1916

Scout

Map No. _____ Sec. 5 Twp. 26 R. 5
 Well No. 6 Manning Farm
Engine Company

NORTH

WEST

EAST

SOUTH

Location _____
 Rig Up ☒
 Drilling and remarks _____

RECORD

Cased _____ in. _____ Ft.
 Sand _____
 Gas _____
 Oil _____
 Total Depth _____

PRODUCTION

1st 24 hrs. Nat. _____
 1st 24 hrs. after shot _____
 Gas _____ Cu. Ft.
 Dry Hole _____
 Abandoned _____

Date

12/28/1916


Scout

Map No. _____ Sec. 5 Twp. 26 R. 5
 Well No. 6 _____ Farm _____
Engineering Company _____

NORTH

WEST

EAST

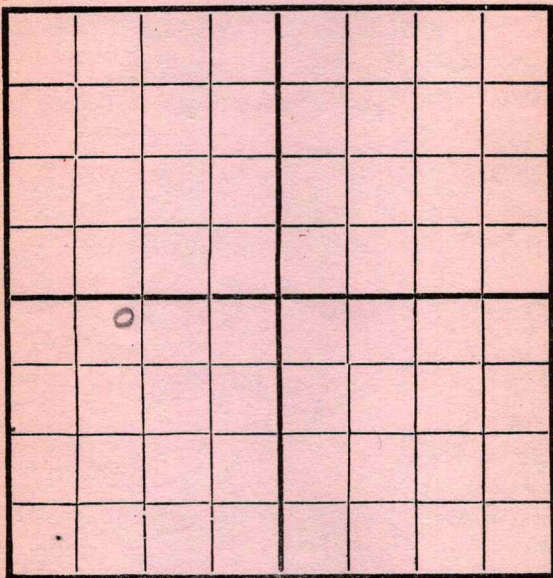

SOUTH

Location _____
 Rig Up ✓ _____
 Drilling and remarks _____

RECORD

Cased _____ in. _____ Ft.
 Sand _____
 Gas _____
 Oil _____
 Total Depth _____

PRODUCTION

1st 24 hrs. Nat. _____
 First 24 hrs. after shot _____
 Gas _____ Cu. Ft.
 Dry Hole _____
 Abandoned _____

Date

1/1, 1917 Condey Scout _____

Map No. _____ Sec. 5 Twp. 26 R. 5
 Well No. 6 _____ Farm _____
Engineer _____ Company _____

NORTH

WEST

EAST

SOUTH

Location _____

Rig Up _____

Drilling and remarks

Rigged

RECORD

Cased _____ in. _____ Ft.

Sand _____

Gas _____

Oil _____

Total Depth _____

PRODUCTION

1st 24 hrs. Nat. _____

1st 24 hrs. after shot _____

Gas _____ Cu. Ft.

Dry Hole _____

Abandoned _____

Date


1/8, 1917 Cordy Scout

Map No. _____ Sec. 5 Twp. 26 R. 5
 Well No. 6 Mummy _____ Farm _____
Engine _____ Company _____

NORTH

WEST

EAST

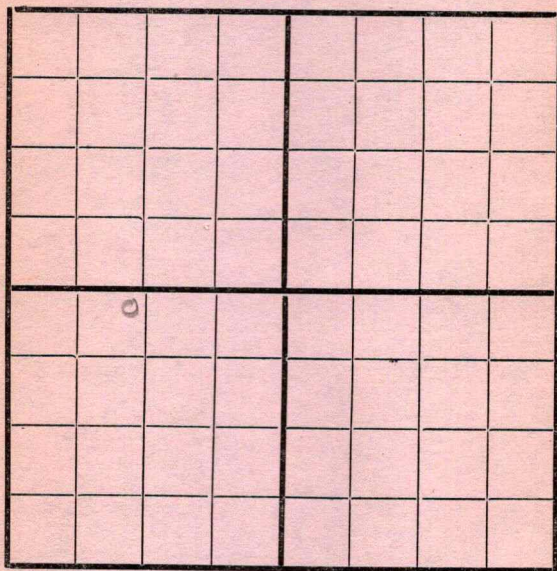

SOUTH

Location _____

Rig Up _____

Drilling and remarks

185'

RECORD

Cased _____ in. _____ Ft.

Sand _____

Gas _____

Oil _____

Total Depth _____

PRODUCTION

1st 24 hrs. Nat. _____

1st 24 hrs. after shot _____

Gas _____ Cu. Ft.

Dry Hole _____

Abandoned _____

Date

1/15, 1917 C. C. C. Scout _____

Map No. _____ Sec. 5 Twp. 26 R. 5
 Well No. 6 Manning Farm _____
Camping Company _____

NORTH

WEST

EAST

	0						

SOUTH

Location _____
 Rig Up _____
 Drilling and remarks

600

RECORD

Cased _____ in. _____ Ft.
 Sand _____
 Gas _____
 Oil _____
 Total Depth _____

PRODUCTION

1st 24 hrs. Nat. _____
 1st 24 hrs. after shot _____
 Gas _____ Cu. Ft.
 Dry Hole _____
 Abandoned _____

Date

1/22, 1917

C. L. J. Scout

Map No. _____ Sec. 5 Twp. 26 R. 5
 Well No. 6 Manning Farm _____
Empire Company _____

NORTH

WEST

EAST

SOUTH

Location _____
 Rig Up _____
 Drilling and remarks _____

*Shut
Down
600*

RECORD

Cased _____ in. _____ Ft.
 Sand _____
 Gas _____
 Oil _____
 Total Depth _____

PRODUCTION


1st 24 hrs. Nat. _____
 1st 24 hrs. after shot _____
 Gas _____ Cu. Ft.
 Dry Hole _____
 Abandoned _____

Date 1/29, 1917 Carley Scout

Map No. _____ Sec. 5 Twp. 26 R. 5
Well No. 6 Manning Farm _____
Engine Company _____

NORTH

WEST

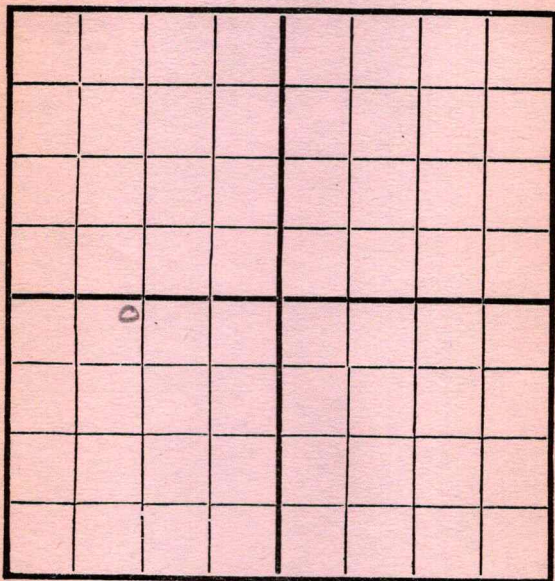

EAST

SOUTH

Location _____

Rig Up _____

Drilling and remarks

*Shut
Down
600'*

RECORD

Cased _____ in. _____ Ft.

Sand _____

Gas _____

Oil _____

Total Depth _____

PRODUCTION

1st 24 hrs. Nat. _____

First 24 hrs. after shot _____

Gas _____ Cu. Ft.

Dry Hole _____

Abandoned _____

Date


2/5 7 191 *Cardiff* Scout

Map No. _____ Sec. 5 Twp. 26 R. 5
 Well No. 6 Manning Farm _____
Engine Company _____

NORTH

WEST

EAST

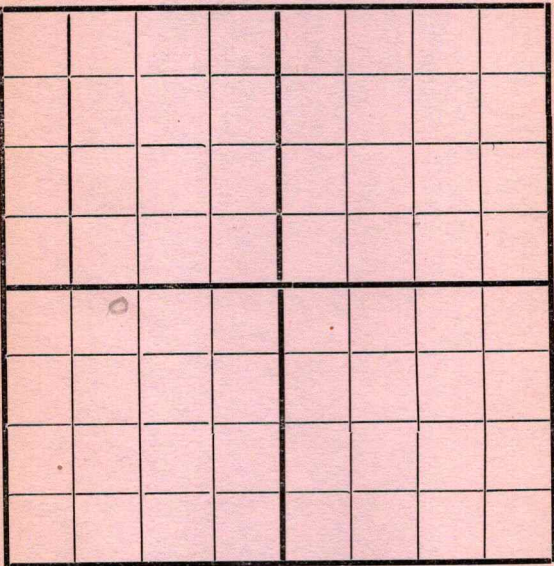

SOUTH

Location _____
 Rig Up _____
 Drilling and remarks _____

RECORD

Cased _____ in. _____ Ft.
 Sand _____
 Gas _____
 Oil _____
 Total Depth _____

PRODUCTION

1st 24 hrs. Nat. _____
 1st 24 hrs. after shot _____
 Gas _____ Cu. Ft.
 Dry Hole _____
 Abandoned _____

Date

2/12, 1917 C. A. Deery Scout

Map No. _____ Sec. 5 Twp. 26 R. 5
 Well No. 6 Manning Farm
Enterprise Company

NORTH

WEST

EAST

SOUTH

Location _____
 Rig Up _____
 Drilling and remarks

1780

RECORD

Cased _____ in. _____ Ft.
 Sand _____
 Gas _____
 Oil _____
 Total Depth _____

PRODUCTION

1st 24 hrs. Nat. _____
 1st 24 hrs. after shot _____
 Gas _____ Cu. Ft.
 Dry Hole _____
 Abandoned _____

Date


3/19, 1917 Co. 1st Scout

Map No. _____ Sec. 5 Twp. 26 R. 5
 Well No. 6 Farm _____
Company Company _____

NORTH

WEST

EAST

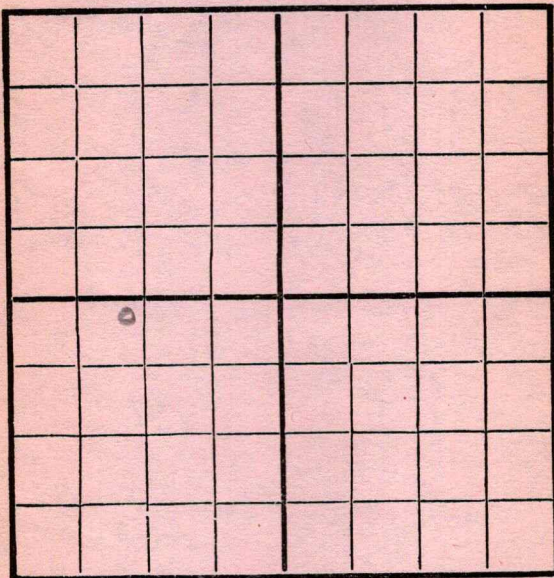

SOUTH

Location _____
 Rig Up _____
 Drilling and remarks _____

RECORD

Cased _____ in. _____ Ft.
 Sand _____
 Gas _____
 Oil _____
 Total Depth _____

PRODUCTION

1st 24 hrs. Nat. _____
 First 24 hrs. after shot _____
 Gas _____ Cu. Ft.
 Dry Hole _____
 Abandoned _____

Date


9/26, 1917 Scout

Map No. _____ Sec. 5 Twp. 26 R. 5
Well No. 6 _____ Farm _____
Engine _____ Company _____

NORTH

WEST

EAST

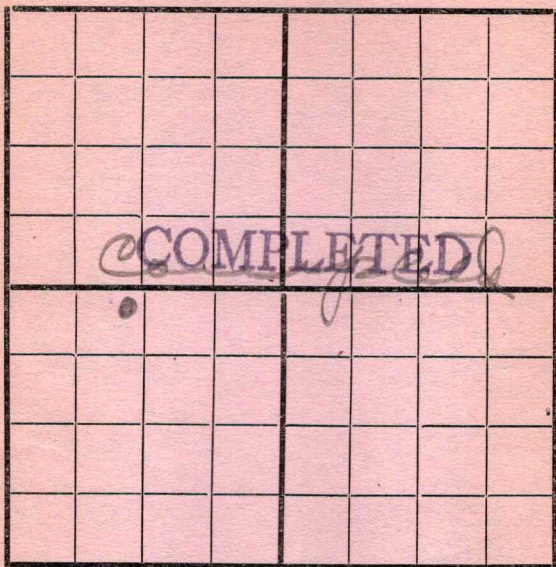

SOUTH

Location _____

Rig Up _____

Drilling and remarks

Est at 150

Bble

RECORD

Cased _____ in. _____ Ft.

Sand 2431-2451

Gas _____

Oil _____

Total Depth _____

PRODUCTION

1st 24 hrs. Nat. _____

1st 24 hrs. after shot _____

Gas _____ Cu. Ft.

Dry Hole _____

Abandoned _____

Date

3/5, 1917

Candiff Scout