FORM 51 10M 8-47

KANSAS


Butler

Section 5 Township 26 Range 5E

Well No. 17 Manning

Company Cities Service

Misc.

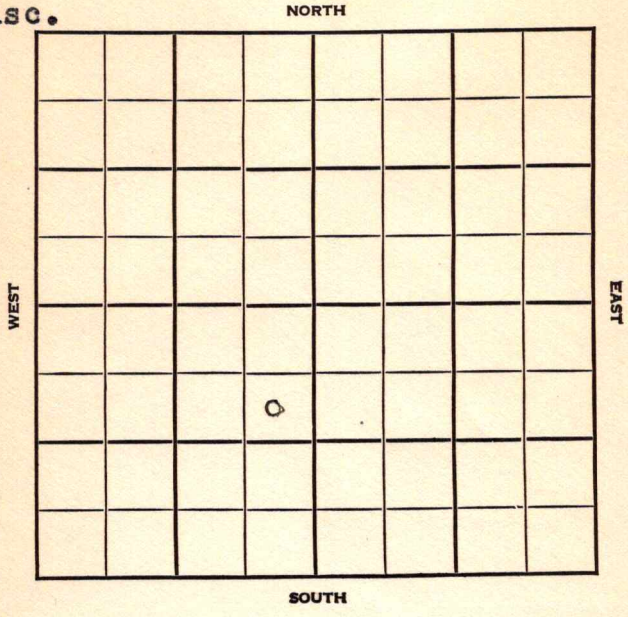

FORM 252-A
5M 9-47 PETROL

KANSAS Butler ✓

Sec. 5 Twp. 26 R. 5E

Well No. #17 Manning Farm
Cities Service Company

Misc.


990 Ft. from N. Line

Ft. from S. Line

330 Ft. from E. Line

Ft. from W. Line

SE NE SW

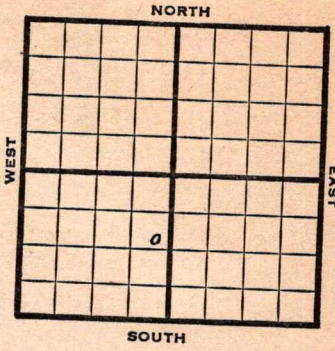

1947	Elev. 1356 REPORT
10/22	1250' Drlg.
10/29	Lansing 1708' KC 1993' BKC 2176' Arbuckle 2421' TD 2425' 5" @ 2423' RUST
11/5	Drlg. 2451'
11/12	TD 2451' 40 qts. 2435-51' Pump 72 bbls. oil in 16 hrs.
11/25	Arbuckle 2421 5" @ 2423 40 Qts. Pump 72 Pot. TD 2451 Gravity 38

COMPLETED

Form 26 200 Bks. 10-46 Petrol

Kansas Misc.

Map No. _____ Sec. 5 Twp. 26 R. 5E

Well No. 17 Manning

Cities Service Company

FIRST REPORT Contractor

SE NE SW

990 Ft. from N. Line


_____ Ft. from S. Line

330 Ft. from E. Line

_____ Ft. from W. Line

Butler County

SECTION PLAT

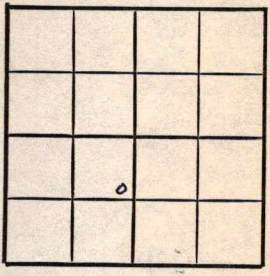

Location _____

Rig up _____

Drilling and Remarks:
1250'

RECORD

Cased _____ in., _____ ft.

Sand _____

Gas _____

Oil _____

Total Depth _____

PRODUCTION

1st 24 hrs. Nat. _____

1st 24 hrs. after shot _____

Gas _____ Cu. Ft.

Dry Hole _____

Abandoned _____

Date

OCT 22 1947 19 S. J. LEWIS Scout

Form 26 200 Bks. 10-46 Petrol

Miscellaneous

Kansas

Map No. 14 Sec. 5 Twp. 26 R. 5E

Well No. 17 Manning


Cities Service Company

COMPLETE Contractor

SE NE SW

E 1,356

SECTION PLAT

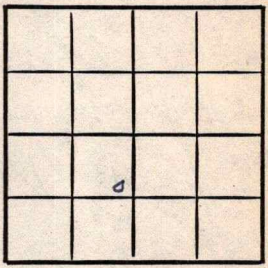

990 Ft. from N. Line

Ft. from S. Line

330 Ft. from E. Line

Ft. from W. Line

Butler County

Location

Rig up

Drilling and Remarks:

Cr # 2421

5" Cas 423

409 to

Pump 72 BO

85° Gr

RECORD

Cased in., ft.

Sand

Gas

Oil

Total Depth 2451

PRODUCTION

1st 24 hrs. Nat.

1st 24 hrs. after shot

Gas Cu. Ft.

Dry Hole

Abandoned

Date

NOV 25 1947 19

S. J. LEWIS Scout