


Section 5 Township 26 Range 5-E

Well No. #22 Manning

Company Cities Service

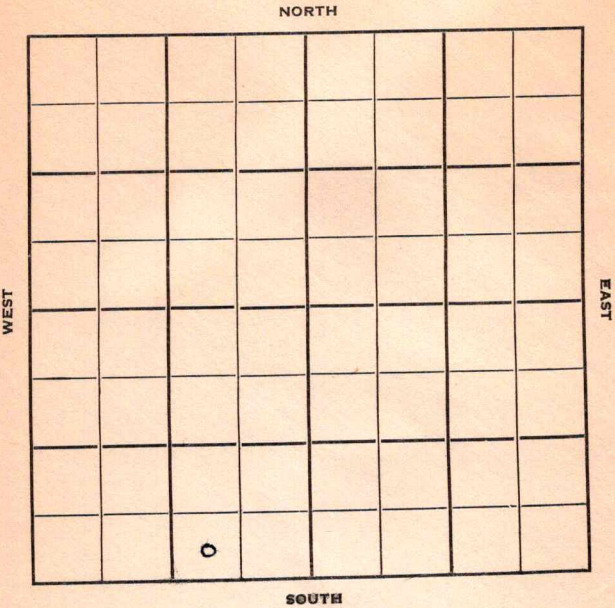

KANSAS

Sec. 5 Twp. 26 R. 5-E

Well No. #22 Manning Farm

Cities Service

Company

B & R Drlg.

Contractor


 Ft. from N. Line

330 Ft. from S. Line

990 Ft. from E. Line

 Ft. from W. Line

SW SE SW

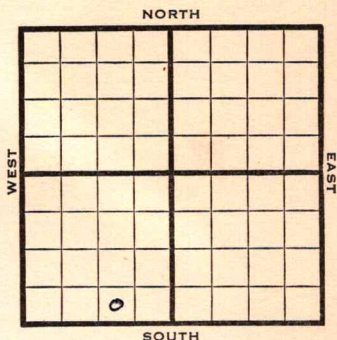

1950

Elev 1369

REPORT

7/12 8" @ 84
Drlg 850
8/16 8" @ 84
Arb 2422-25
5" @ 2423
TD 2455
FU 145' oil 6 hr
40 qt 2431-52
FU 1600' oil & wtr P/12 bo 39 bw 15 hr
Comp 27 bo 83 bwpd
Completed

COMPLETED

Kansas

Map No. _____ Sec. 5 Twp. 26 R. 5EWell No. 22 Manning

_____ Cities Service _____ Company

_____ B & R Drlg. _____ Contractor

SW SE SW

SECTION PLAT

FIRST REPORT

0

_____ Ft. from N. Line

330 Ft. from S. Line990 Ft. from E. Line

_____ Ft. from W. Line

Butler County

Location _____

Rig up _____

Drilling and Remarks:

8" @ 84

drlg. 850

RECORD

Cased _____ in., _____ ft.

Sand _____

Gas _____

Oil _____

Total Depth _____

PRODUCTION

1st 24 hrs. Nat. _____

1st 24 hrs. after shot _____

Gas _____ Cu. Ft.

Dry Hole _____

Abandoned _____

Date

JUL 12 1950 19

J. E. TYRA

Scout

County Butler State Kansas

Sec. 5 (Blk.) 26 (Sur.) 5E Map No.

Operator Cities Service

Well No. 22 Farm Manning

Elev.	1369	Location	SW SE SW
-------	------	----------	----------

A 10x10 grid with the word "COMPLETE" written diagonally across the top right and a small circle in the bottom left.

330 Ft. From S Line SW

990 Ft. From E Line Quarter

1st. Report

Completion AUG 16 1950

Remarks

Spudding Date _____

Drlg. Data Oil well TD 2455

8" @ 84 Arb. 2422-25 5" @ 2423

TD 2455 FU 145' oil 6 hr. 40 qt. 2431-5

FU 1600' oil & water P/ 12 bo 39 bw 15 n

Comp. 27 bo 83 bwpd

J. E. TYRA