

Map No. _____ Sec. 5 Twp. 26 R. 5

Well No. 7-Manning Farm _____

Empire Company _____

NORTH

WEST

EAST

SOUTH

Location ✓ ✓

Drilling Remarks:

12/11 = 12/18 = 12/28 = 1/11 = 1/8/17
4/50 = 4/15 =

Rig Up 12-4-16

Drilling Remarks:

1/11 = 1/8/17

RECORD

Cased _____ in _____ Ft.

Sand _____

Gas _____

Oil _____

Total Depth _____

PRODUCTION

1st 24 hrs. Nat. _____

1st 24 hrs. after shot _____

Gas _____ Cu. Ft.

Dry Hole _____

Abandoned _____

Map No. _____ Sec. 5 Twp. 26 R. 5Well No. 7 Manning FarmEmpire Company

NORTH

WEST

EAST

SOUTH

Location _____

Rig Up ☒

Drilling and remarks _____

RECORD

Cased _____ in. _____ Ft.

Sand _____

Gas _____

Oil _____

Total Depth _____

PRODUCTION

1st 24 hrs. Nat. _____

1st 24 hrs. after shot _____

Gas _____ Cu. Ft.

Dry Hole _____


Abandoned _____

Date

10/4, 1916, Candiff Scout

Map No. _____ Sec. 5 Twp. 26 R. 5
 Well No. 7 Manning Farm _____
Empire Company _____

NORTH

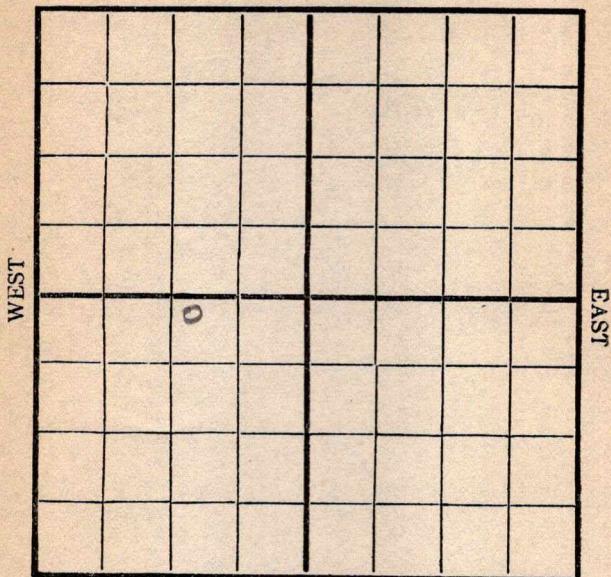

SOUTH

Location _____
 Rig Up ☒ _____
 Drilling and remarks _____

RECORD

Cased _____ in. _____ Ft.
 Sand _____
 Gas _____
 Oil _____
 Total Depth _____

PRODUCTION

1st 24 hrs. Nat. _____
 1st 24 hrs. after shot _____
 Gas _____ Cu. Ft.
 Dry Hole _____
 Abandoned _____


Date 12/11, 1916 Cordell Scout

Map No. _____ Sec. 5 Twp. 26 R. 5
 Well No. 7 _____ Farm _____
Engine _____ Company _____

NORTH

WEST

EAST

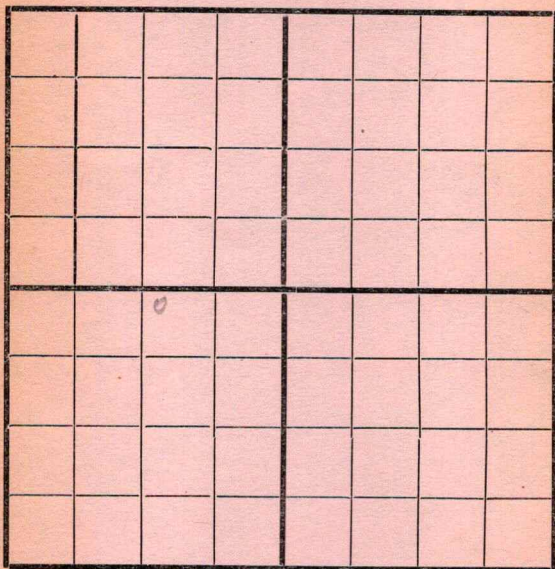

SOUTH

Location _____
 Rig Up _____
 Drilling and remarks _____

RECORD

Cased _____ in. _____ Ft.
 Sand _____
 Gas _____
 Oil _____
 Total Depth _____

PRODUCTION

1st 24 hrs. Nat. _____
 1st 24 hrs. after shot _____
 Gas _____ Cu. Ft.
 Dry Hole _____
 Abandoned _____

Date 12/18 1916 Cordell Scout

Map No. _____ Sec. 5 Twp. 26 R. 5
 Well No. 7 Manning Farm
Engine Company
 NORTH

		0					

WEST EAST

SOUTH

Location _____
 Rig Up ☒ _____
 Drilling and remarks _____

RECORD

Cased _____ in. _____ Ft.
 Sand _____
 Gas _____
 Oil _____
 Total Depth _____

PRODUCTION

1st 24 hrs. Nat. _____
 1st 24 hrs. after shot _____
 Gas _____ Cu. Ft.
 Dry Hole _____
 Abandoned _____

Date

12/28 1916 C. C. C. C. Scout

Map No. _____ Sec. 5 Twp. 26 R. 5
 Well No. 7 Manning Farm _____
Empire Company _____

NORTH

WEST

EAST

SOUTH

Location _____
 Rig Up ☒ _____
 Drilling and remarks _____

RECORD

Cased _____ in. _____ Ft.
 Sand _____
 Gas _____
 Oil _____
 Total Depth _____


PRODUCTION

1st 24 hrs. Nat. _____
 First 24 hrs. after shot _____
 Gas _____ Cu. Ft.
 Dry Hole _____
 Abandoned _____

Date

1/1, 1917 Carbide Scout _____

Map No. _____ Sec. 5 Twp. 26 R. 5
 Well No. 7 morning Farm _____
Quapine Company _____
 NORTH

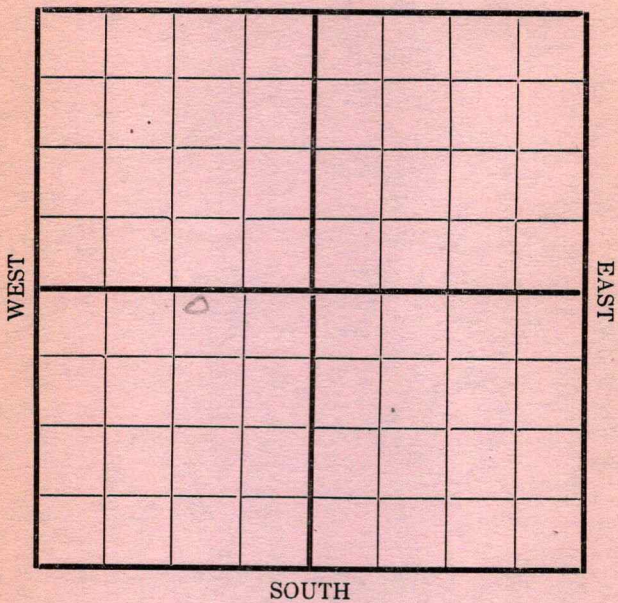

Location _____ Rig Up ☒ _____ Drilling and remarks _____	RECORD	
	Cased _____ in.	_____ Ft.
	Sand _____	
	Gas _____	
	Oil _____	
	Total Depth _____	
	PRODUCTION	
	1st 24 hrs. Nat. _____	
	1st 24 hrs. after shot _____	
	Gas _____	_____ Cu. Ft.
	Dry Hole _____	
	Abandoned _____	

Date 18, 1917 Quapine Scout

Map No. _____ Sec. 5 Twp. 26 R. 5
 Well No. 7 Mining Farm _____
Engine Company _____

NORTH

WEST

EAST

SOUTH

Location _____
 Rig Up _____
 Drilling and remarks

RECORD

Cased _____ in. _____ Ft
 Sand _____
 Gas _____
 Oil _____
 Total Depth _____

PRODUCTION

1st 24 hrs. Nat. _____
 1st 24 hrs. after shot _____
 Gas _____ Cu. Ft
 Dry Hole _____
 Abandoned _____

Date

1/15, 191 7 Card _____ Scout _____

Map No. _____ Sec. 5 Twp. 26 R. 5
 Well No. 7 Measuring Farm _____
Engine Company _____

NORTH

WEST

EAST

. SOUTH

Location _____
 Rig Up _____
 Drilling and remarks

900

RECORD

Cased _____ in. _____ Ft.
 Sand _____
 Gas _____
 Oil _____
 Total Depth _____

PRODUCTION


1st 24 hrs. Nat. _____
 1st 24 hrs. after shot _____
 Gas _____ Cu. Ft.
 Dry Hole _____
 Abandoned _____

Date

1/22, 1917 2 Carley Scout _____

Map No. _____ Sec. 5 Twp. 26 R. 5
 Well No. 7 Manning Farm _____
Engine Company _____

NORTH

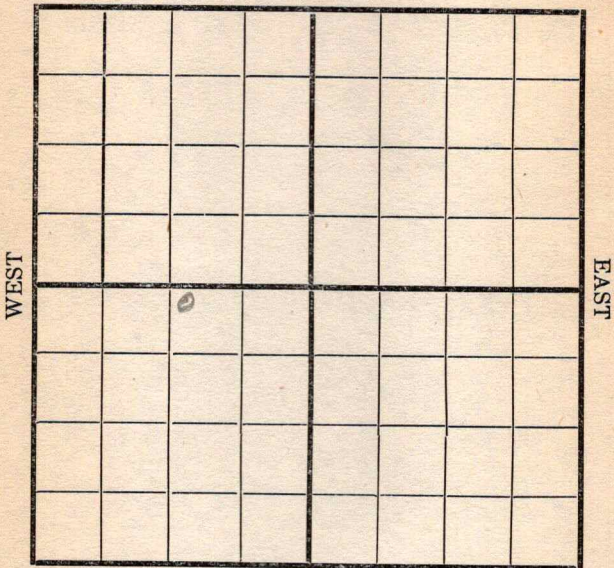

SOUTH

Location _____
 Rig Up _____
 Drilling and remarks _____

1055

RECORD

Cased _____ in. _____ Ft.
 Sand _____
 Gas _____
 Oil _____
 Total Depth _____

PRODUCTION

1st 24 hrs. Nat. _____
 1st 24 hrs. after shot _____
 Gas _____ Cu. Ft.
 Dry Hole _____
 Abandoned _____

Date


1/29, 1917 Conley Scout

Map No. _____ Sec. 5 Twp. 26 R. 5
 Well No. 7 Manning Farm _____
Empire Company _____

NORTH

WEST

EAST

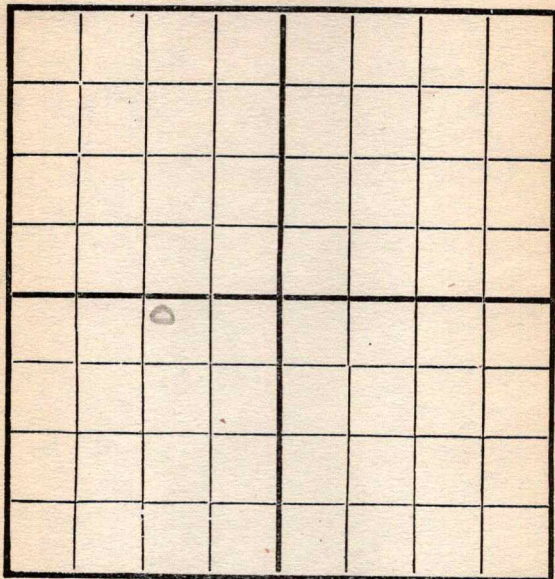

SOUTH

Location _____
 Rig Up _____
 Drilling and remarks _____

RECORD

Cased _____ in. _____ Ft.
 Sand _____
 Gas _____
 Oil _____
 Total Depth _____

PRODUCTION

1st 24 hrs. Nat. _____
 First 24 hrs. after shot _____
 Gas _____ Cu. Ft.
 Dry Hole _____
 Abandoned _____

Date


2-5-1917 _____ Scout

Map No. _____ Sec. 5 Twp. 26 R. 5
Well No. 7 Manning Farm _____
Empire Company _____

NORTH

WEST

EAST

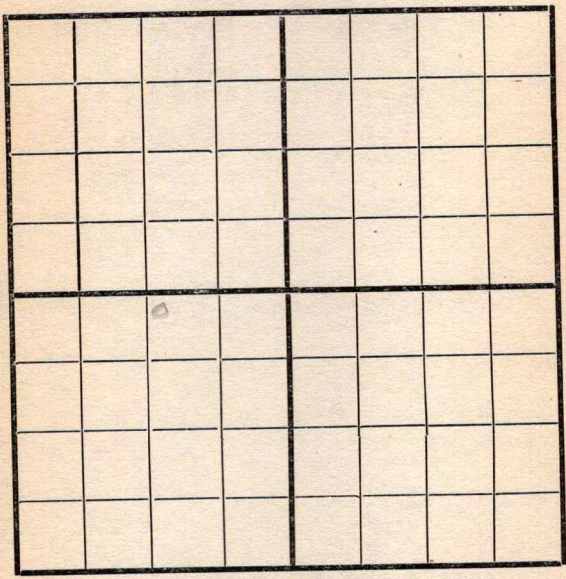

SOUTH

Location _____
Rig Up _____
Drilling and remarks

1255

RECORD

Cased _____ in. _____ Ft.
Sand _____
Gas _____
Oil _____
Total Depth _____

PRODUCTION

1st 24 hrs. Nat. _____
1st 24 hrs. after shot _____
Gas _____ Cu. Ft.
Dry Hole _____
Abandoned _____


Date 2/12, 1917 Cordell Scout _____

Map No. _____ Sec. 5 Twp. 26 R. 5
 Well No. 7 Tronny Farm
Engine Company

NORTH

WEST

EAST

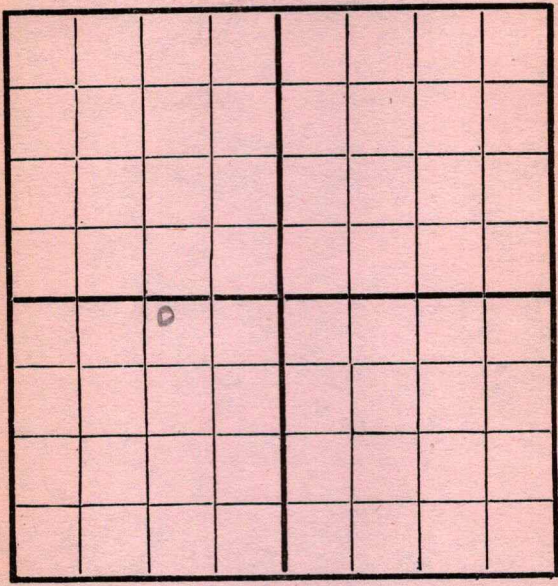

SOUTH

Location _____
 Rig Up _____
 Drilling and remarks _____

1350

RECORD

Cased _____ in. _____ Ft.
 Sand _____
 Gas _____
 Oil _____
 Total Depth _____

PRODUCTION

1st 24 hrs. Nat. _____
 1st 24 hrs. after shot _____
 Gas _____ Cu. Ft.
 Dry Hole _____
 Abandoned _____

Date


2/19, 191 7 Car Scout

Map No. _____ Sec. 5 Twp. 26 R. 5
 Well No. 7 _____ Farm _____
Company _____ Company

NORTH

WEST

EAST

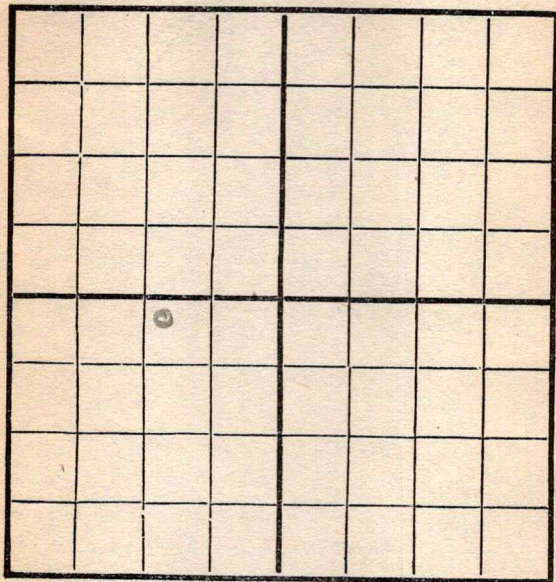

SOUTH

Location _____

Rig Up _____

Drilling and remarks

RECORD

Cased _____ in. _____ Ft.

Sand _____

Gas _____

Oil _____

Total Depth _____

PRODUCTION

1st 24 hrs. Nat. _____

First 24 hrs. after shot _____

Gas _____ Cu. Ft.

Dry Hole _____

Abandoned _____

Date

191


Scout

Map No. _____ Sec. 5 Twp. 26 R. 5
 Well No. 7 Morning Farm _____
Enterprise Company _____

NORTH

WEST

EAST

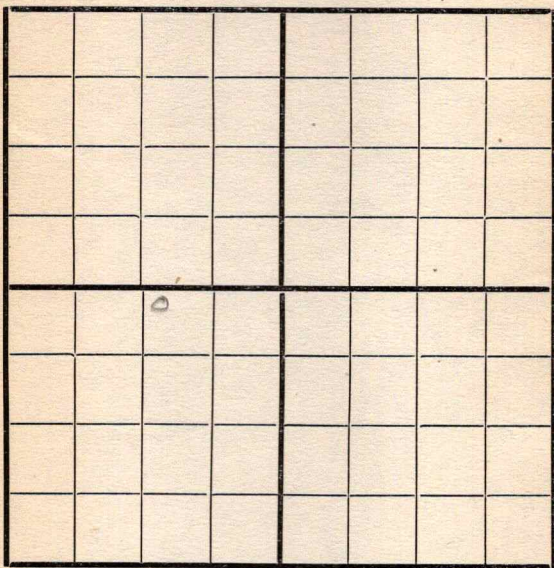

SOUTH

Location _____

Rig Up _____

Drilling and remarks

2370

RECORD

Cased _____ in. _____ Ft.

Sand _____

Gas _____

Oil _____

Total Depth _____

PRODUCTION

1st 24 hrs. Nat. _____

1st 24 hrs. after shot _____

Gas _____ Cu. Ft.

Dry Hole _____

Abandoned _____

Date

3/5, 1917

Scout

Carley


Map No. _____ Sec. 5 Twp. 26 R. 5

Well No. 7 Manning Farm
Engine Company

NORTH

WEST

EAST

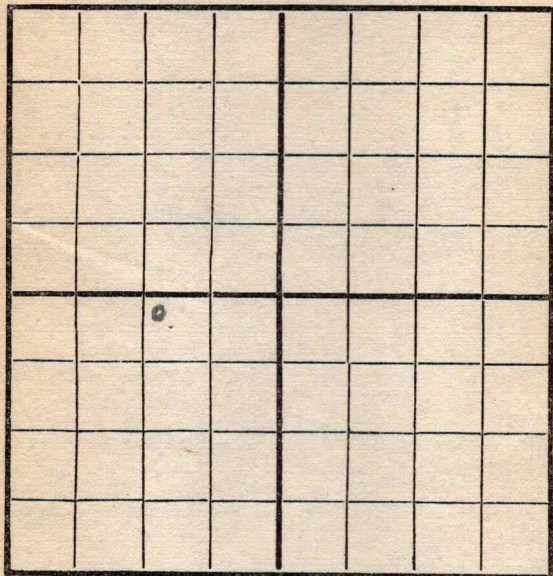

SOUTH

REMARKS:

2440'

Date

3/12, 1912

Cardeff Scout

Map No. K14 Sec. 5 Twp. 26 R. 5Well No. 7 Manning
Empire Company

Contractor

NORTH

WEST

EAST

SOUTH

COMPLETED

Location

Rig up

Drilling and Remarks:

RECORD

Cased _____ in., _____ ft.

Sand 2432-2444

Gas _____

Oil _____

Total Depth _____

PRODUCTION

1st 24 hrs. Nat. 100 bbls

1st 24 hrs. after shot _____

Gas _____ Cu. Ft.

Dry Hole _____

Abandoned _____

Date

191

8

Oyle

Scout