
Form 51—8-18 -5M—Mid West

Map No.---------- Sec. 5 Twp. 26 R. 5

Well No. 12 Manning Farm

Empire Company

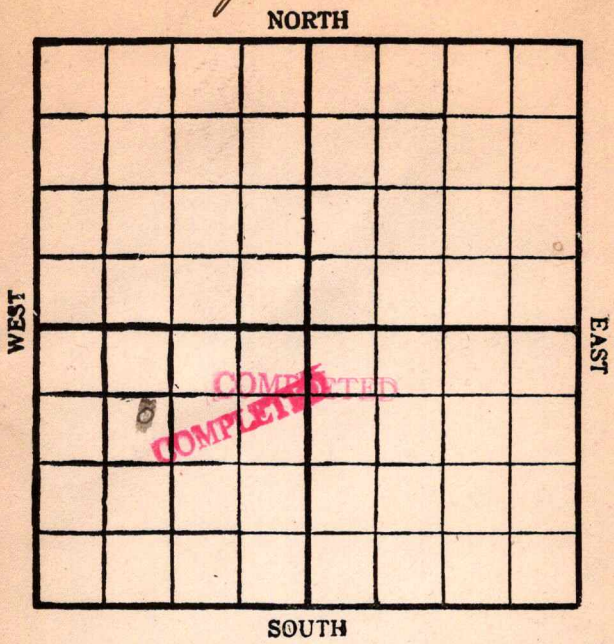

Location ----------

Drilling Remarks:

20 bbls in 6 hours

RECORD

Cased ------- in. ---------- ft.

Sand 2422 - 2455

Gas ----------

Oil ----------

Total Depth ----------

Rig Up ----------

Drilling Remarks:

PRODUCTION

1st 24 hrs. Nat. ----------

1st 24 hrs. after shot ----------

Gas ---------- cu. ft.

Dry Hole ----------

Abandoned ----------

Form 26—1M Books of 100 Sheets Each—4-15-18

Map No. K 14 Sec. 5 Twp. 26 R. 5

Well No. 12 Manning

Empire Company

Contractor

NORTH

WEST

EAST

SOUTH

FIRST REPORT

790 N 1115 W

Location

Rig up ✓

Drilling and Remarks:

RECORD

Cased in., ft.

Sand

Gas

Oil

Total Depth

PRODUCTION

1st 24 hrs. Nat.

1st 24 hrs. after shot

Gas Cu. Ft.

Dry Hole

Abandoned

Date

3/27 191 9. Scout


Form 26—!M Books of 100 Sheets Each—4-15-18

Map No. K14 Sec. 5 Twp. 26 R. 5

Well No. 12 Manning

Empire Company

Contractor

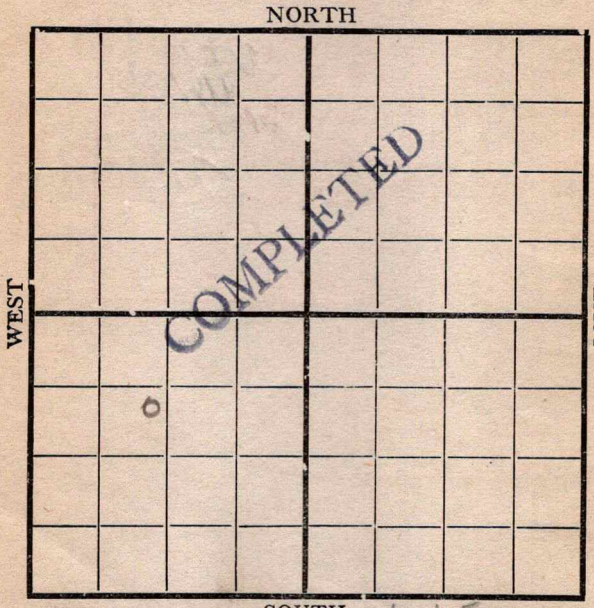

790 N 1115 W

Location

Rig up

Drilling and Remarks:

20 bbls in 6 hours

RECORD

Cased in., ft

Sand 2422 - 2455

Gas

Oil

Total Depth

PRODUCTION

1st 24 hrs. Nat.

1st 24 hrs. after shot

Gas Cu. Ft.

Dry Hole

Abandoned

Date

8/ 191 9. Cyclone Scout