


Map No. _____ Sec. 5 Twp. 26 R. 5Well No. 9 Manning Farm_____
Empire Company

NORTH

WEST

EAST

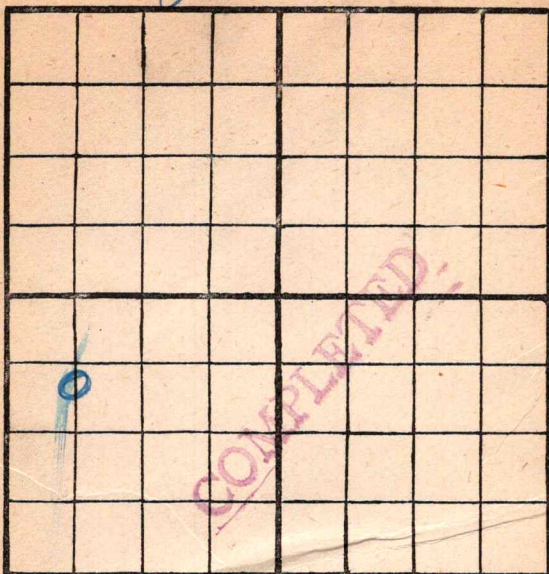

SOUTH

Location _____

Rig Up _____

Drilling Remarks:

Drilling Remarks:

RECORD

Cased _____ in. _____ ft.

Sand _____

Gas _____

Oil _____

Total Depth _____

PRODUCTION

1st 24 hrs. Nat. _____

1st 24 hrs. after shot _____

Gas _____ cu. ft

Dry Hole _____


Abandoned _____

Map No. 1004 K14 Sec. 5 Twp. 26 R. 5
Well No. 9 Manning Farm
Enterprise Company

NORTH

WEST

EAST

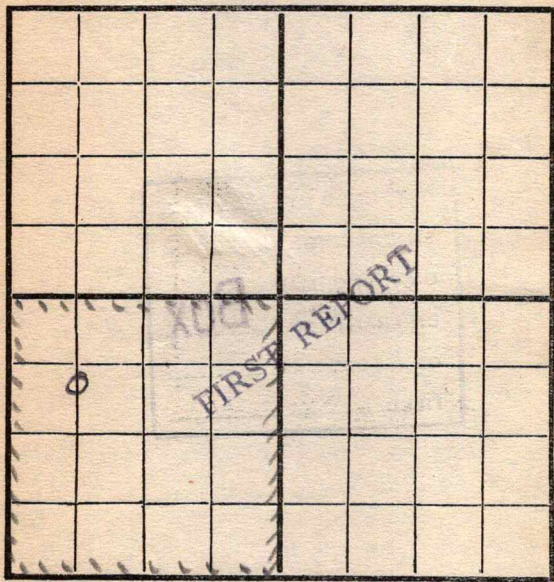

SOUTH

Location ☒
Rig Up
Drilling and remarks

660 E
760 S

RECORD

Cased _____ in. _____ Ft.
Sand _____
Gas _____
Oil _____
Total Depth _____

PRODUCTION


1st 24 hrs. Nat. _____
1st 24 hrs. after shot _____
Gas _____ Cu. Ft.
Dry Hole _____
Abandoned _____

Date 4/24 1918 Cyke Scout

Map No. _____ Sec. 5 Twp. 26 R. 5
 Well No. 9 Manning Farm _____
Empire Company _____

NORTH

WEST

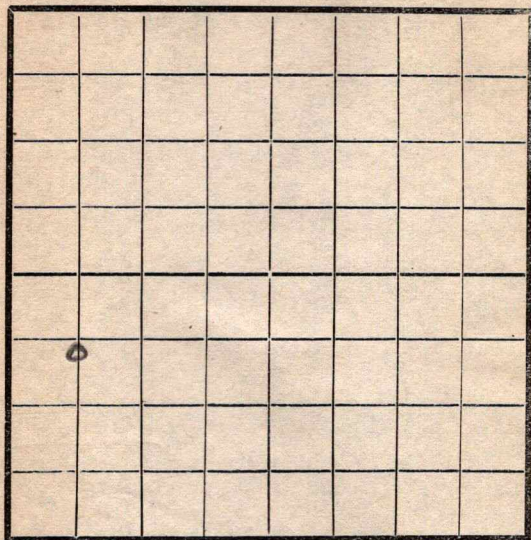

EAST

SOUTH

Location _____
 Rig Up ☒ _____
 Drilling and remarks _____

RECORD

Cased _____ in. _____ Ft.
 Sand _____
 Gas _____
 Oil _____
 Total Depth _____

PRODUCTION

1st 24 hrs. Nat. _____
 1st 24 hrs. after shot _____
 Gas _____ Cu. Ft.
 Dry Hole _____
 Abandoned _____

Date


5/1, 1918 Cyler Scout _____

Map No. _____ Sec. 5 Twp. 26 R. 5
 Well No. 9 Manning Farm _____
Empire Company _____

NORTH

WEST

EAST

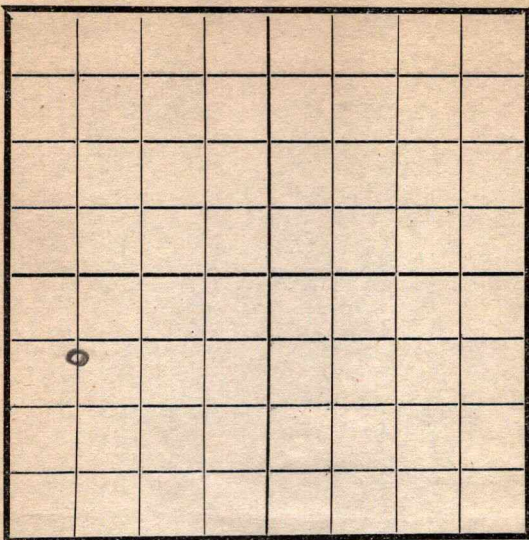

SOUTH

Location _____
 Rig Up ☒ _____
 Drilling and remarks _____

RECORD

Cased _____ in. _____ Ft.
 Sand _____
 Gas _____
 Oil _____
 Total Depth _____

PRODUCTION


1st 24 hrs. Nat. _____
 1st 24 hrs. after shot _____
 Gas _____ Cu. Ft.
 Dry Hole _____
 Abandoned _____

Date 5/8, 1918 Pyle Scout _____

Map No. _____ Sec. 5 Twp. 26 R. 5
 Well No. 9 Manning
Empire Company
 Contractor _____

NORTH

WEST

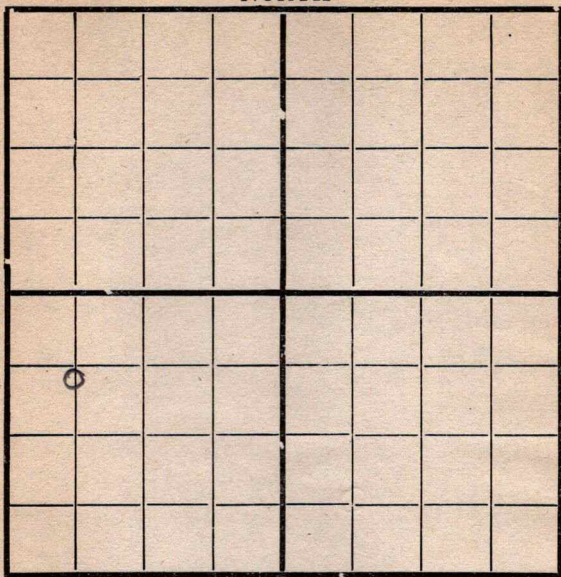

EAST

SOUTH

Location _____

Rig up _____

Drilling and Remarks:

760'

RECORD

Cased _____ in., _____ ft.

Sand _____

Gas _____

Oil _____

Total Depth _____

PRODUCTION

1st 24 hrs. Nat. _____

1st 24 hrs. after shot _____

Gas _____ Cu. Ft.

Dry Hole _____

Abandoned _____

Date

5/29 1918 Cyle Scout


Map No. _____ Sec. 5 Twp. 26 R. 5Well No. 9 Manning
Empire Company _____

Contractor _____

NORTH

WEST

EAST

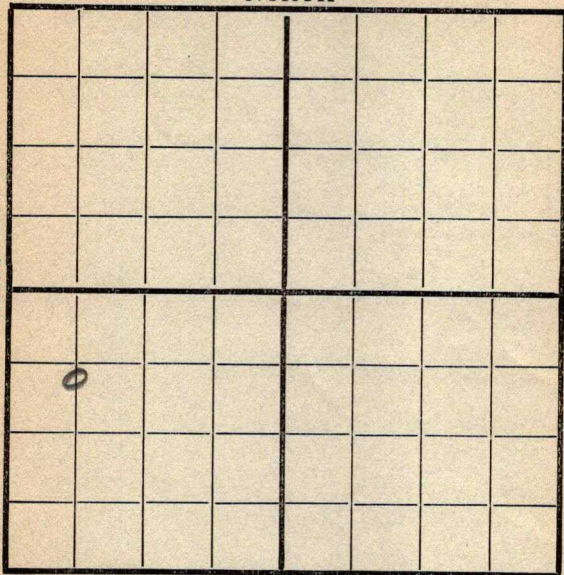

SOUTH

Location _____

Rig up _____

Drilling and Remarks:

RECORD

Cased _____ in., _____ ft.

Sand _____

Gas _____

Oil _____

Total Depth _____

PRODUCTION

1st 24 hrs. Nat. _____

1st 24 hrs. after shot _____

Gas _____ Cu. Ft.

Dry Hole _____

Abandoned _____

Date

191

Scout

Map No. _____ Sec. 5 Twp. 26 R. 5
 Well No. 9 Manning
Empire Company
 Contractor _____

NORTH

WEST

EAST

SOUTH

Location _____

Rig up _____

Drilling and Remarks:

RECORD

Cased _____ in., _____ ft.

Sand _____

Gas _____

Oil _____

Total Depth _____

PRODUCTION

1st 24 hrs. Nat. _____

1st 24 hrs. after shot _____

Gas _____ Cu. Ft.

Dry Hole _____

Abandoned _____

Date

6/12 1918 Gyle Scout

Map No. _____ Sec. 5 Twp. 26 R. 5
 Well No. 9 Manning
Empire Company
 _____ Contractor

NORTH

WEST

EAST

SOUTH

Location _____

Rig up _____

Drilling and Remarks:

RECORD

Cased _____ in., _____ ft.

Sand _____

Gas _____

Oil _____

Total Depth _____

PRODUCTION

1st 24 hrs. Nat. _____

1st 24 hrs. after shot _____

Gas _____ Cu. Ft.


Dry Hole _____

Abandoned _____

Date

6/19 1918 Byler Scout

Map No. _____ Sec. 5 Twp. 26 R. 5
 Well No. 9 Manning
Empire Company _____ Contractor _____

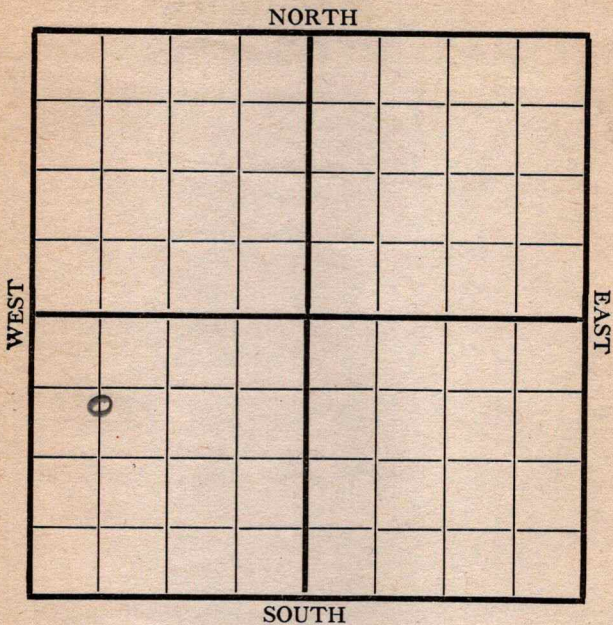

Location _____
 Rig up _____
 Drilling and Remarks:

RECORD

Cased _____ in., _____ ft.
 Sand _____
 Gas _____
 Oil _____
 Total Depth _____

PRODUCTION

1st 24 hrs. Nat. _____
 1st 24 hrs. after shot _____
 Gas _____ Cu. Ft.
 Dry Hole _____
 Abandoned _____

Date


6/26 1918 Cyle Scout

Map No. _____ Sec. 5 Twp. 26 R. 5
Well No. 2 Manning Farm _____
Empire Company _____
Date Started _____ Ft. from N. S. E. W. line

NORTH

WEST

EAST

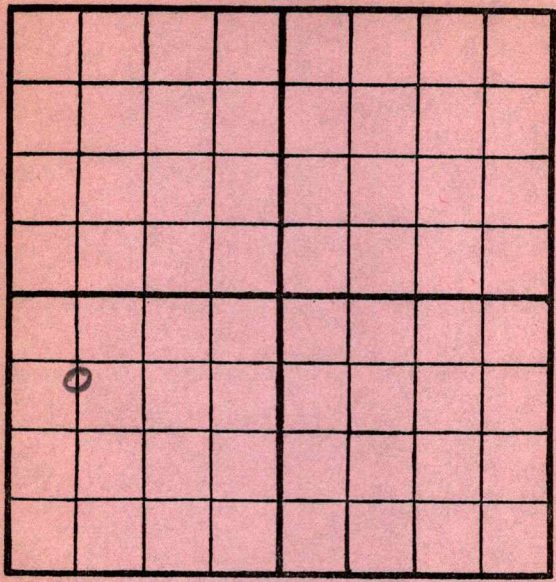

SOUTH

Cased _____ In. _____ Ft. _____	Production Remarks
Sand _____	
Pay { Gas _____ Oil _____	
Total Depth _____	

Condition of Well on this date _____

2225'

7/3/18


Gyle Scout

Map No. 5145 Sec. 5 Twp. 26 R. 5
 Well No. 9 Manning
Empire Company
 Contractor

NORTH

WEST

EAST

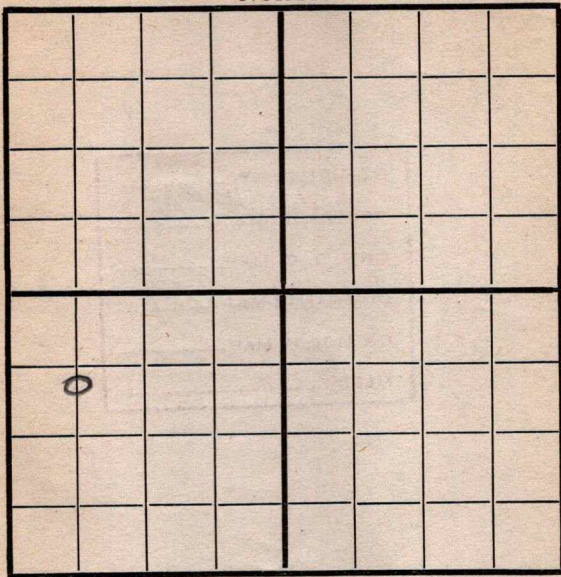

SOUTH

RECORD

Location _____

Cased _____ in., _____ ft.

Rig up _____

Sand 2445-2480

Drilling and Remarks:

Gas _____

Oil _____

Total Depth _____

PRODUCTION

1st 24 hrs. Nat. _____

1st 24 hrs. after shot _____

Gas _____ Cu. Ft.

Dry Hole _____

Abandoned _____

Date

7/10

1918

Byle Scout

*pulling big
pipe. good
showing*

Map No. 1004 K 14 Sec. 5 Twp. 26 R. 5


Well No. 9 Manning

Empire Company

Contractor

NORTH

WEST

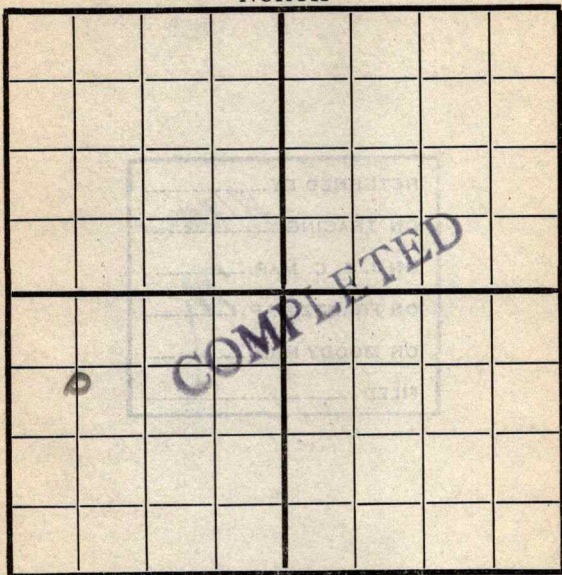

EAST

SOUTH

Location _____

Rig up _____

Drilling and Remarks:

RECORD

Cased _____ in., _____ ft.

Sand 2445-2480

Gas _____

Oil _____

Total Depth _____

PRODUCTION

1st 24 hrs. Nat. 40 bbls

1st 24 hrs. after shot _____

Gas _____ Cu. Ft.

Dry Hole _____

Abandoned _____

Date

7/17 1918

Cyle Scout