


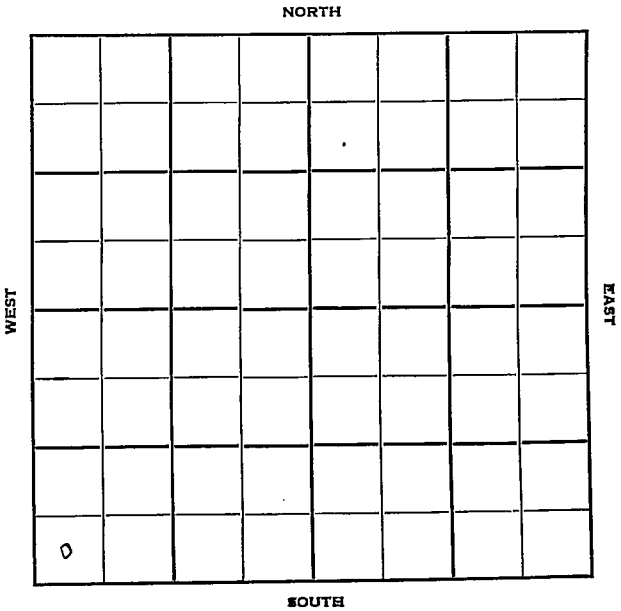

Section 5 Township 26 Range 11E

Well No. #1 Teichgraeber

Company Ward McGinnis etal



Greenwood KANSAS ✓

Sec. 5 Twp. 26 R. 11E

Well No. #1 Teichgraber Farm

Ward McGinnis et al Company

McGinnis Contractor

Miscellaneous


Ft. from N. Line

330' Ft. from S. Line

Ft. from E. Line

330' Ft. from W. Line

SW/C

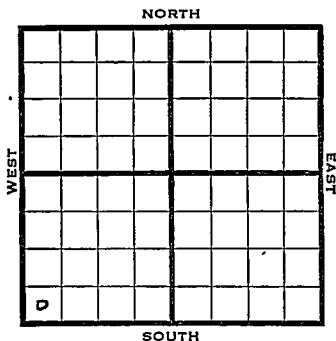

1949

REPORT

11/2

Drlg. 1420'

11/9

TD 2039'

Miss 1991'

Aband.

ABANDONED

Kansas


Miscellaneous

Map No. _____ Sec. 5 Twp. 26 R. 11EWell No. 1 Teichgraeber

Ward McGinnis et al. _____ Company

McGinnis _____ Contractor

SW/C

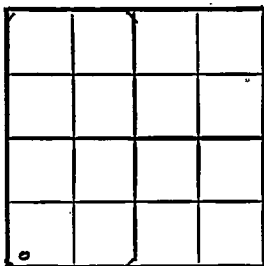FIRST REPORT
SECTION FLAT

_____ Ft. from N. Line

330 Ft. from S. Line

_____ Ft. from E. Line

330 Ft. from W. Line

Greenwood County

Location _____

Rig up _____

Drilling and Remarks:

drlg. 1420

RECORD

Cased _____ in., _____ ft.

Sand _____

Gas _____

Oil _____

Total Depth _____

PRODUCTION

1st 24 hrs. Nat. _____

1st 24 hrs. after shot _____

Gas _____ Cu. Ft.

Dry Hole _____

Abandoned _____

Date

NOV 2 1949

S. J. LEWIS Scout

Map No. _____ Sec. 5 Twp. 26 R. 11E

Well No. 1 Teichgraeber

Ward McGinnis et al. Company

ABANDONED

Contractor

SW/C


SECTION PLAT

_____ Ft. from N. Line

330 Ft. from S. Line

_____ Ft. from E. Line

330 Ft. from W. Line

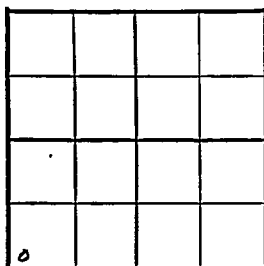

Greenwood County

Location _____

Rig up _____

Drilling and Remarks:

Misc 1891

RECORD

Cased _____ in., _____ ft.

Sand _____

Gas _____

Oil _____

Total Depth 2137

PRODUCTION

1st 24 hrs. Nat. _____

1st 24 hrs. after shot _____

Gas _____ Cu. Ft.

Dry Hole _____

Abandoned _____

Date

NOV 9 1949

19

S. J. LEWIS

Scout