


Map No. _____ Sec. 5 Twp. 26 R. 5
 Well No. 5 Price Farm _____
Empire Company _____

NORTH

WEST

EAST

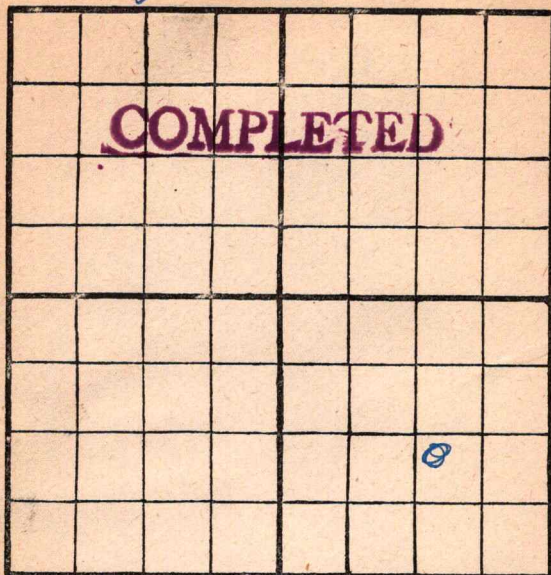

SOUTH

Location _____

Rig Up _____

Drilling Remarks:

Drilling Remarks:

RECORD

Cased _____ in. _____ ft.

Sand _____

Gas _____

Oil _____

Total Depth _____

PRODUCTION

1st 24 hrs. Nat. _____

1st 24 hrs. after shot _____

Gas _____ cu. ft

Dry Hole _____


Abandoned _____

1004 H14
Map No. _____ Sec. 5 Twp. 26 R. 5
Well No. 5 Price _____ Farm _____
_____ Company _____

NORTH

WEST

EAST

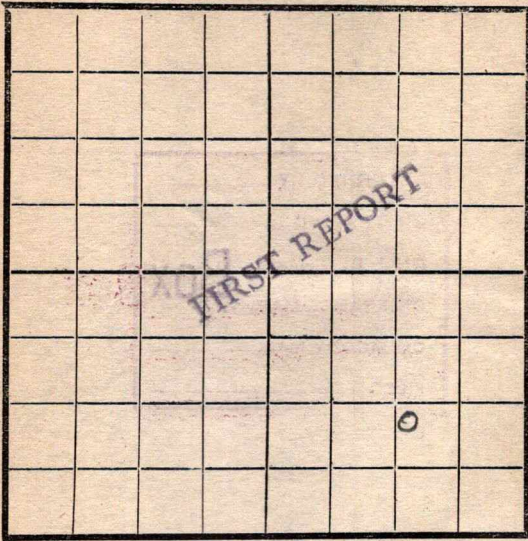

SOUTH

Location _____
Rig Up _____
Drilling and remarks _____

150'

RECORD

Cased _____ in. _____ Ft.
Sand _____
Gas _____
Oil _____
Total Depth _____

PRODUCTION

1st 24 hrs. Nat. _____
1st 24 hrs. after shot _____
Gas _____ Cu. Ft.
Dry Hole _____
Abandoned _____


Date 8/27, 1918 Pyle Scout

Map No. _____ Sec. 5 Twp. 26 R. 5
 Well No. 5 Price Farm
Empire Company

NORTH

WEST

EAST

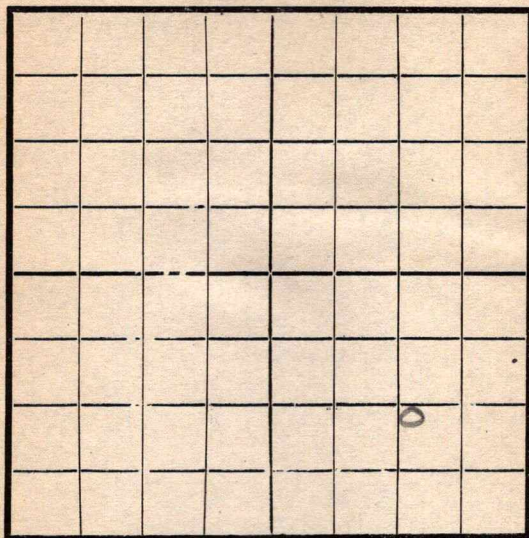

SOUTH

RECORD

Location _____
 Rig Up _____
 Drilling and remarks

Cased _____ in. _____ Ft.
 Sand _____
 Gas _____
 Oil _____
 Total Depth _____

PRODUCTION

1st 24 hrs. Nat. _____
 1st 24 hrs. after shot _____
 Gas _____ Cu. Ft.
 Dry Hole _____
 Abandoned _____


560'

Date 4/10, 1918 Price Scout

Map No. _____ Sec. 5 Twp. 26 R. 5
 Well No. 5 Grice Farm _____
Empire Company _____

NORTH

WEST

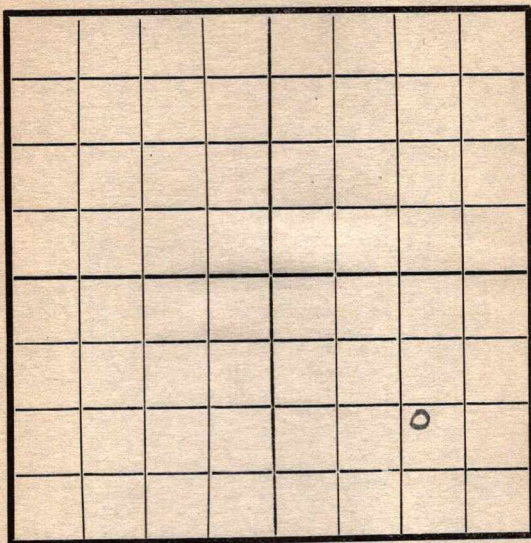

EAST

SOUTH

Location _____
 Rig Up _____
 Drilling and remarks _____

RECORD

Cased _____ in. _____ Ft.
 Sand _____
 Gas _____
 Oil _____
 Total Depth _____

PRODUCTION

1st 24 hrs. Nat. _____
 1st 24 hrs. after shot _____
 Gas _____ Cu. Ft.
 Dry Hole _____
 Abandoned _____

Date

4/17, 1918 Pyh Scout _____

Map No. 114 Sec. 15 Twp. 26 R. 5Well No. Grazier et al Farm

Company

NORTH

WEST

EAST

SOUTH

Location -----

Rig Up -----

Drilling and remarks

RECORD

Cased ----- in. ----- Ft.

Sand -----

Gas -----

Oil -----

Total Depth -----

PRODUCTION

1st 24 hrs. Nat. -----

1st 24 hrs. after shot -----

Gas ----- Cu. Ft.


Dry Hole -----

Abandoned -----

Date

-----, 191----- Scout

Map shows Drager
 et al farm owner.
 Gauntner shows
 Price
 Which is correct
 RRM

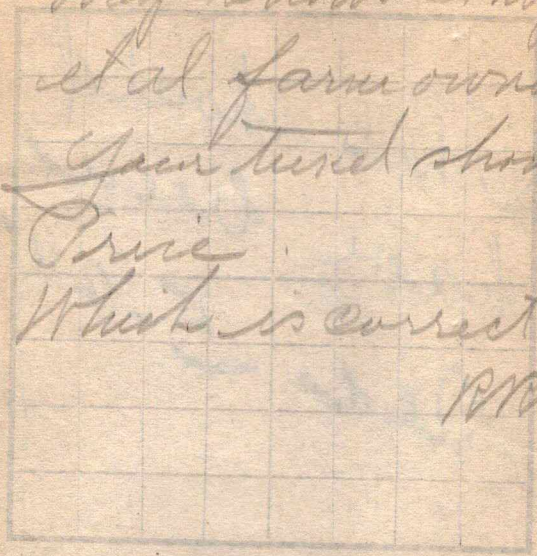

RECORD		Location
Case	in	W. 1/4
Sand		
Gas		
Oil		
Total Depth		
PRODUCTION		Delivered and retained
1st 24 hrs. Nat.		
1st 24 hrs. after shut		
Gas		
Oil		
Dry Hole		
Abandoned		


Map No. _____ Sec. 5 Twp. 26 R. 5
Well No. 5 Price (Est)
Empire _____ Company

Contractor

NORTH

WEST

EAST

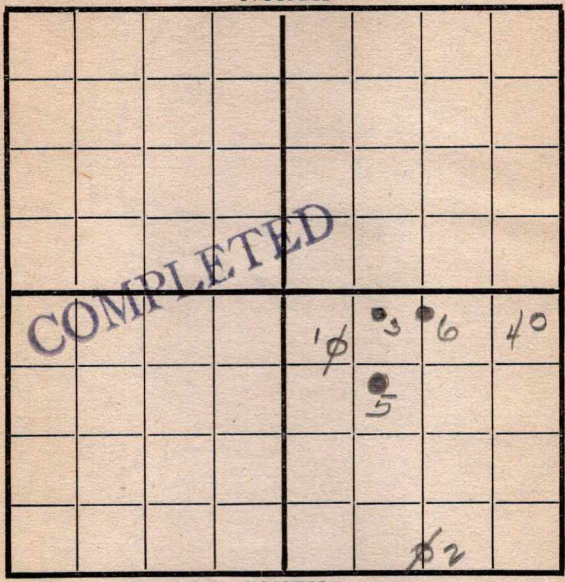

SOUTH

Location _____
Rig up _____
Drilling and Remarks:

RECORD

Cased _____ in., _____ ft.
Sand 610-631
Gas _____
Oil _____
Total Depth _____

PRODUCTION

1st 24 hrs. Nat. 12 bbls
1st 24 hrs. after shot _____
Gas _____ Cu. Ft.
Dry Hole _____
Abandoned _____

Date

7/26 1918 Cycle Scout

1004 K 14
 Map No. _____ Sec. 5 Twp. 26 R. 5
 Well No. 5 Price Farm _____
Empire Company _____

NORTH

WEST

EAST

SOUTH

RECORD

Location _____

Cased _____ in. _____ Ft.

Rig Up _____

Sand 610-631

Drilling and remarks _____

Gas _____

Oil _____

Total Depth _____

PRODUCTION

1st 24 hrs. Nat. 12 bbls

1st 24 hrs. after shot _____

Gas _____ Cu. Ft.

Dry Hole _____

Abandoned _____

Date

4/24, 1918

Scout