

KANSAS

Greenwood

Section 8 Township 26 Range 11E

Well No. 1 Eastman

Company Ward McGinnis

Misc.

NORTH

					0		

WEST

EAST

SOUTH

KANSAS

Greenwood

Sec. 8 Twp. 26 R. 11E

Well No. #1 Eastman Farm

Ward McGinnis

Miscellaneous (Ward McGinnis, Cont.) Company

NORTH


330' Ft. from N. Line

Ft. from S. Line

Ft. from E. Line

990' Ft. from W. Line

NE NW SE

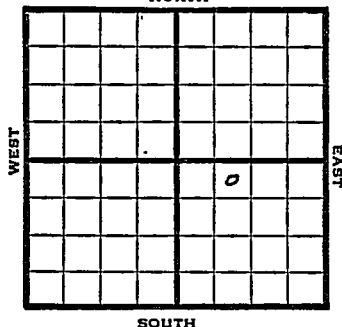

SOUTH

1949	REPORT
5/25	8" @ 95'
6/1	"
6/7	Miss 1865'-67' TD 1867'
6/15	4" @ 1861' TD 1878' 2000 acid No help
6/21	"
6/29	TD 1878' Miss 1865' 4" @ 1861' 4000 acid Pump 100 Oil Pot 40° Gr. Comp
	COMPLETED

Map No. _____ Sec. 8 Twp. 26 R. 11E

Well No. 1 Eastman

Ward McGinnis _____ Company

Ward McGinnis _____ Contractor

NE NW SE


**FIRST REPORT
SECTION PLAT**

330 Ft. from N. Line

_____ Ft. from S. Line

_____ Ft. from E. Line

990 Ft. from W. Line

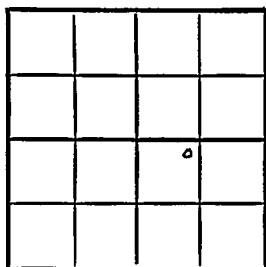

Greenwood County

Location _____

Rig up _____

Drilling and Remarks:

8" @ 95

RECORD

Cased _____ in., _____ ft.

Sand _____

Gas _____

Oil _____

Total Depth _____

PRODUCTION

1st 24 hrs. Nat. _____

1st 24 hrs. after shot _____

Gas _____ Cu. Ft.

Dry Hole _____

Abandoned _____

Date

MAY 25 1949

S. J. LEWIS

Scout

Kansas

Map No. K16 Sec. 8 Twp. 26 R. 11EWell No. 1 EastmanWard McGinnis

Company

COMPLETE

Contractor

NE NW SE

SECTION PLAT

330

Ft. from N. Line

Ft. from S. Line

Ft. from E. Line

990

Ft. from W. Line

		6	

Greenwood County

Location

Rig up

Drilling and Remarks:

*Mcs 1865**4" @ 1861**4000 acs**Pump 100 oil BT**40° S*

RECORD

Cased _____ in., _____ ft.

Sand _____

Gas _____

Oil _____

Total Depth 1828

PRODUCTION

1st 24 hrs. Nat. _____

1st 24 hrs. after shot _____

Gas _____ Cu. Ft.

Dry Hole _____

Abandoned _____

Date

JUN 29 1949

S. J. LEWIS

Scout