


Map No. _____ Sec 6 Twp 26 R 5Well No. 9 Barnhill FarmEmpire Company

NORTH

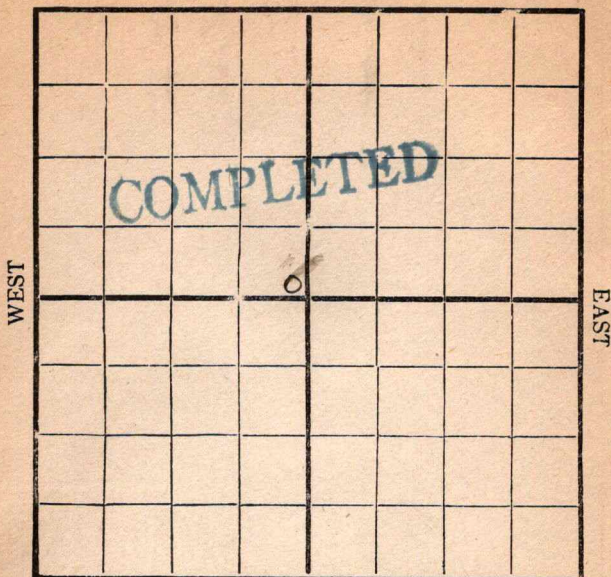

SOUTH

Location _____

Rig Up _____

Drilling Remarks:

Drilling Remarks:

RECORD

PRODUCTION

Cased _____ in _____ Ft.

1st 24 hrs. Nat _____

Sand _____

1st 24 hrs. after shot _____

Gas _____

Gas _____ Cu. Ft.

Oil _____

Dry Hole _____


Total Depth _____

Abandoned _____

Map No. _____ Sec. 6 Twp. 26 R. 5
 Well No. 9 Barnhill Farm _____

NORTH

WEST

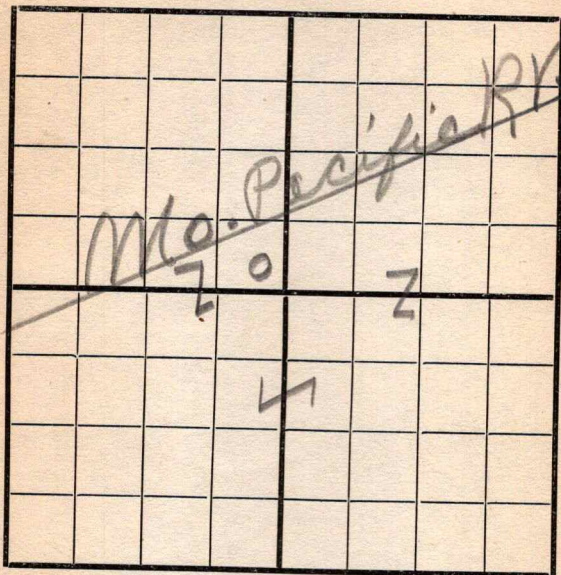

EAST

SOUTH

Location _____
 Rig Up ☒ _____
 Drilling and remarks _____

FIRST REPORT

RECORD

Cased _____ in. _____ Ft.
 Sand _____
 Gas _____
 Oil _____
 Total Depth _____

PRODUCTION


1st 24 hrs. Nat. _____
 1st 24 hrs. after shot _____
 Gas _____ Cu. Ft.
 Dry Hole _____
 Abandoned _____

Date

3/21, 1917 Candis Scout

Map No. _____ Sec. 6 Twp. 26 R. 5
Well No. 9 Barnhill Farm
Empire Company

NORTH

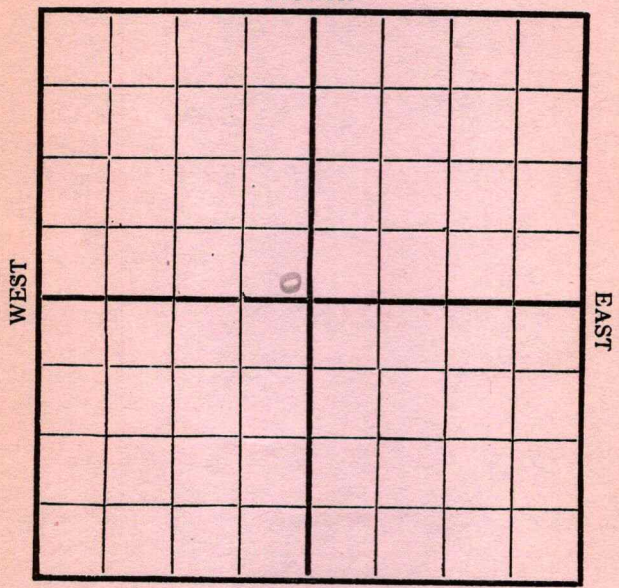

SOUTH

Location _____
Rig Up ✓ _____
Drilling and remarks _____

RECORD

Cased _____ in. _____ Ft.
Sand _____
Gas _____
Oil _____
Total Depth _____

PRODUCTION


1st 24 hrs. Nat. _____
1st 24 hrs. after shot _____
Gas _____ Cu. Ft.
Dry Hole _____
Abandoned _____

Date 3/26, 1912 Carley Scout

Map No. _____ Sec. 6 Twp. 26 R. 5
 Well No. 9 Barnhill Farm _____
Empire Company _____

NORTH

WEST

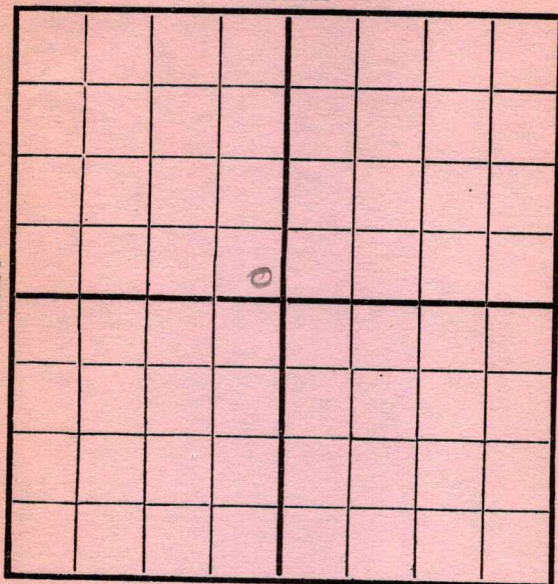

EAST

SOUTH

Location _____

Rig Up _____

Drilling and remarks

Rigged up

RECORD

Cased _____ in. _____ Ft.

Sand _____

Gas _____

Oil _____

Total Depth _____

PRODUCTION

1st 24 hrs. Nat. _____

1st 24 hrs. after shot _____

Gas _____ Cu. Ft.

Dry Hole _____

Abandoned _____

Date


4/11, 1917 Cord Scout

Map No. _____ Sec. 6 Twp. 26 R. 5

NORTH

WEST

EAST

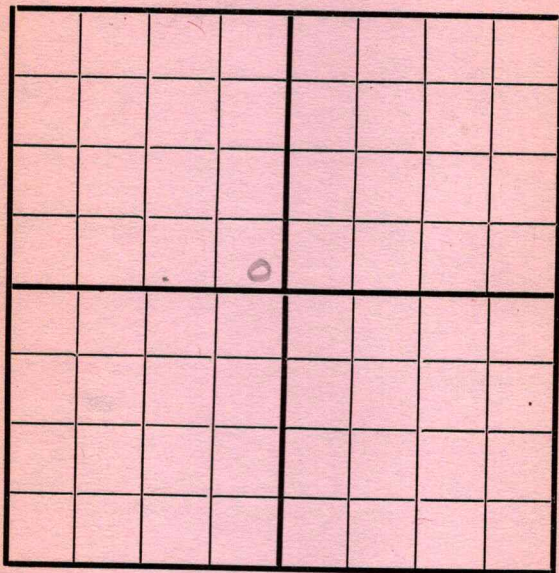

SOUTH

Location _____
 Rig Up _____
 Drilling and remarks _____

RECORD

Cased _____ in. _____ Ft.
 Sand _____
 Gas _____
 Oil _____
 Total Depth _____

PRODUCTION

1st 24 hrs. Nat. _____
 1st 24 hrs. after shot _____
 Gas _____ Cu. Ft.
 Dry Hole _____
 Abandoned _____

Date 4/19, 1917 Carby Scout

Map No. _____ Sec. 6 Twp. 26 R. 5
 Well No. 9 Barnhill Farm _____
Engine Company _____

NORTH

WEST

EAST

SOUTH

Location _____
 Rig Up ✓ _____
 Drilling and remarks _____

RECORD

Cased _____ in. _____ Ft.
 Sand _____
 Gas _____
 Oil _____
 Total Depth _____

PRODUCTION

1st 24 hrs. Nat. _____
 1st 24 hrs. after shot _____
 Gas _____ Cu. Ft.
 Dry Hole _____
 Abandoned _____


Date

4/25, 191

Scout

Map No. _____ Sec. 6 Twp. 26 R. 5
 Well No. 9 Barnhill Farm _____
Empire Company _____

NORTH

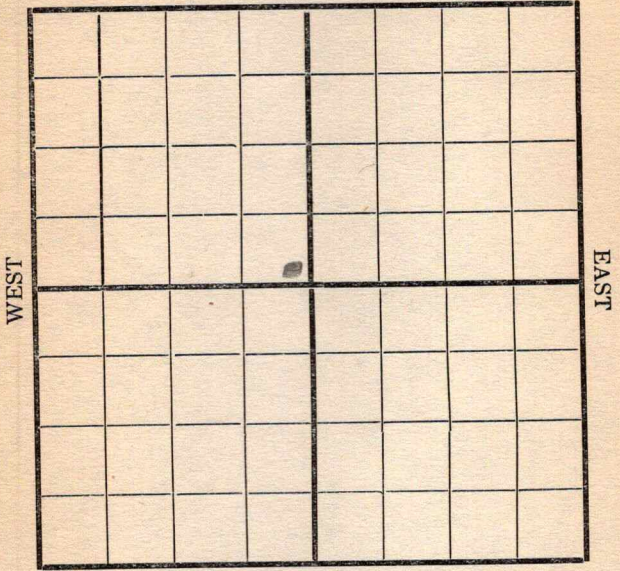

SOUTH

Location _____
 Rig Up _____
 Drilling and remarks _____

RECORD

Cased _____ in. _____ Ft.
 Sand _____
 Gas _____
 Oil _____
 Total Depth _____

PRODUCTION


1st 24 hrs. Nat. _____
 1st 24 hrs. after shot _____
 Gas _____ Cu. Ft.
 Dry Hole _____
 Abandoned _____

Date _____
APR 20 1917
 _____, 191 _____

Candell Scout

Map No. _____ Sec. 6 Twp. 26 R. 5
 Well No. 9 Barnhill Farm _____
 _____ Emp. Company _____

NORTH

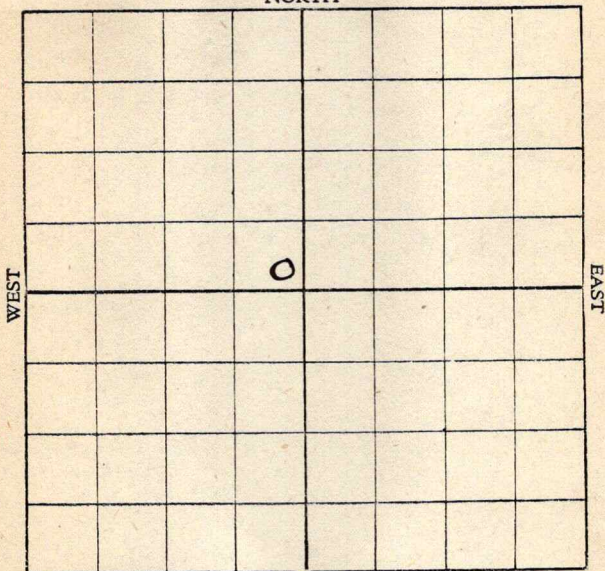

SOUTH

Location _____

Rig up _____

Drilling and remarks:

Rig up.

RECORD

Cased _____ in. _____ Ft.

Sand _____

Gas _____

Oil _____

Total Depth _____

PRODUCTION

1st 24 hrs. Nat. _____

1st 24 hrs. after shot _____

Gas _____ Cu. Ft.


Dry Hole _____

Abandoned _____

Date

5/5, 1917 Crocker scout

Map No. _____ Sec. 6 Twp. 26 R. 5
Well No. 9 Barnhill Farm _____
Emp. Company _____
NORTH

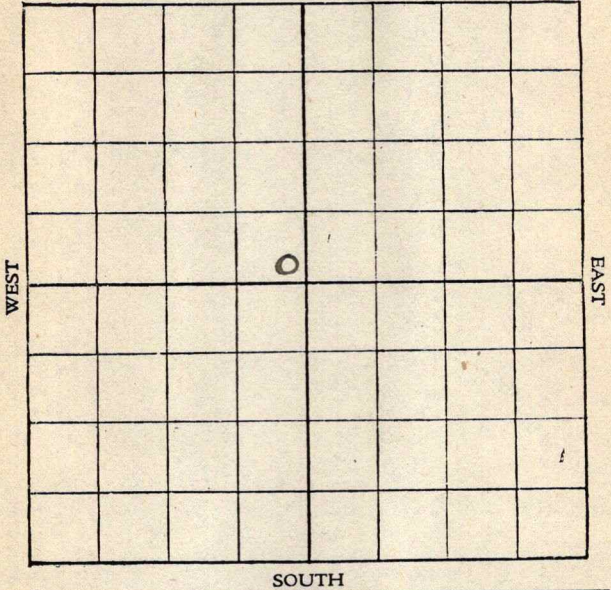

Location _____
Rig up _____
Drilling and remarks:

Rign up

RECORD

Cased _____ in. _____ Ft.
Sand _____
Gas _____
Oil _____
Total Depth _____

PRODUCTION

1st 24 hrs. Nat. _____
1st 24 hrs. after shot _____
Gas _____ Cu. Ft.
Dry Hole _____
Abandoned _____

Date

5/12, 1917, Crocker Scout

Map No. _____ Sec. 6 Twp. 26 R. 5
Well No. 9 Barnhill Farm _____
Emp. Company _____
NORTH

WEST								EAST
				0				
SOUTH								

Location _____

Rig up _____

Drilling and remarks:

Rig up

RECORD

Cased _____ in. _____ Ft.

Sand _____

Gas _____

Oil _____

Total Depth _____

PRODUCTION

1st 24 hrs. Nat. _____

1st 24 hrs. after shot _____

Gas _____ Cu. Ft.

Dry Hole _____

Abandoned _____


Date

5/19/27, 1917, Crocker Scout

Map No. _____ Sec. 6 Twp. 26 R. 5Well No. 9 Barnhill _____ FEmp.

Compa

NORTH

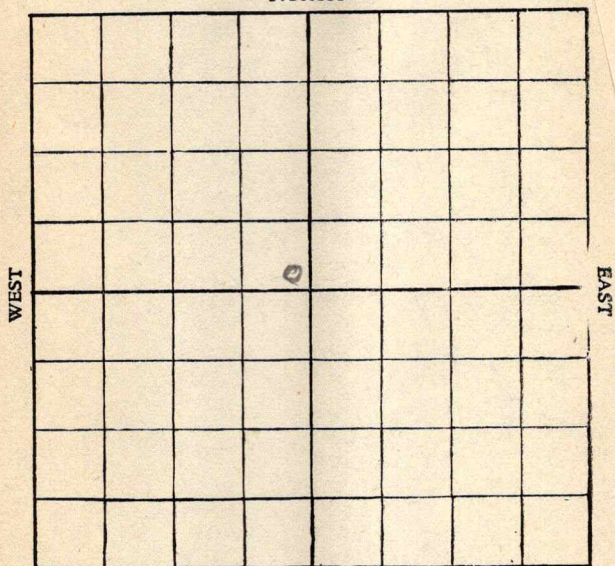

SOUTH

Location _____

Rig up _____

Drilling and remarks:

Rigged up

RECORD

Cased _____ in. _____ Ft.

Sand _____

Gas _____

Oil _____

Total Depth _____

PRODUCTION

1st 24 hrs. Nat. _____

1st 24 hrs. after shot _____

Gas _____ Cu. Ft.

Dry Hole _____


Abandoned _____

Date

5/26, 1917, Coscker Scout

Map No. _____ Sec. 6 Twp. 26 R. 5
 Well No. 9 Burnhill Farm _____
8 mi. Company _____

NORTH

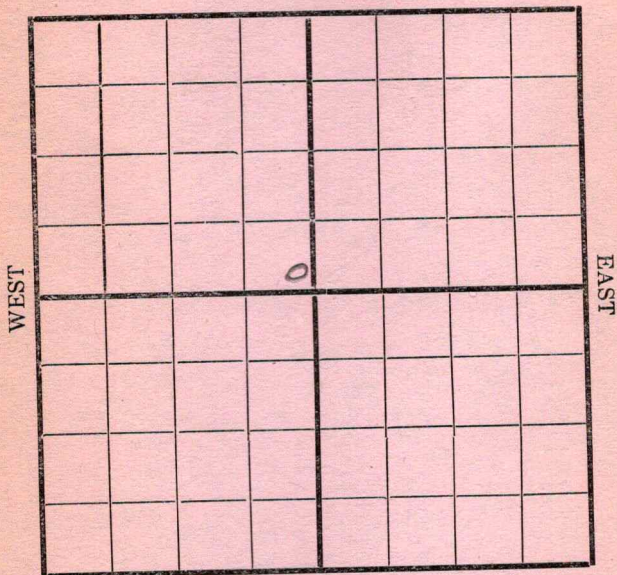

SOUTH

Location _____

Rig Up _____

Drilling and remarks

*Tools on
Ground*

RECORD

Cased _____ in. _____ Ft.

Sand _____

Gas _____

Oil _____

Total Depth _____

PRODUCTION

1st 24 hrs. Nat. _____

1st 24 hrs. after shot _____

Gas _____ Cu. Ft.

Dry Hole _____


Abandoned _____

Date

Apr 7 1917 Crocker Scout

Map No. _____ Sec. 6 Twp. 26 R. 5
 Well No. 9 Barhill Farm _____
Emp Company _____

NORTH

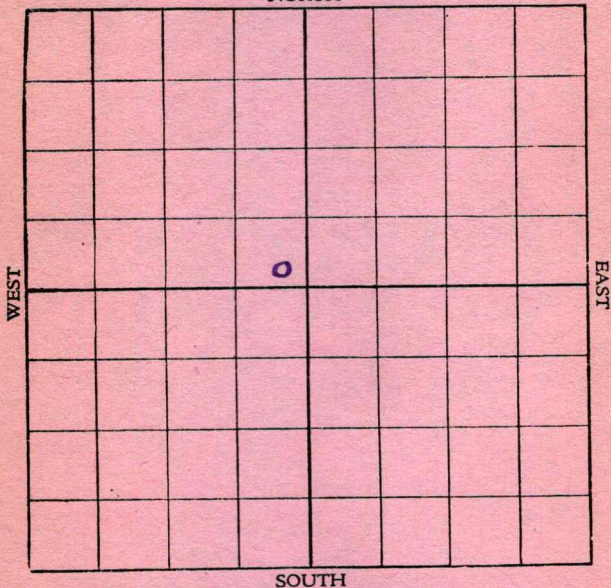

SOUTH

Location _____
 Rig up _____
 Drilling and remarks:

Rigged up

RECORD

Cased _____ in. _____ Ft.
 Sand _____
 Gas _____
 Oil _____
 Total Depth _____

PRODUCTION


1st 24 hrs. Nat. _____
 1st 24 hrs. after shot _____
 Gas _____ Cu. Ft.
 Dry Hole _____
 Abandoned _____

Date

JUN 8 - 1917 *E. J. Crocker* Scout

Map No. _____ Sec. 6 Twp. 26 R. 5
 Well No. 9 Barnhill Farm _____
Emp. Company _____

NORTH

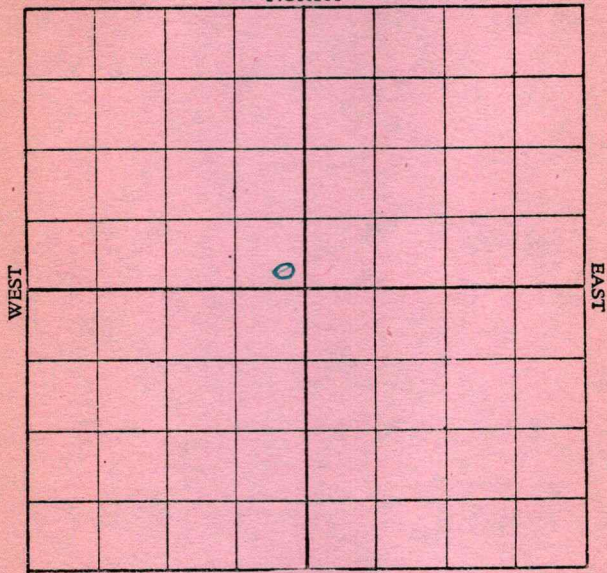

SOUTH

Location _____

Rig up _____

Drilling and remarks:

D-250'

RECORD

Cased _____ in. _____ Ft.

Sand _____

Gas _____

Oil _____

Total Depth _____

PRODUCTION

1st 24 hrs. Nat. _____

1st 24 hrs. after shot _____

Gas _____ Cu. Ft.

Dry Hole _____

Abandoned _____

Date


JUN 16 1917

, 191

E. T. Crocker Scout

Map No. _____ Sec. 6 Twp. 26 R. 5
Well No. 9 Barnhill Farm _____
Empire Company _____

NORTH

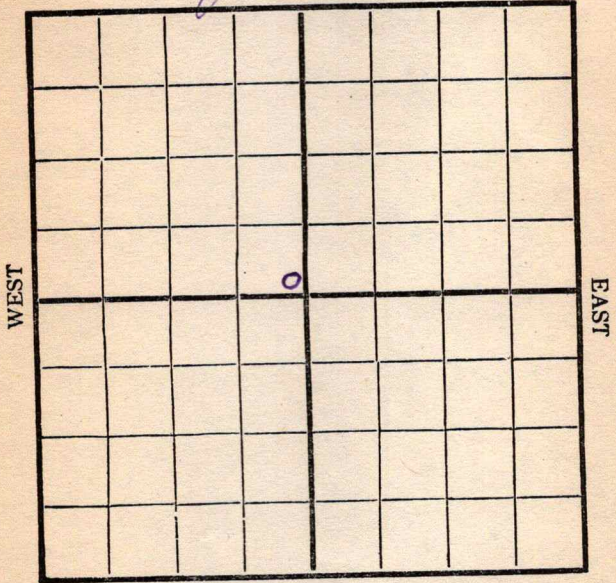

SOUTH

Location _____
Rig Up _____
Drilling and remarks _____

5-950

RECORD

Cased _____ in. _____ Ft.
Sand _____
Gas _____
Oil _____
Total Depth _____

PRODUCTION

1st 24 hrs. Nat. _____
First 24 hrs. after shot _____
Gas _____ Cu. Ft.
Dry Hole _____
Abandoned _____

Date


JUN 22 1917

C. J. Crocker

Scout

Map No. _____ Sec. 6 Twp. 26 R. 5Well No. 9 Barnhill Farm_____Empire_____
Company

NORTH

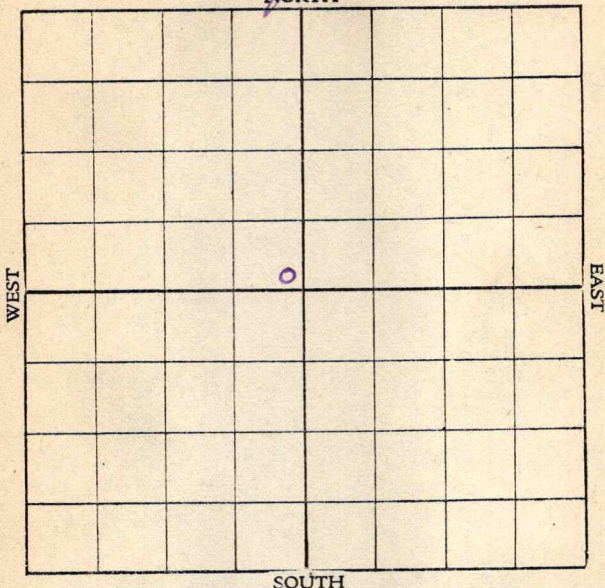

SOUTH

Location _____

Rig up _____

Drilling and remarks:

D-1520'

RECORD

Cased _____ in. _____ Ft.

Sand _____

Gas _____

Oil _____

Total Depth _____

PRODUCTION

1st 24 hrs. Nat. _____

1st 24 hrs. after shot _____

Gas _____ Cu. Ft.

Dry Hole _____

Abandoned _____


Date JUN 30 1917

_____, 191

E. J. Crocker Scout

Map No. _____ Sec. 6 Twp. 25 R. 5
 Well No. 9 Barnhill Farm _____
 _____ Emp Company

NORTH

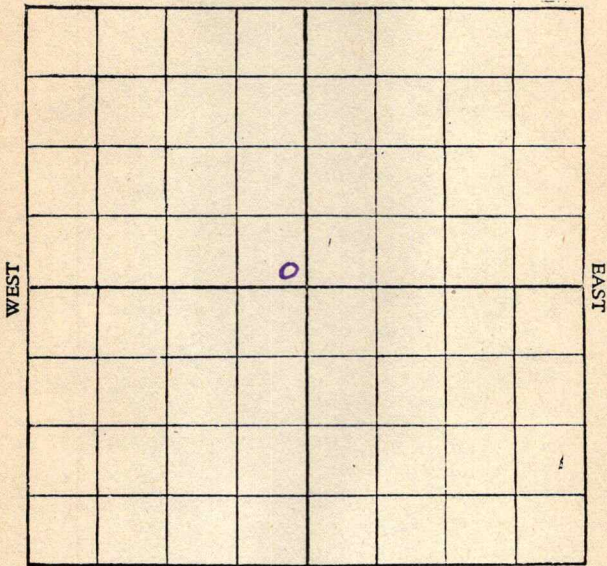

SOUTH

Location _____

Rig up _____

Drilling and remarks:

D-2090'

RECORD

Cased _____ in. _____ Ft.

Sand _____

Gas _____

Oil _____

Total Depth _____

PRODUCTION

1st 24 hrs. Nat. _____

1st 24 hrs. after shot _____

Gas _____ Cu. Ft.

Dry Hole _____

Abandoned _____

Date


JUL 7 1917

E. J. Crocker Scout

Map No. _____ Sec. 6 Twp. 26 R. 5

Well No. 9 Barkhill Farm _____
Empire Company

NORTH

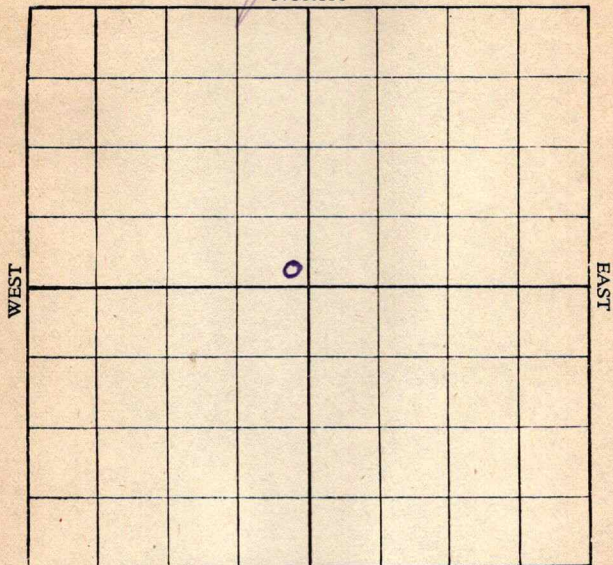

SOUTH

Location _____

Rig up _____

Drilling and remarks:

9-2350

RECORD

Cased _____ in. _____ Ft.

Sand _____

Gas _____

Oil _____

Total Depth _____

PRODUCTION

1st 24 hrs. Nat. _____

1st 24 hrs. after shot _____

Gas _____ Cu. Ft.

Dry Hole _____


Abandoned _____

Date

JUL 14 1917

G. V. Crocker
 Scout

Map No. _____ Sec. 6 Twp. 26 R. 5
 Well No. 9 Barnhill Farm
Empire Company
 NORTH

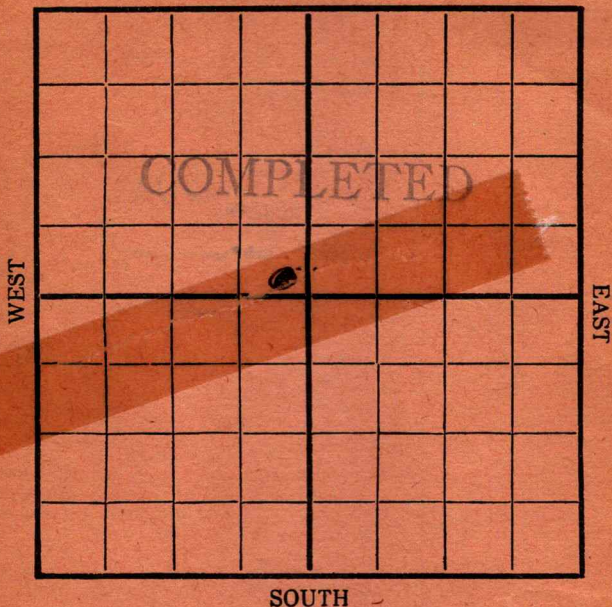

Location _____

Rig Up _____

Drilling and remarks

E2464/80

Bbl

RECORD

Cased _____ in. _____ Ft.

Sand 2449-2481

Gas _____

Oil _____

Total Depth _____

PRODUCTION

1st 24 hrs. Nat. _____

1st 24 hrs. after shot _____

Gas _____ Cu. Ft.

Dry Hole _____

Abandoned _____

Date

8/1, 1917 Cordiff Scout

Sec. 6, Twp 26 S, Range 5 E.

