

Map No. _____ Sec. 6 Twp. 26 R. 5

Well No. 10 Barnhill Farm

Empire Company

NORTH

WEST

EAST

SOUTH

Location -----

Drilling Remarks:

Rig Up-----

Drilling Remarks:

RECORD

Cased_____ in_____Ft.

Sand -----

Gas _____

Oil _____

Total Depth_____

PRODUCTION

1st 24 hrs. Nat-----

1st 24 hrs. after shot-----

Gas_____Cu. Ft.

Dry Hole_____


Abandoned -----

Map No. _____ Sec. 6 Twp. 26 R. 5
Well No. 10 Barnhill Farm
Empire Company

NORTH

WEST

EAST

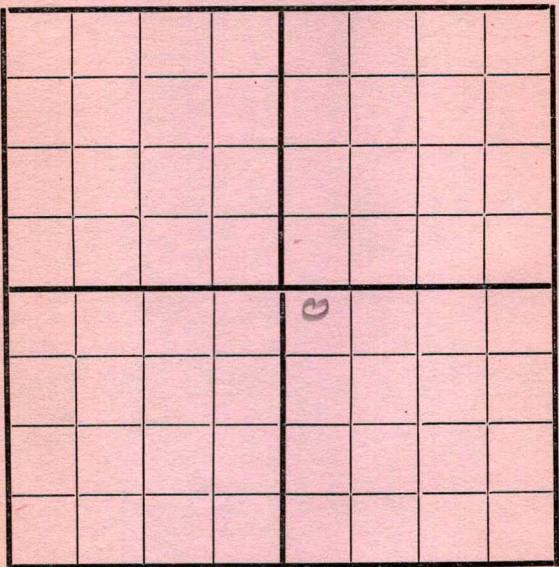

SOUTH

Location _____
Rig Up ☒ _____
Drilling and remarks _____

FIRST REPORT

RECORD

Cased _____ in. _____ Ft.
Sand _____
Gas _____
Oil _____
Total Depth _____

PRODUCTION


1st 24 hrs. Nat. _____
1st 24 hrs. after shot _____
Gas _____ Cu. Ft.
Dry Hole _____
Abandoned _____

Date 3/21, 1917 C. Conley Scout

Map No. _____ Sec. 6 Twp. 26 R. 5
 Well No. 10 Barnhill Farm _____
Craig Company _____

NORTH

WEST

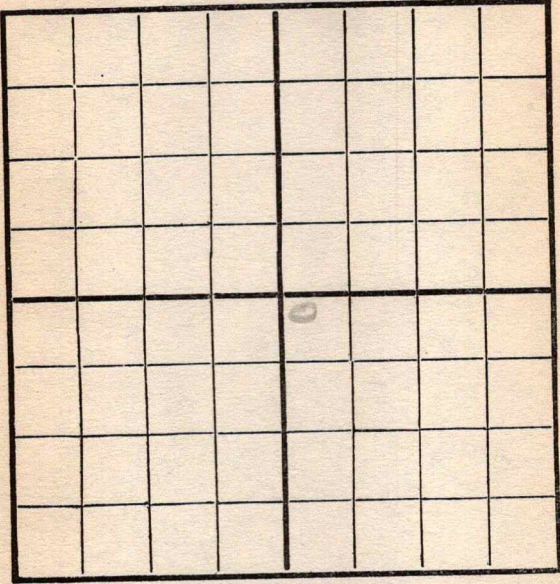

EAST

SOUTH

Location _____
 Rig Up _____
 Drilling and remarks _____

RECORD

Cased _____ in. _____ Ft.
 Sand _____
 Gas _____
 Oil _____
 Total Depth _____

PRODUCTION

1st 24 hrs. Nat. _____
 1st 24 hrs. after shot _____
 Gas _____ Cu. Ft.
 Dry Hole _____
 Abandoned _____

Date

3/26 1917 Craig Scout

Map No. _____ Sec. 6 Twp. 26 R. 5Well No. 10 Bernhill Farm
Empire Company

NORTH

WEST

EAST

SOUTH

Location _____

Rig Up ☒ _____

Drilling and remarks _____

RECORD

Cased _____ in. _____ Ft.

Sand _____

Gas _____

Oil _____

Total Depth _____

PRODUCTION

1st 24 hrs. Nat. _____

1st 24 hrs. after shot _____

Gas _____ Cu. Ft.

Dry Hole _____

Abandoned _____


Date

4/5, 1917 Parley Scout

Map No. _____ Sec. 6 Twp. 26 R. 5
Well No. 10 Bonville Farm _____
Empire Company _____

NORTH

WEST

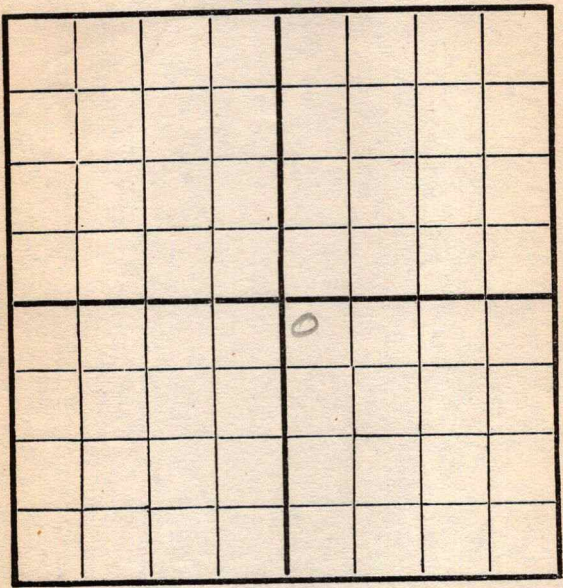

EAST

SOUTH

Location _____
Rig Up _____
Drilling and remarks _____

RECORD

Cased _____ in. _____ Ft.
Sand _____
Gas _____
Oil _____
Total Depth _____


PRODUCTION

1st 24 hrs. Nat. _____
1st 24 hrs. after shot _____
Gas _____ Cu. Ft.
Dry Hole _____
Abandoned _____

Date 4/11, 1917 C. A. J. Scout

Map No. _____ Sec. 6 Twp. 26 R. 5
 Well No. 10 Barnhill Farm
Cummins Company

NORTH

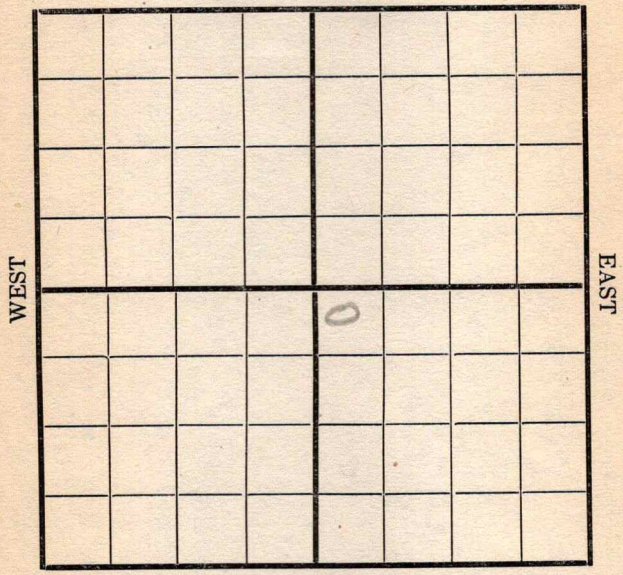

SOUTH

Location _____
 Rig Up ☒
 Drilling and remarks _____

RECORD


Cased _____ in. _____ Ft.
 Sand _____
 Gas _____
 Oil _____
 Total Depth _____

PRODUCTION

1st 24 hrs. Nat. _____
 1st 24 hrs. after shot _____
 Gas _____ Cu. Ft.
 Dry Hole _____
 Abandoned _____

Date 4/19, 1912 J. Candy Scout

Map No. _____ Sec. 6 Twp. 26 R 5
Well No. 10 Bannock Farm
Cumprine Company
NORTH

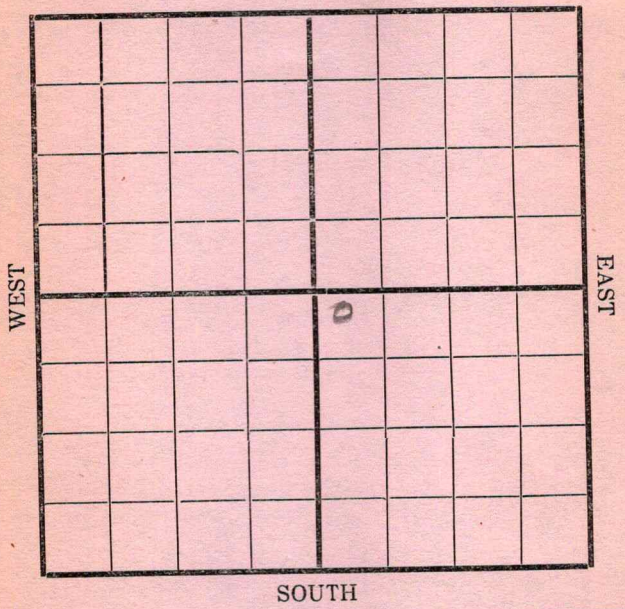


	RECORD
Location _____	Cased _____ in. _____ Ft.
Rig Up ☒ _____	Sand _____
Drilling and remarks _____	Gas _____
	Oil _____
	Total Depth _____
	PRODUCTION
	1st 24 hrs. Nat. _____
	1st 24 hrs. after shot _____
	Gas _____ Cu. Ft.
	Dry Hole _____
	Abandoned _____

Date APR 26 1917, 191____ Scout Randall

Map No. _____ Sec. 6 Twp. 26 R. 5Well No. 10 Barnhill Farm __________Emp. Company _____

NORTH

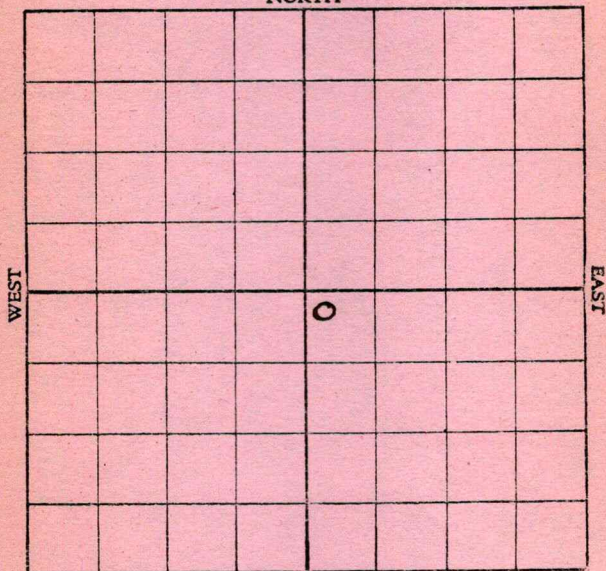

SOUTH

Location _____

Rig up _____

Drilling and remarks:

*Timbers on
Ground*

RECORD

Cased _____ in. _____ Ft.

Sand _____

Gas _____

Oil _____

Total Depth _____

PRODUCTION

1st 24 hrs. Nat. _____

1st 24 hrs. after shot _____

Gas _____ Cu. Ft.


Dry Hole _____

Abandoned _____

Date

5/3, 1917, Crocker Scout

Map No. _____ Sec. 6 Twp. 26 R. 5
 Well No. 10 Barnhill Farm _____
Emp. Company _____
 NORTH

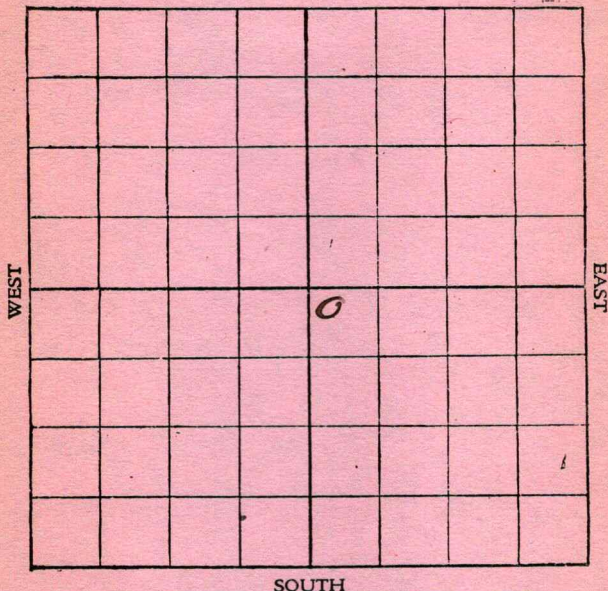

Location _____

Rig up _____

Drilling and remarks:

*Timbers
on Ground*

RECORD

Cased _____ in. _____ Ft.

Sand _____

Gas _____

Oil _____

Total Depth _____

PRODUCTION

1st 24 hrs. Nat. _____

1st 24 hrs. after shot _____

Gas _____ Cu. Ft.


Dry Hole _____

Abandoned _____

Date

5/12, 1917, Crocker Scout

Map No. _____ Sec. 6 Twp. 26 R. 5
 Well No. 10 Barnhill Farm _____
Emp. Company _____
 NORTH

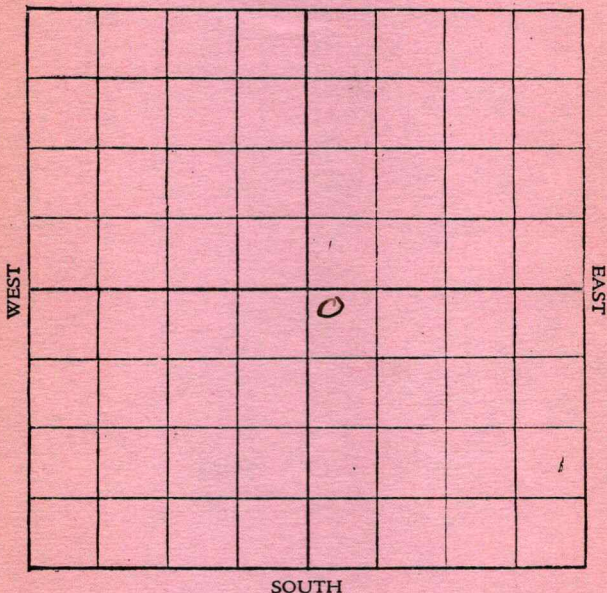

Location _____

Rig up _____

Drilling and remarks:

Timber on
Ground

RECORD

Cased _____ in. _____ Ft.

Sand _____

Gas _____

Oil _____

Total Depth _____

PRODUCTION

1st 24 hrs. Nat. _____

1st 24 hrs. after shot _____

Gas _____ Cu. Ft.

Dry Hole _____

Abandoned _____

Date

5/19/17, Crocker Scout

Map No. _____ Sec. 6 Twp. 26 R. 5
 Well No. 10 Barnhill Farm _____
 _____ Emp. Company

NORTH

WEST

EAST

SOUTH

Location _____

Rig up _____

Drilling and remarks:

RECORD

Cased _____ in. _____ Ft.

Sand _____

Gas _____

Oil _____

Total Depth _____

PRODUCTION

1st 24 hrs. Nat. _____

1st 24 hrs. after shot _____

Gas _____ Cu. Ft.

Dry Hole _____


Abandoned _____

Date

7/26/17, 1917, Brocker Scout

Map No. _____ Sec. 6. Twp. 26 R. 5
Well No. 10 Burnhill Farm _____
Emp Company _____

NORTH

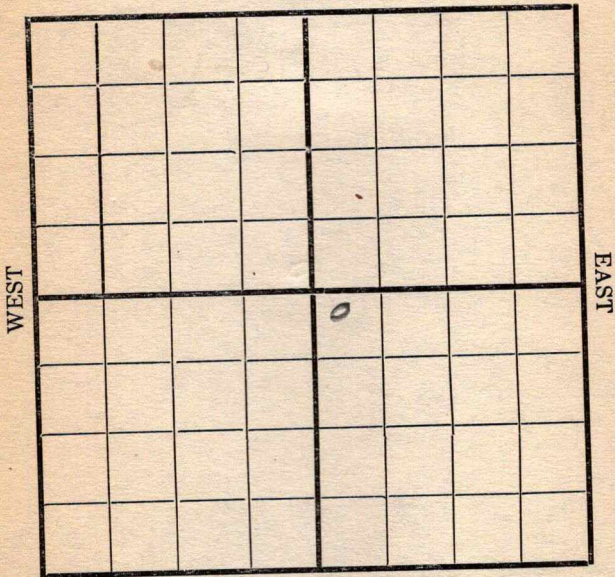

SOUTH

Location _____
Rig Up _____
Drilling and remarks

Rig.

RECORD

Cased _____ in. _____ Ft.
Sand _____
Gas _____
Oil _____
Total Depth _____

PRODUCTION

1st 24 hrs. Nat. _____
1st 24 hrs. after shot _____
Gas _____ Cu. Ft.
Dry Hole _____
Abandoned _____

Date


8/2, 1917 Crocker Scout

Map No. _____ Sec. 6 Twp. 26 R. 5

Well No. 10 Barnhill Farm _____

Emp. Company _____

NORTH

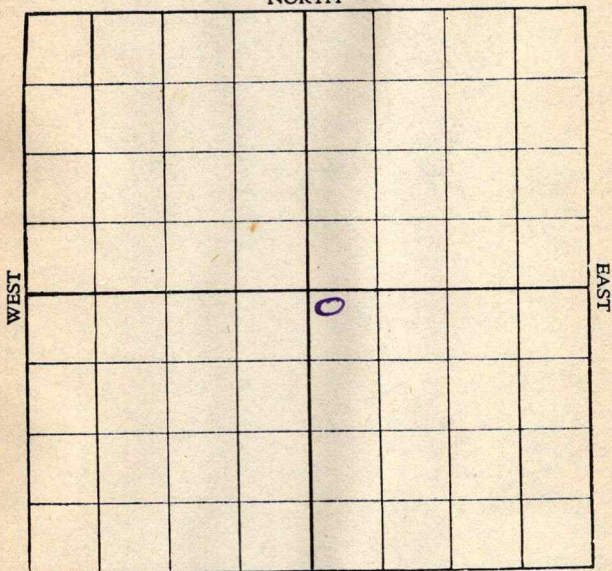

SOUTH

Location _____

Rig up _____

Drilling and remarks:

Rig.

RECORD

Cased _____ in. _____ Ft.

Sand _____

Gas _____

Oil _____

Total Depth _____

PRODUCTION

1st 24 hrs. Nat. _____

1st 24 hrs. after shot _____

Gas _____ Cu. Ft.

Dry Hole _____


Abandoned _____

Date

JUN 9 1917, 1917, C. J. Crocker. Scout

Map No. _____ Sec. 6 Twp. 26 R. 5
 Well No. 10 Barnhill Farm
Emp Company

NORTH

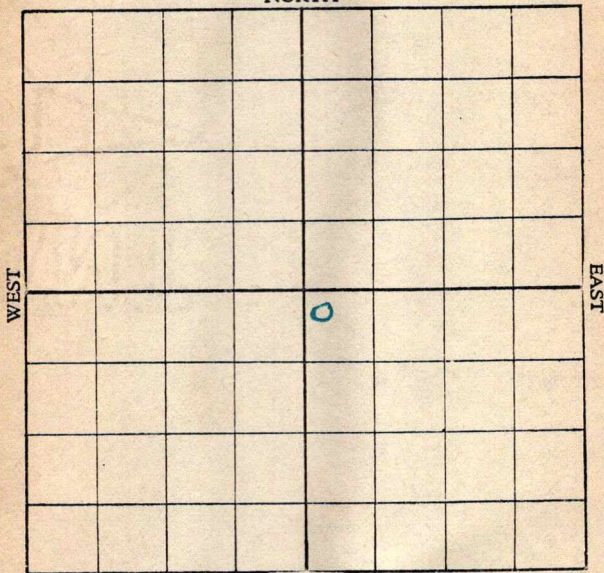

SOUTH

Location _____

Rig up _____

Drilling and remarks:

Spud

RECORD

Cased _____ in. _____ Ft.

Sand _____

Gas _____

Oil _____

Total Depth _____

PRODUCTION

1st 24 hrs. Nat. _____

1st 24 hrs. after shot _____

Gas _____ Cu. Ft.

Dry Hole _____

Abandoned _____

Date


JUN 16 1917

, 191

C. J. Crocker Scout

Map No. _____ Sec. 6 Twp. 26 R. 5
Well No. 10 Barnhill Farm
Empire Company

NORTH

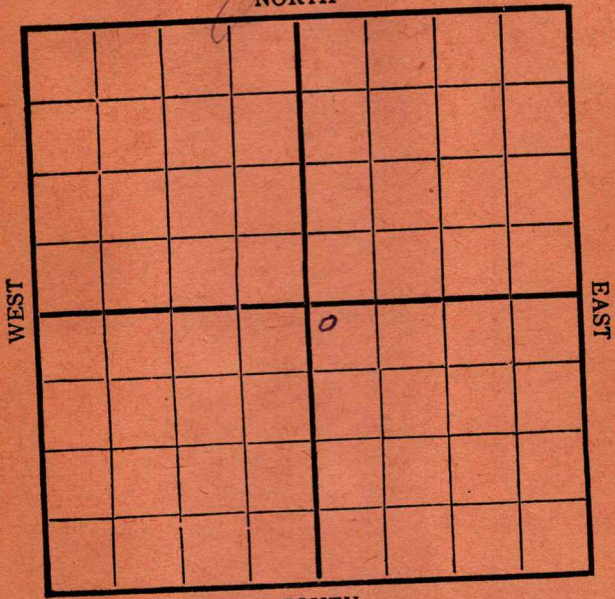

SOUTH

Location _____
Rig Up _____
Drilling and remarks _____

Fish 420'

RECORD

Cased _____ in. _____ Ft.
Sand _____
Gas _____
Oil _____
Total Depth _____

PRODUCTION

1st 24 hrs. Nat. _____
First 24 hrs. after shot _____
Gas _____ Cu. Ft.
Dry Hole _____
Abandoned _____

Date


JUN 22 1917

G. J. Crocker

Scout

Map No. _____ Sec. 6 Twp. 26 R. 3Well No. 10 Burnhill Farm __________Emp._____
Company

NORTH

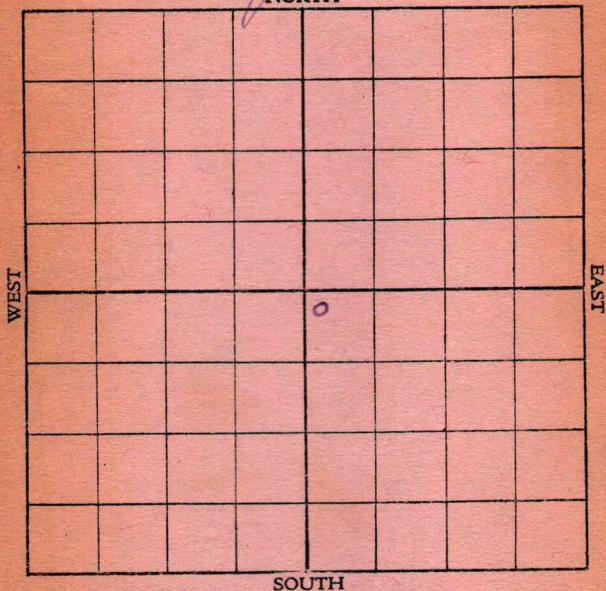

SOUTH

Location _____

Rig up _____

Drilling and remarks:

Set 10"
1000'

RECORD

Cased _____ in. _____ Ft.

Sand _____

Gas _____

Oil _____

Total Depth _____

PRODUCTION

1st 24 hrs. Nat. _____

1st 24 hrs. after shot _____

Gas _____ Cu. Ft.

Dry Hole _____

Abandoned _____

Date JUN 3 0 1917

_____, 191

E. J. Crocker Scout

Map No. _____ Sec. 6 Twp. 26 R. 5
 Well No. 10 Barnhill Farm _____
 _____ Emp Company

NORTH

				0			

SOUTH

Location _____

Rig up _____

Drilling and remarks:

D-1600'

RECORD

Cased _____ in. _____ Ft.

Sand _____

Gas _____

Oil _____

Total Depth _____

PRODUCTION

1st 24 hrs. Nat. _____

1st 24 hrs. after shot _____

Gas _____ Cu. Ft.

Dry Hole _____

Abandoned _____

Date

JUL 7 1917

191


C. T. Crocker Scout

Map No. _____ Sec. 6 Twp. 26 R. 5Well No. 10 Barnhill Farm __________Emp. Company _____

NORTH

WEST

EAST

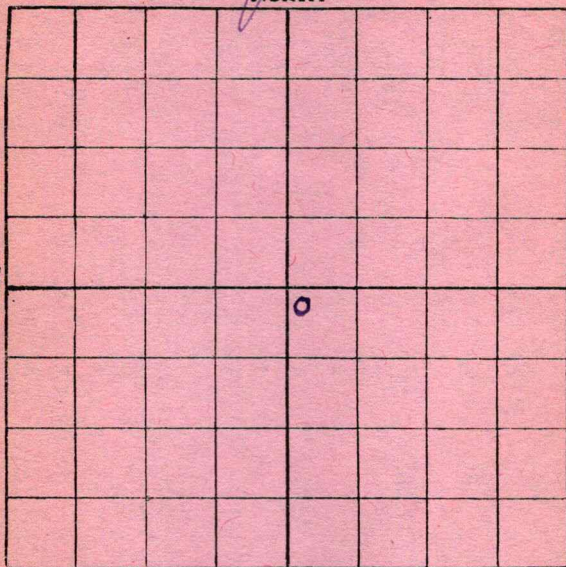

SOUTH

Location _____

Rig up _____

Drilling and remarks:

A-1985'

RECORD

Cased _____ in. _____ Ft.

Sand _____

Gas _____

Oil _____

Total Depth _____

PRODUCTION

1st 24 hrs. Nat. _____

1st 24 hrs. after shot _____

Gas _____ Cu. Ft.

Dry Hole _____

Abandoned _____


Date

JUL 14 1917, 191G. T. Crocker
Scout

Map No. _____ Sec. 6 Twp. 26 R. 5
 Well No. 60 Bonehill Farm _____
 _____ Company

NORTH

WEST

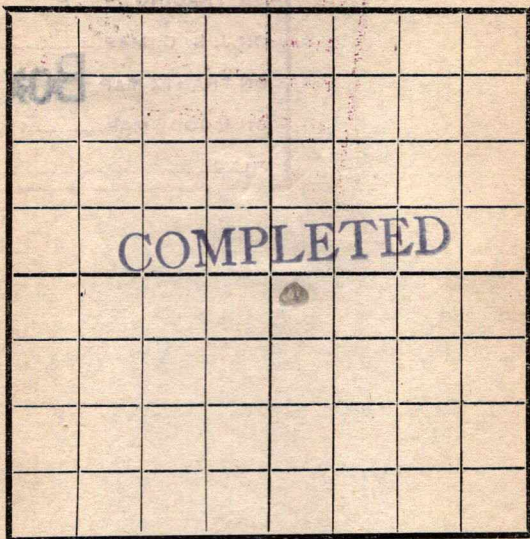

EAST

SOUTH


Location _____
 Rig Up _____
 Drilling and remarks

RECORD
 Cased _____ in. _____ Ft.
 Sand 2455 - 2487
 Gas _____
 Oil _____
 Total Depth _____

PRODUCTION
 1st 24 hrs. Nat. _____
 1st 24 hrs. after shot _____
 Gas _____ Cu. Ft.
 Dry Hole _____
 Abandoned _____

Date 8/17, 1917 Cumley Scout _____

2-55 Sec. 6, Twp 26 S, Range 5 E.

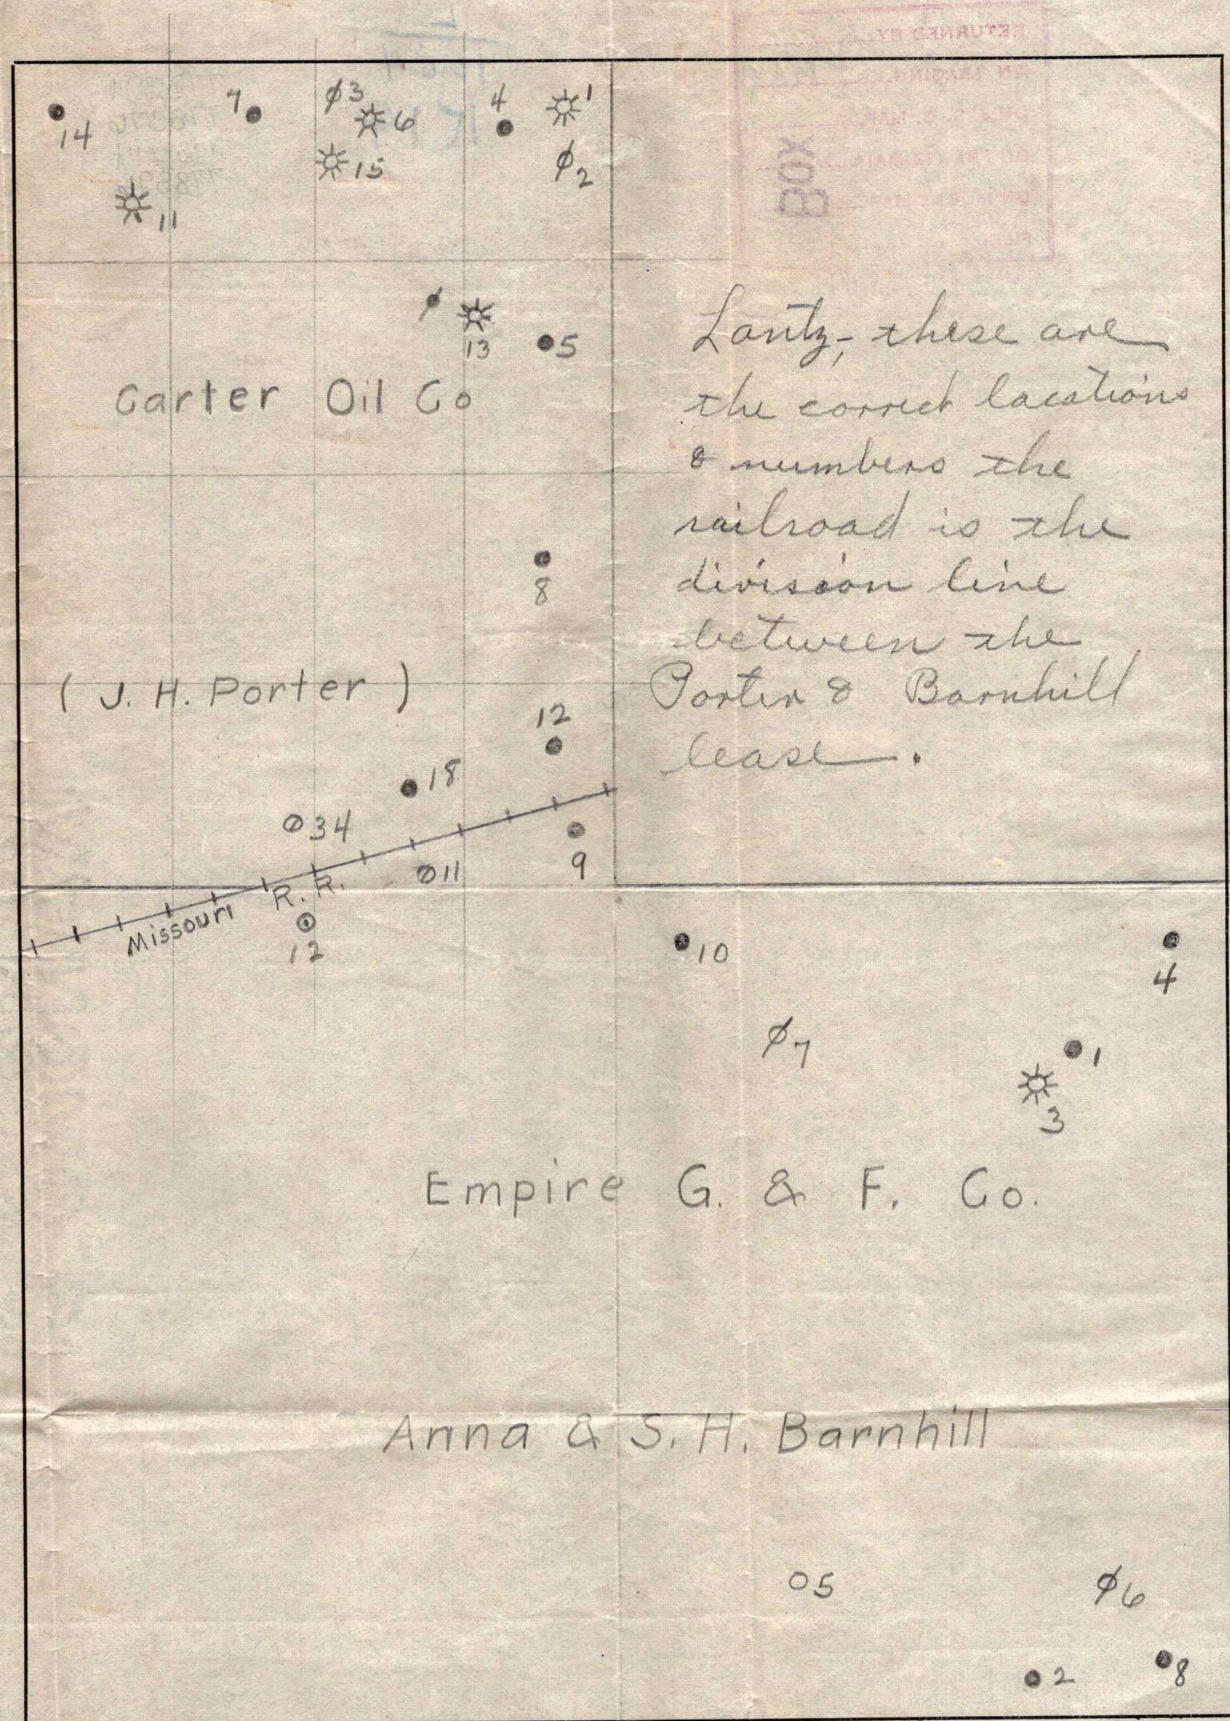

Lantz, these are the correct locations & numbers the railroad is the division line between the Porter & Barnhill lease.