


Map No. _____ Sec. 6 Twp. 26 R. 5
 Well No. 13 Banhill Farm
Empire Company

NORTH

WEST

EAST

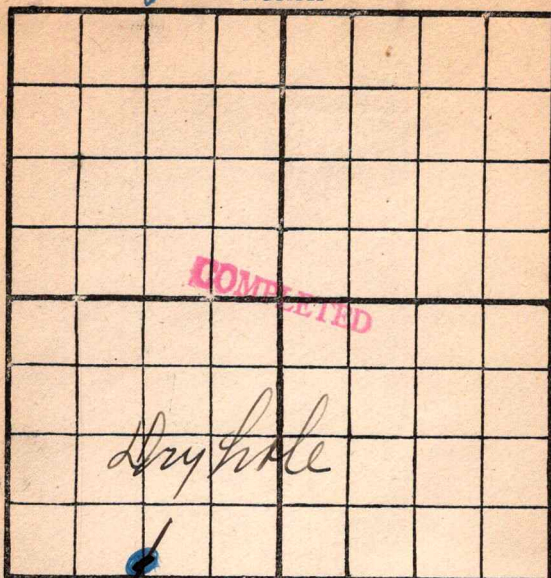

SOUTH

Location 200 S. - 1320 W.

Rig Up _____

Drilling Remarks:

Drilling Remarks:

RECORD

PRODUCTION

Cased _____ in. _____ ft.

1st 24 hrs. Nat. _____

Sand 2420' - 2465'

1st 24 hrs. after shot _____

Gas _____

Gas _____ cu. ft.

Oil _____

Dry Hole 2465


Total Depth _____

Abandoned _____

FORM 26-6-20-16-500 BOOKS OF 100 SECT.
1004 K 14
Map No. _____ Sec. 6 Twp. 26 R. 5
Well No. 13 Barnhill Farm
Empire Company

NORTH

WEST

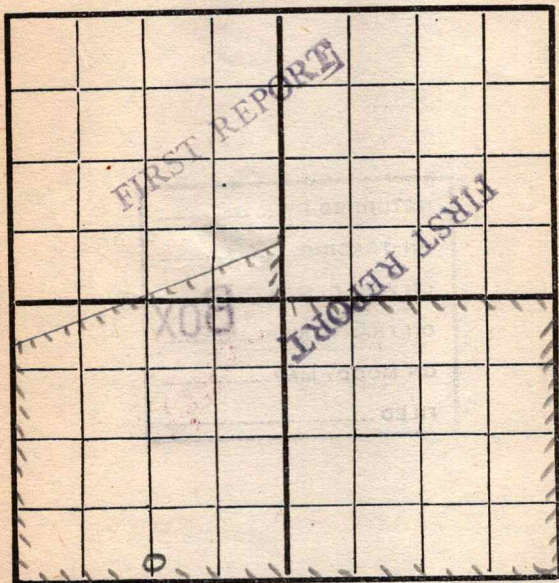

EAST

SOUTH

Location ☒

Rig Up

Drilling and remarks

RECORD

Cased _____ in. _____ Ft.

Sand _____

Gas _____

Oil _____

Total Depth _____

PRODUCTION

1st 24 hrs. Nat. _____

1st 24 hrs. after shot _____

Gas _____ Cu. Ft.

Dry Hole _____

Abandoned _____

Date

4/24, 1918


Scout

Map No. _____ Sec. 6 Twp. 26 R. 5
 Well No. 13 Barnhill Farm
Empire Company

NORTH

WEST

EAST

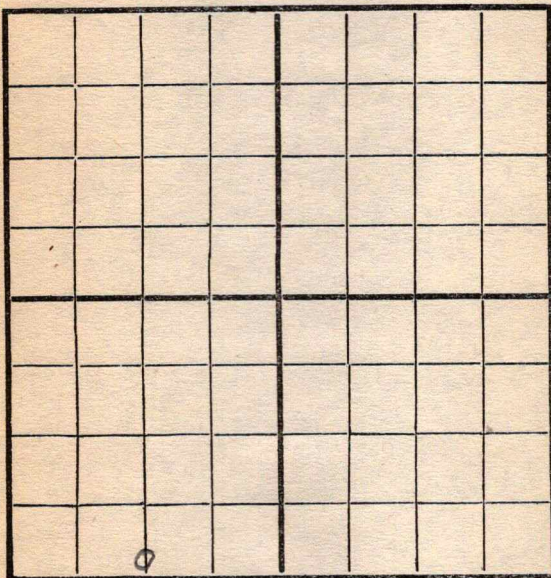

SOUTH

Location ✓
 Rig Up _____
 Drilling and remarks _____

RECORD

Cased _____ in. _____ Ft.
 Sand _____
 Gas _____
 Oil _____
 Total Depth _____

PRODUCTION

1st 24 hrs. Nat. _____
 1st 24 hrs. after shot _____
 Gas _____ Cu. Ft.
 Dry Hole _____
 Abandoned _____


Date 5/2, 1918 G. L. ... Scout

Map No. _____ Sec. 6 Twp. 26 R. 5
 Well No. 13 Barnhill Farm
Empire Company

NORTH

WEST

EAST

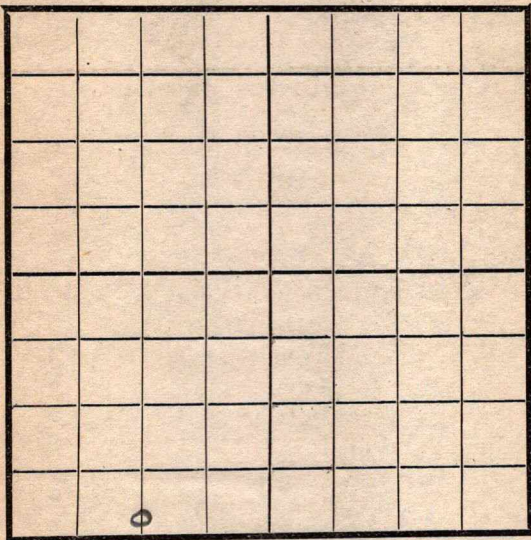

SOUTH

RECORD

Location _____
 Rig Up _____
 Drilling and remarks _____

Cased _____ in. _____ Ft.
 Sand _____
 Gas _____
 Oil _____
 Total Depth _____

PRODUCTION

1st 24 hrs. Nat. _____
 1st 24 hrs. after shot _____
 Gas _____ Cu. Ft.
 Dry Hole _____
 Abandoned _____

Spudding

Date


5/8, 1918 J. L. Tyke Scout

Map No. _____ Sec. 6 Twp. 26 R. 5
 Well No. 13 Barnhill
Empire Company
 Contractor _____

NORTH

WEST

EAST

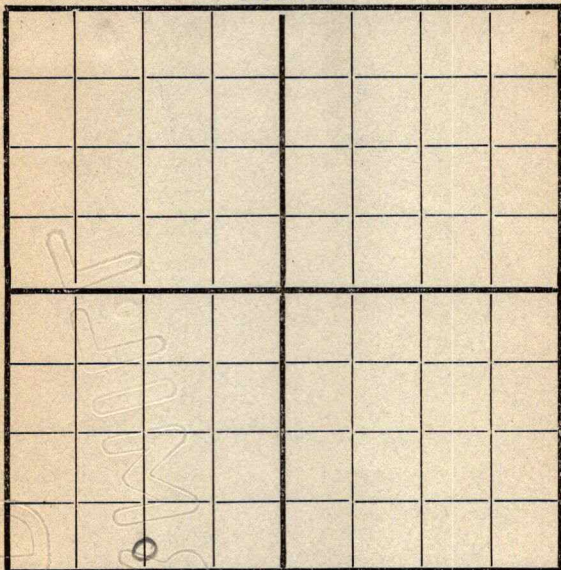

SOUTH

Location _____

Rig up _____

Drilling and Remarks:

600'

RECORD

Cased _____ in., _____ ft.

Sand _____

Gas _____

Oil _____

Total Depth _____

PRODUCTION

1st 24 hrs. Nat. _____

1st 24 hrs. after shot _____

Gas _____ Cu. Ft.

Dry Hole _____

Abandoned _____

Date

5/15 1918Oyle Scout

Map No. _____ Sec. 6 Twp. 26 R. 5
 Well No. 13 Farmhill
Empire Company
 Contractor

NORTH

WEST

EAST

SOUTH

Location _____

Rig up _____

Drilling and Remarks:

*fishing @**1390*

RECORD

Cased _____ in., _____ ft.

Sand _____

Gas _____

Oil _____

Total Depth _____

PRODUCTION

1st 24 hrs. Nat. _____

1st 24 hrs. after shot _____

Gas _____ Cu. Ft.


Dry Hole _____

Abandoned _____

Date

5/12 191 *8* *Clyde* Scout

Map No. _____ Sec. 6 Twp. 26 R. 5
 Well No. 13 Barnhill
Empire Company
 Contractor _____

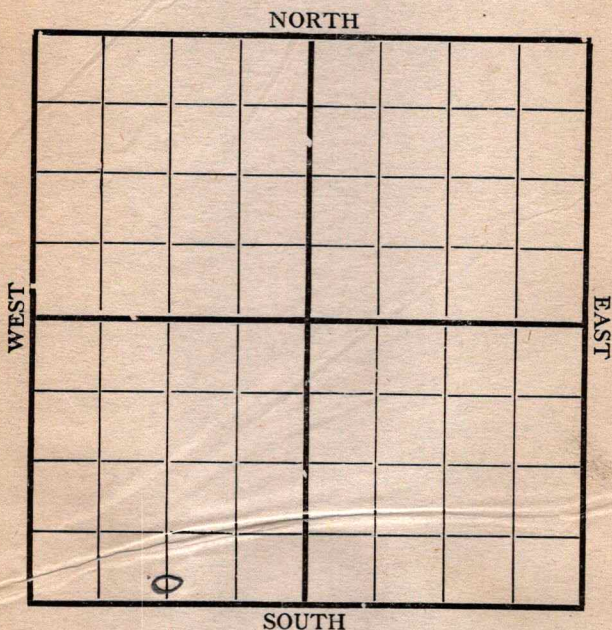

Location _____

Rig up _____

Drilling and Remarks:

fishing @
1390'

RECORD

Cased _____ in., _____ ft.

Sand _____

Gas _____

Oil _____

Total Depth _____

PRODUCTION

1st 24 hrs. Nat. _____

1st 24 hrs. after shot _____

Gas _____ Cu. Ft.

Dry Hole _____

Abandoned _____

Date

5/29 1918 Oya Scout

Map No. _____ Sec. 6 Twp. 26 R. 5
 Well No. 13 Barnhill
Empire _____ Company
 _____ Contractor

NORTH

WEST

EAST

SOUTH

Location _____

Rig up _____

Drilling and Remarks:

fishing
1390'

RECORD

Cased _____ in., _____ ft.

Sand _____

Gas _____

Oil _____

Total Depth _____

PRODUCTION

1st 24 hrs. Nat. _____

1st 24 hrs. after shot _____

Gas _____ Cu. Ft.

Dry Hole _____

Abandoned _____

Date


6/5 1918 Gyle Scout

Map No. _____ Sec. 6 Twp. 26 R. 5
 Well No. 13 Barnhill
Empire _____ Company
 _____ Contractor

NORTH

WEST

EAST

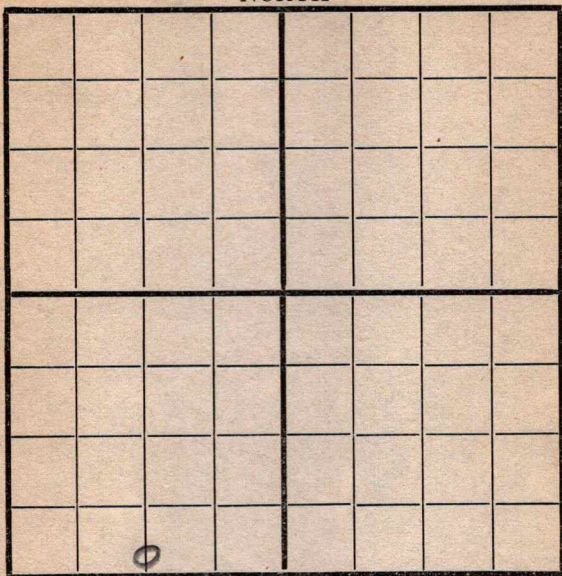

SOUTH

Location _____

Rig up _____

Drilling and Remarks:

1965'

RECORD

Cased _____ in., _____ ft.

Sand _____

Gas _____

Oil _____

Total Depth _____

PRODUCTION

1st 24 hrs. Nat. _____

1st 24 hrs. after shot _____

Gas _____ Cu. Ft.

Dry Hole _____

Abandoned _____

Date

6/12

191

8


Dry le

Scout

Map No. _____ Sec. 6 Twp. 26 R. 5
 Well No. 13 Barnhill
Empire Company
 Contractor _____

NORTH

WEST

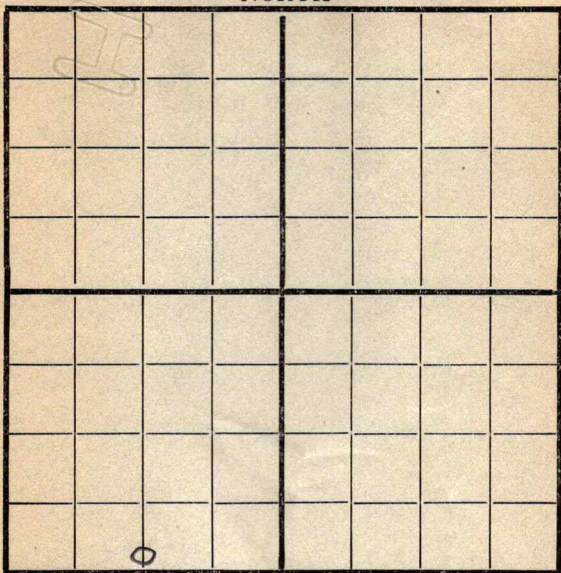

EAST

SOUTH

Location _____

Rig up _____

Drilling and Remarks:

*Fishing for
tools @
2085'*

RECORD

Cased _____ in., _____ ft.

Sand _____

Gas _____

Oil _____

Total Depth _____

PRODUCTION

1st 24 hrs. Nat. _____

1st 24 hrs. after shot _____

Gas _____ Cu. Ft.

Dry Hole _____

Abandoned _____


Date

6/19 1918 Gyle Scout

Map No. _____ Sec. 6 Twp. 26 R. 5
 Well No. 13 Barnhill
Empire Company
 Contractor _____

NORTH

WEST

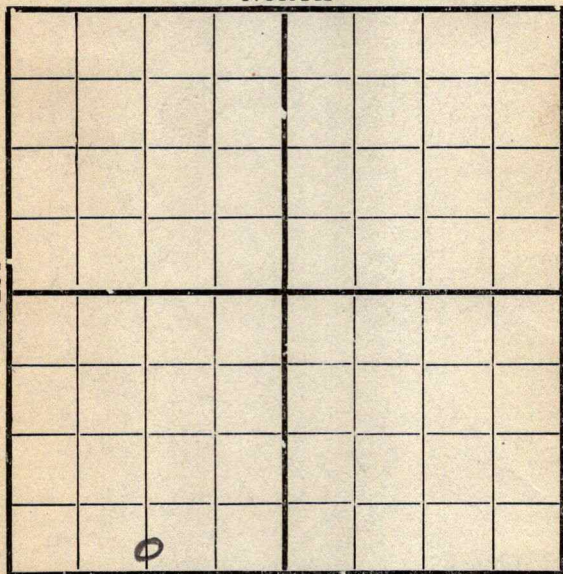

EAST

SOUTH

Location _____

Rig up _____

Drilling and Remarks:

*Fishing for
tools @
2085'*

RECORD

Cased _____ in., _____ ft.

Sand _____

Gas _____

Oil _____

Total Depth _____

PRODUCTION

1st 24 hrs. Nat. _____

1st 24 hrs. after shot _____

Gas _____ Cu. Ft.

Dry Hole _____


Abandoned _____

Date

6/26 1918

Gyle Scout

Map No. _____ Sec. 6 Twp. 26 R. 5
Well No. 13 Barnhill Farm _____
Empire Company _____
Date Started _____ Ft. from N. S. E. W. line
NORTH

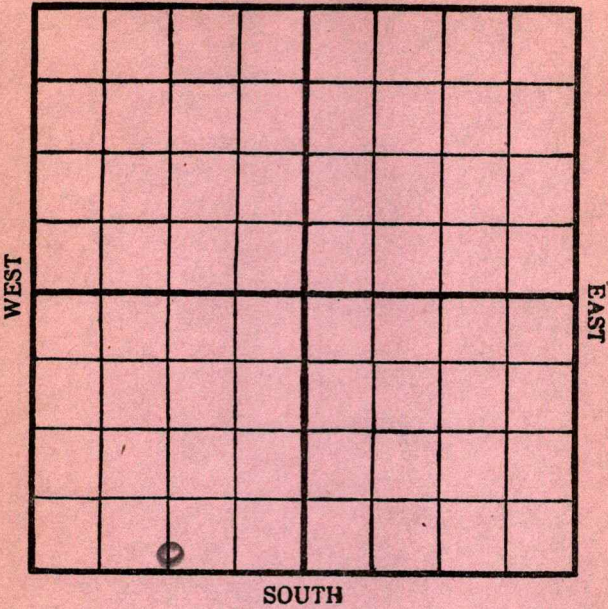

Cased _____ In. _____ Ft. _____	Production Remarks
Sand _____	
Pay { Gas _____ Oil _____	
Total Depth _____	

Condition of Well on this date _____

fishing for tools
2085

7/3 *Py h* Scout


Map No. _____ Sec. 6 Twp. 26 R. 5Well No. 13 BarnhillEmpire Company

Contractor _____

NORTH

WEST

EAST

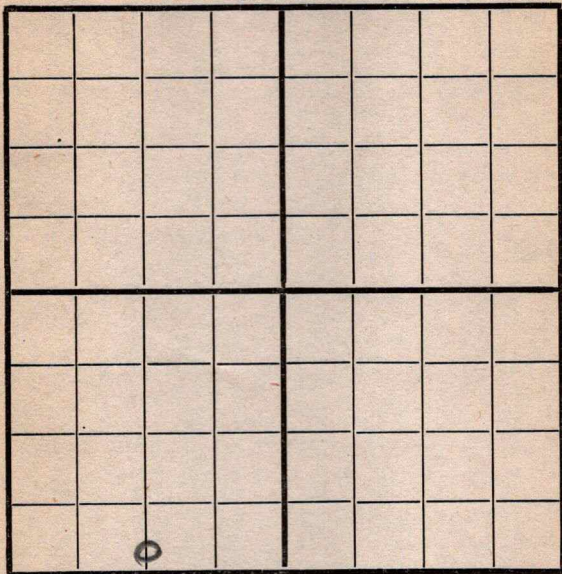

SOUTH

RECORD

Location _____

Cased _____ in., _____ ft.

Rig up _____

Sand _____

Drilling and Remarks:

Gas _____

Oil _____

Total Depth _____

PRODUCTION

1st 24 hrs. Nat. _____

1st 24 hrs. after shot _____

Gas _____ Cu. Ft.

Dry Hole _____

Abandoned _____

Date

7/10191 8Cycle

Scout


Map No. _____ Sec. 6 Twp. 26 R. 5Well No. 13 Barnhill

_____ Company

_____ Contractor

NORTH

WEST

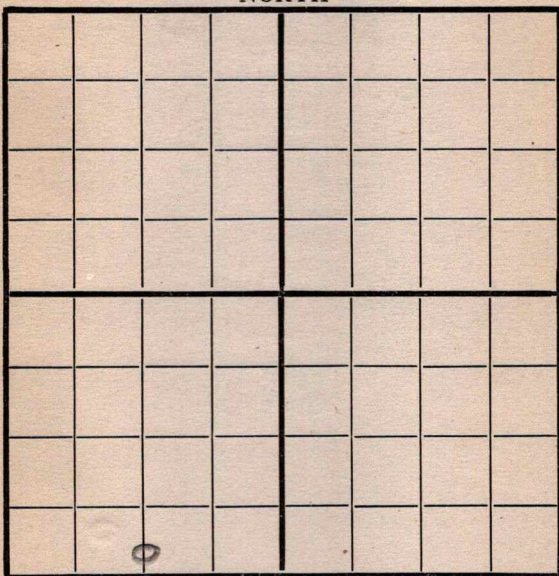

EAST

SOUTH

Location _____

Rig up _____

Drilling and Remarks:

*fishing for
tools @
2085*

RECORD

Cased _____ in., _____ ft.

Sand _____

Gas _____

Oil _____

Total Depth _____

PRODUCTION

1st 24 hrs. Nat. _____

1st 24 hrs. after shot _____

Gas _____ Cu. Ft.

Dry Hole _____

Abandoned _____

Date

7/17 191 *8*

Cyle Scout

Map No. _____ Sec. 6 Twp. 26 R. 5Well No. 13 Barnhill_____Empire Company_____ Contractor

NORTH

WEST

EAST

SOUTH

Location _____

Rig up _____

Drilling and Remarks:

*fishing tools**2085'*

RECORD

Cased _____ in., _____ ft.

Sand _____

Gas _____

Oil _____

Total Depth _____

PRODUCTION

1st 24 hrs. Nat. _____

1st 24 hrs. after shot _____

Gas _____ Cu. Ft.


Dry Hole _____

Abandoned _____

Date

*7/24*1918*Gyle* Scout

Map No. _____ Sec. 6 Twp. 26 R. 5
Well No. 13 Barnhill
Empire _____ Company
_____ Contractor

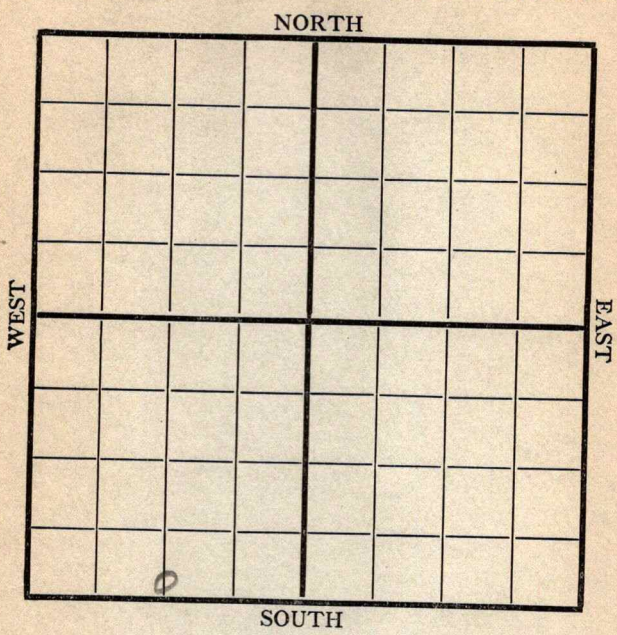

Location 200' A

Rig up 1320 E

Drilling and Remarks:

*fishing
tools @
2085'*

RECORD

Cased _____ in., _____ ft.
Sand _____
Gas _____
Oil _____
Total Depth _____

PRODUCTION

1st 24 hrs. Nat. _____
1st 24 hrs. after shot _____
Gas _____ Cu. Ft.
Dry Hole _____
Abandoned _____


Date 7/31 1918 Oyle Scout

Map No. _____ Sec. 6 Twp. 26 R. 5
 Well No. 13 Barnhill
Empire Company
 Contractor _____

NORTH

WEST

EAST

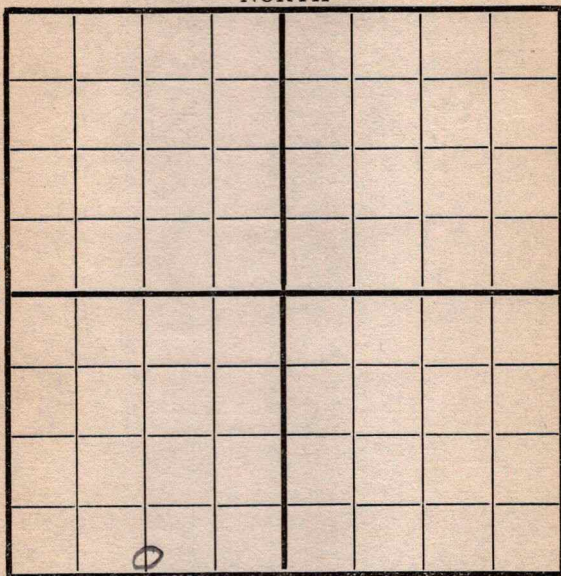

SOUTH

Location 1320 E

Rig up _____

Drilling and Remarks:

fishing
tools @
2085

RECORD

Cased _____ in., _____ ft.

Sand _____

Gas _____

Oil _____

Total Depth _____

PRODUCTION

1st 24 hrs. Nat. _____

1st 24 hrs. after shot _____

Gas _____ Cu. Ft.

Dry Hole _____

Abandoned _____

Date


8/7 1918 Cyle Scout

Map No. _____ Sec. 6 Twp. 26 R. 5
 Well No. 13 Barnhill
Empire Company
 Contractor _____

NORTH

WEST

EAST

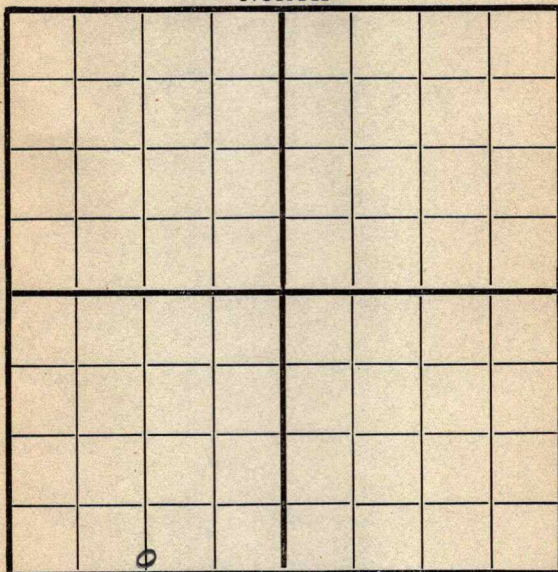

SOUTH

Location 1320 E

Rig up _____

Drilling and Remarks:

fishing
Tools
2085'

RECORD

Cased _____ in., _____ ft.

Sand _____

Gas _____

Oil _____

Total Depth _____

PRODUCTION

1st 24 hrs. Nat. _____

1st 24 hrs. after shot _____

Gas _____ Cu. Ft.

Dry Hole _____

Abandoned _____

Date


8/13 1918 Pyke Scout

Map No. _____ Sec. 6 Twp. 26 R. 5Well No. 13 Brownhill_____Empire_____
Company_____
Contractor

NORTH

WEST

EAST

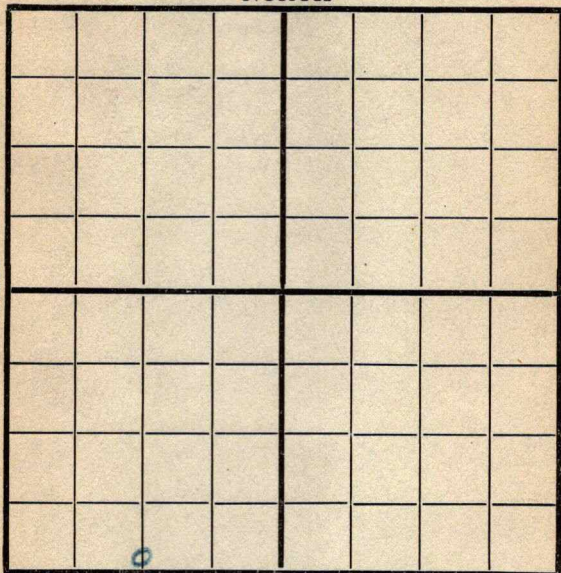

SOUTH

200' 8-1370' 2

Location _____

Rig up _____

Drilling and Remarks:

fishing
tools 2085'

RECORD

Cased _____ in., _____ f

Sand _____

Gas _____

Oil _____

Total Depth _____

PRODUCTION

1st 24 hrs. Nat. _____

1st 24 hrs. after shot _____

Gas _____ Cu. Ft.

Dry Hole _____

Abandoned _____

Date

8
21

1918

Pyle

Scout

Map No. K 14 Sec. 6 Twp. 26^S R. 5^EWell No. 13 BarnhillEmpire Company

Contractor

NORTH

WEST

EAST

SOUTH

Location 200N1320E

Rig up

Drilling and Remarks:

fishing
tools @
2085'

RECORD

Cased _____ in., _____ ft.

Sand _____

Gas _____

Oil _____

Total Depth _____

PRODUCTION

1st 24 hrs. Nat. _____

1st 24 hrs. after shot _____

Gas _____ Cu. Ft.

Dry Hole _____

Abandoned _____

Date

8/28

191

8

Pyle

Scout

Map No. K14 Sec. 6 Twp. 26^S R. 5^E
 Well No. 13 Barnhill
Empire Company
 Contractor

NORTH

WEST

EAST

SOUTH

Location _____

Rig up _____

Drilling and Remarks:

200 from R
 1320 " th.
 fishing tool
 @ 2055'

RECORD

Cased _____ in., _____ ft.

Sand _____

Gas _____

Oil _____

Total Depth _____

PRODUCTION

1st 24 hrs. Nat. _____

1st 24 hrs. after shot _____

Gas _____ Cu. Ft.

Dry Hole _____

Abandoned _____

Date

9/5 1918

Pyle

Scout

Map No. K14 Sec. 6 Twp. 26^S R. 5^EWell No. 13 BarnhillEmpire Company

Contractor

NORTH

WEST

EAST

SOUTH

Location

200 ft. 1320 W. 24th

Rig up

Drilling and Remarks:

2125'

RECORD

Cased _____ in., _____ ft.

Sand _____

Gas _____

Oil _____

Total Depth _____

PRODUCTION

1st 24 hrs. Nat. _____

1st 24 hrs. after shot _____

Gas _____ Cu. Ft.

Dry Hole _____

Abandoned _____

Date

9/1918

Pyle

Scout

Map No. K14 Sec. 6 Twp. 26^S R. 5^EWell No. 13 BarnhillEmpire Company

Contractor

NORTH

WEST

EAST

SOUTH

Location 1320 WRig up 200-S

Drilling and Remarks:

J. D.
2420

RECORD

Cased _____ in., _____ ft.

Sand _____

Gas _____

Oil _____

Total Depth _____

PRODUCTION

1st 24 hrs. Nat. _____

1st 24 hrs. after shot _____

Gas _____ Cu. Ft.

Dry Hole _____

Abandoned _____

Date

9/18 1918 Pyle Scout

Map No. K14 Sec. 6 Twp. 26 R. 5Well No. 13 BarnhillEmpire Company

Contractor

NORTH

WEST

EAST

SOUTH

Location 200 - S1320 - W

Rig up

Drilling and Remarks:

T. A. 2420S.O. for
cement plug

RECORD

Cased _____ in., _____ ft.

Sand _____

Gas _____

Oil _____

Total Depth _____

PRODUCTION

1st 24 hrs. Nat. _____

1st 24 hrs. after shot _____

Gas _____ Cu. Ft.

Dry Hole _____

Abandoned _____

Date

9/26 1918Pyle

Scout

Map No. K14 Sec. 10 Twp. 26 R. 5
Well No. 13 Barnhill
Empire Company
Contractor

NORTH							
WEST							
SOUTH							
EAST							

Location 200-S
1320-W
Rig up
Drilling and Remarks:

D.D.
for casing

RECORD

Cased _____ in., _____ ft.
Sand 2420-2465
Gas _____
Oil _____
Total Depth _____

PRODUCTION

1st 24 hrs. Nat. _____
1st 24 hrs. after shot _____
Gas _____ Cu. Ft.
Dry Hole _____
Abandoned _____

Date

12/8 1918 Pyle Scout

Map No. K14 Sec. 6 Twp. 26 R. 5Well No. 13 BarnhillEmpire Company

Contractor

NORTH

WEST

EAST

SOUTH

Location 200-SRig up 1320-W

Drilling and Remarks:

*fishing
for 6 5/8
casing*

RECORD

Cased _____ in., _____ ft.

Sand 2420-2460

Gas _____

Oil _____

Total Depth _____

PRODUCTION

1st 24 hrs. Nat. _____

1st 24 hrs. after shot _____

Gas _____ Cu. Ft.

Dry Hole _____

Abandoned _____

Date

10/15 1918

Pyle

Scout

Map No. K14 Sec. 6 Twp. 26 R. 5
 Well No. 13 Barnhill
Empire Company
 Contractor

NORTH

WEST

EAST

SOUTH

Location 200-S
1320-W
 Rig up _____
 Drilling and Remarks:

*fishing for
casing*

RECORD

Cased _____ in., _____ ft.
 Sand 2420-2465
 Gas _____
 Oil _____
 Total Depth _____

PRODUCTION

1st 24 hrs. Nat. _____
 1st 24 hrs. after shot _____
 Gas _____ Cu. Ft.
 Dry Hole _____
 Abandoned _____

Date


Pyle

191

8

Scout

Map No. K14 Sec. 6 Twp. 26 R. 5
 Well No. 13 Barnhill
Empire Company
 Contractor

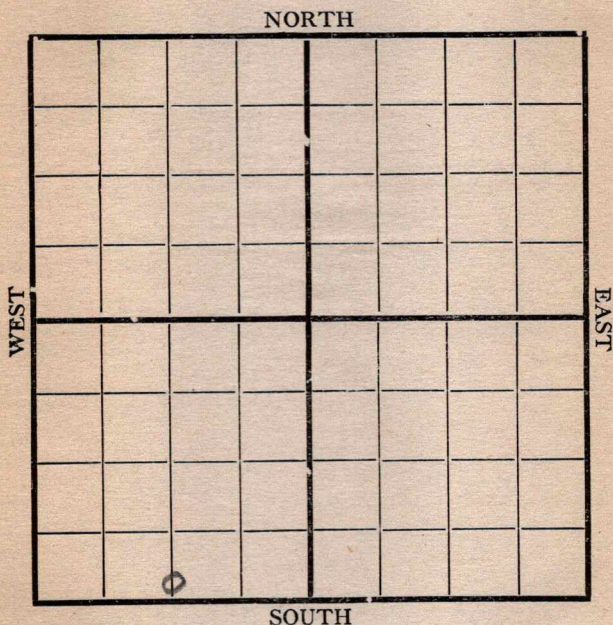

Location 200-S
1320-W

Rig up _____

Drilling and Remarks:

fishing for
6 5/8 casing
@ 2420

RECORD

Cased _____ in., _____ ft.

Sand 2420-2465

Gas _____

Oil _____

Total Depth _____

PRODUCTION

1st 24 hrs. Nat. _____

1st 24 hrs. after shot _____

Gas _____ Cu. Ft.

Dry Hole _____

Abandoned _____

Date

11/15 1918

Pyle

Scout

Map No. K14 Sec. 6 Twp. 26 R. 5
 Well No. 13 Barnhill
Empire Company
 Contractor

NORTH

WEST

EAST

SOUTH

500' 0" - 1320' 4"

Location _____

Rig up _____

Drilling and Remarks:

P. D. @2465'
joint 6 5/8 casing
in hole

RECORD

Cased _____ in., _____ ft.

Sand 2420-2465

Gas _____

Oil _____

Total Depth _____

PRODUCTION

1st 24 hrs. Nat. _____

1st 24 hrs. after shot _____

Gas _____ Cu. Ft.

Dry Hole _____

Abandoned _____

Date


11/20 1918Dyle Scout

Map No. K14 Sec. 6 Twp. 26 R. 5
 Well No. 13 Barnhill
Empire Company
 Contractor

NORTH

WEST

EAST

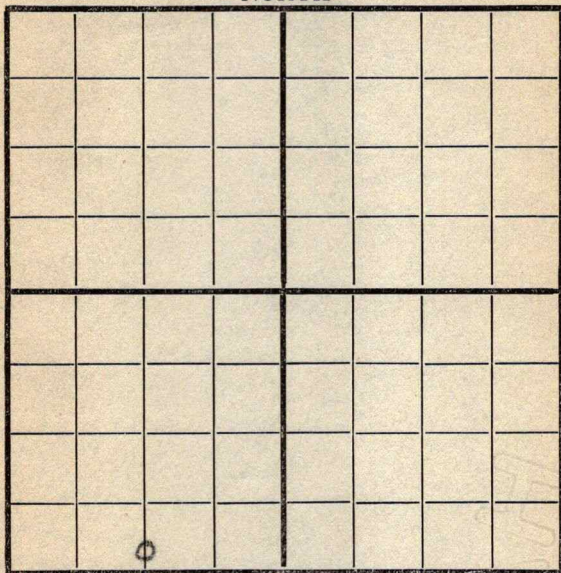

SOUTH

200-S

1320-W

Location _____

Rig up _____

Drilling and Remarks:

*finishing
casing @
2465*

RECORD

Cased _____ in., _____ ft.

Sand 1420-2465

Gas _____

Oil _____

Total Depth _____

PRODUCTION

1st 24 hrs. Nat. _____

1st 24 hrs. after shot _____

Gas _____ Cu. Ft.

Dry Hole _____

Abandoned _____

Date

12/4

1918


Scout

Map No. K14 Sec. 6 Twp. 26 R. 5
 Well No. 13 Barnhill
Empire Company
 Contractor

NORTH

WEST

EAST

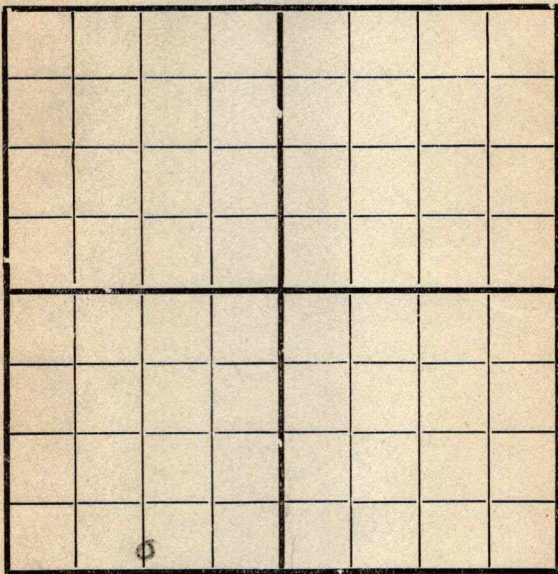

SOUTH

200-S

1320-W

Location _____

Rig up _____

Drilling and Remarks:

S. O.
 dropped 6"
 casing

RECORD

Cased _____ in., _____ ft.

Sand 2420-2465

Gas _____

Oil _____

Total Depth _____

PRODUCTION

1st 24 hrs. Nat. _____

1st 24 hrs. after shot _____

Gas _____ Cu. Ft.

Dry Hole _____

Abandoned _____

Date

12/11

8


H. B.

B.

Scout

Map No. K14 Sec. 6 Twp. 26 R. 5
 Well No. 13 Barnhill
Empire Company
 Contractor

NORTH

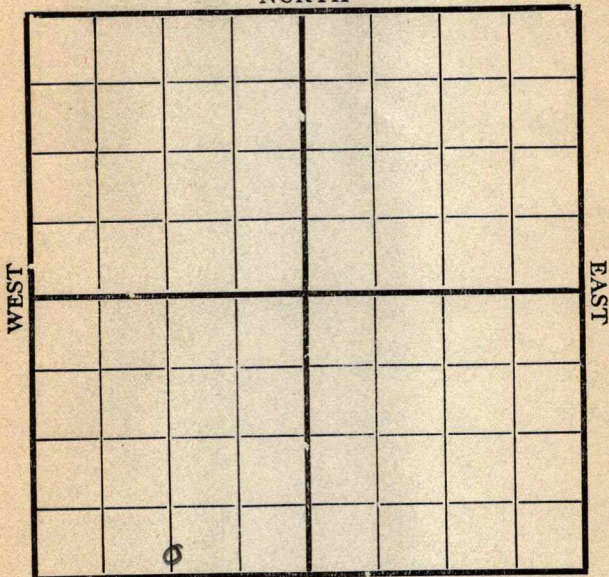

200-S

SOUTH

1320-W

Location _____

Rig up _____

Drilling and Remarks:

*S. 10 for
6" casing*

RECORD

Cased _____ in., _____ ft.

Sand 2420-2465

Gas _____

Oil _____

Total Depth _____

PRODUCTION

1st 24 hrs. Nat. _____

1st 24 hrs. after shot _____

Gas _____ Cu. Ft.

Dry Hole _____

Abandoned _____

Date

12/19 191 *8*

Pyle

Scout


Map No. K14 Sec. 6 Twp. 26 R. 5Well No. 13 BarnhillEmpire Company

Contractor

NORTH

WEST

EAST

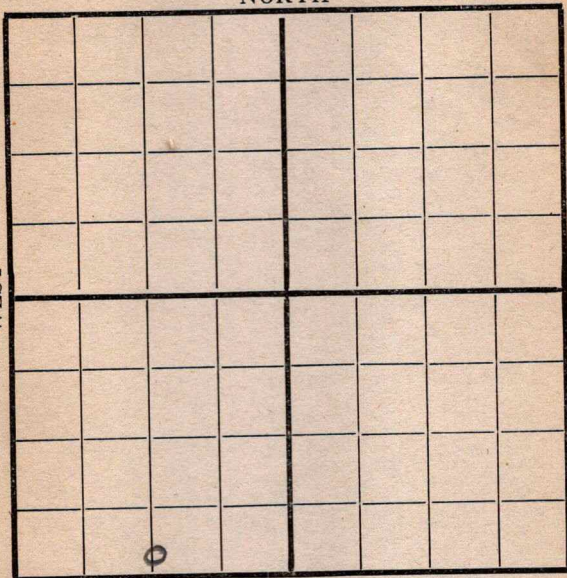

1320-W SOUTH

200-5

Location _____

Rig up _____

Drilling and Remarks:

D. 10 @

2465'

RECORD

Cased _____ in., _____ ft.

Sand _____

Gas _____

Oil _____

Total Depth _____

PRODUCTION

1st 24 hrs. Nat. _____

1st 24 hrs. after shot _____

Gas _____ Cu. Ft.

Dry Hole _____

Abandoned _____

Date

12/26

1918

Pyle

Scout

Map No. K 14 Sec. 6 Twp. 26 R. 5
 Well No. 13 Barnhill
Empire Company
 Contractor

NORTH

WEST

EAST

COMPLETED

SOUTH

200 S

1320 W

Location _____

Rig up _____

Drilling and Remarks:

RECORD

Cased _____ in., _____ ft.

Sand 2420-2465

Gas _____

Oil _____

Total Depth _____

PRODUCTION

1st 24 hrs. Nat. _____

1st 24 hrs. after shot _____

Gas _____ Cu. Ft.

Dry Hole 2465

Abandoned _____

Date

Jan 16 1919Gyle Scout